LATERAL 262 S.W.I.

SANITARY SEWER IMPROVEMENTS

LOT 1, EXCEPT THE NORTH 150 FEET THEREOF,
BLK. 5, FARMINGTON SQUARE 2ND ADDITION

CITY OF WICHITA, KANSAS

PROJECT NO.

468-76-2AU-81778-UUC-000-001

INDEX CODE 606657

INDEX OF SHEETS

Title Sheet 1

San. Sewer Plan & Profile 2

BENCH MARKS

Bench Mark: 'a' Cut ⌀ N.E. Corner of North Conc. Inlet. Approx. 30' South-easterly of S.E. Corner Lot 1, Blk. 5, Farmington Square 2nd Add.
Elev. = 1202.82 City Datum

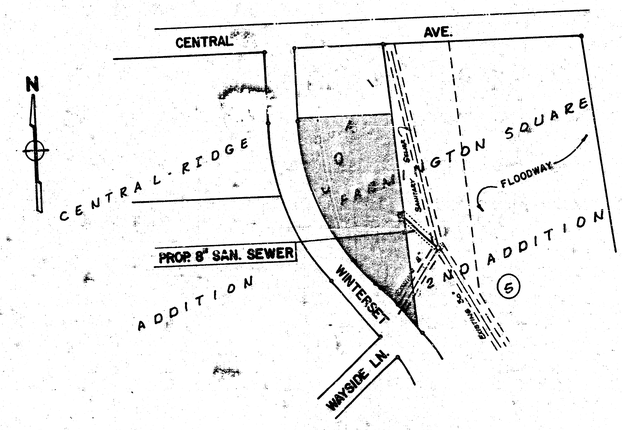

BENEFIT DISTRICT

GENERAL NOTES

1. Rubble from the removal of miccellaneous structures and excess excavation which is to be wasted shall be disposed of on sites to be provided by the Contractor. These sites shall be approved by the Engineer as to suitability, appearance and site location. Locations that, in the opinion of the Engineer, will leave an unsightly appearance will not be approved.

2. The Contractor shall be responsible for maintaining continuous flow of sewage through construction. Contractor's proposed method for maintaining sewage flow shall be approved by the Engineer. Cost of maintaining flow of sewage through construction will not be paid for directly and this cost shall be considered as subsidiary to the other pay items of work.

3. The Contractor shall be responsible for preserving property irons. The Contractor will be required to re-establish any property irons which are damaged or destroyed by his construction operations. Such irons shall be re-established by a licensed land surveyor or a licensed professional engineer in accordance with state law.

BUILT PER PLAN
RDL
12-89

N. BRENT WOOTEN LICENSED 8470 KANSAS PROFESSIONAL ENGINEER

BAUGHMAN COMPANY P. A.
SURVEYING & ENGINEERING
316/262-7271 • 315 ELLIS • WICHITA, KANSAS 67211

DESIGN	DRAWN	APPROVED	DATE	SCALE	REV.	SHEET	OF
N.B.Wooten	R.J.Plush		Dec. 1, 1987	1" = 160'		1	2

FILMED FROM THE BEST AVAILABLE COPY

Bench Mark: 'a' Cut @ N.E. Corner of North Conc. Inlet Approx. 30' South - Easterly of S.E. Corner Lot 1, Blk. 5, Farmington Square 1st Add. Elev. = 120.82 City Datum

Iron @ East Line of Winterset Lane

Existing 8" Sanitary Sewer

178'

226'

FARMINGTON SQUARE

2ND ADDITION

Utility Easement by Separate Instrument

20' Existing Sanitary

30'

BM 119.38

96.46'

67.6'

10.77'

150'

Station 1102.9 Construct Standard type MH, Top 120.5' 4"/4-4" Stubs NO, N.West, West, & S.West

The East Line of Lot 1 Blk 5 Farmington Square 2nd

5

Scale Plan 1"=20' Profile 1"=5'

N

WINTERSET LN.

Lot Split Line

CAUTION: Rubble Fill in this Area

Station 0+00 Existing Rim Conc. Manhole, Begin Const.

KG&E

Sanitary Sewer Easement

CAUTION: Overhead KG&E Power Lines

Section line 30.00' East of the West line of the NW 1/4 of Section 17-27-1E

Existing Ground

12" VCP @ 1.20%

Existing 10" VCP @ 0.20%

Proposed 8" PVC @ 17.77%

STATIONS 0+00 1102.9

125 120 115 110 105

PLAN: SURVEYED / PLOTTED / GRADES CHECKED / NOTE BOOK / No. / ALL NOTATIONS CHECKED / BY / DATE

PROFILE: SURVEYED / PLOTTED / GRADES CHECKED / NOTE BOOK / No. / ALL NOTATIONS CHECKED / BY / DATE

Title
LATERAL 268 S.W.T.
SANITARY SEWER IMPROVEMENTS
CITY OF WICHITA, KANSAS
PROJECT NO. 468-76-245-81778-000-000-001

BALLMAN COMPANY, P.A.
SURVEYING & ENGINEERING
316/262-7271 • 315 ELLIS • WICHITA, KANSAS 67211

Design:	Draw:	Approved:	Date:	Scale:	Sheet
N.E. Wooten	R.J. Plush	PW	Dec. 1, 1981	Noted	2 of 2

FILMED FROM THE BEST AVAILABLE COPY