CITY OF WICHITA, KANSAS

SANITARY SEWER EXTENSION

TO SERVE


LOTS 1 THROUGH 4 INCLUSIVE AND LOTS 9 THROUGH 12 INCLUSIVE

BLOCK D, WESTRIDGE VILLAGE ADDITION

LATERAL 280, SOUTHWEST INTERCEPTOR

PROJECT NO.: 468-76-245-81933-000-000-001

INDEX #: 607663

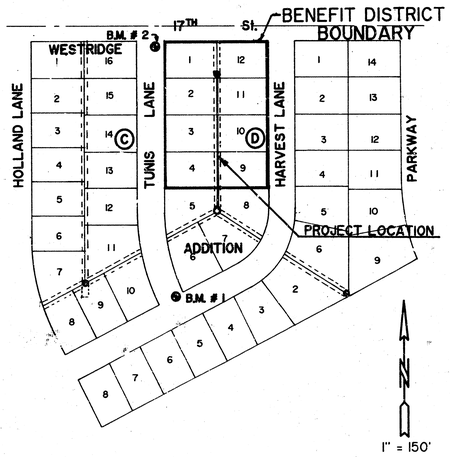

LOCATION MAP

INDEX :

SHEET 1 OF 2 TITLE
SHEET 2 OF 2 PLAN & PROFILE

GENERAL NOTES :

1. The Contractor shall be responsible for preserving property irons. The Contractor will be required to re-establish any property irons which are damaged or destoyed by his constuction operations. Such irons shall be re-established by a licensed lar.d surveyor or a licensed professional engineer in accordance with state laws.
2. All construction shall be in accordance with City of Wichita, Kansas Standard Specifications for Sanitary Sewers.
3. Bench Marks :

   # 1 - "□" Cut on end return east side of Tunis Lane
   NE^{c} intersection of Tunis & Harvest Lane.
   ELEV. = 156.87

   # 2- "□" Cut on end return east side of Tunis Lane
   SE^{c} intersection of Tunis & 17TH Street.
   ELEV. = 156.76


MICHAEL E. LINDEBAK, P.E., CITY ENGINEER

BUILT PER PLAN
RDL
5-89


MUNICIPAL ENGINEERS
Civil Engineers & Land Surveyors
254 Laura, Suite 201
Wichita, Kansas 67211

SCALE: AS SHOWN | APPROVED BY: | DRAWN BY M.W.
DATE: 2 - 89 | REVISED
DRAWING NUMBER 1/2

24 X 36 PRINTED ON NO. 1000H CLEARPRINT 4

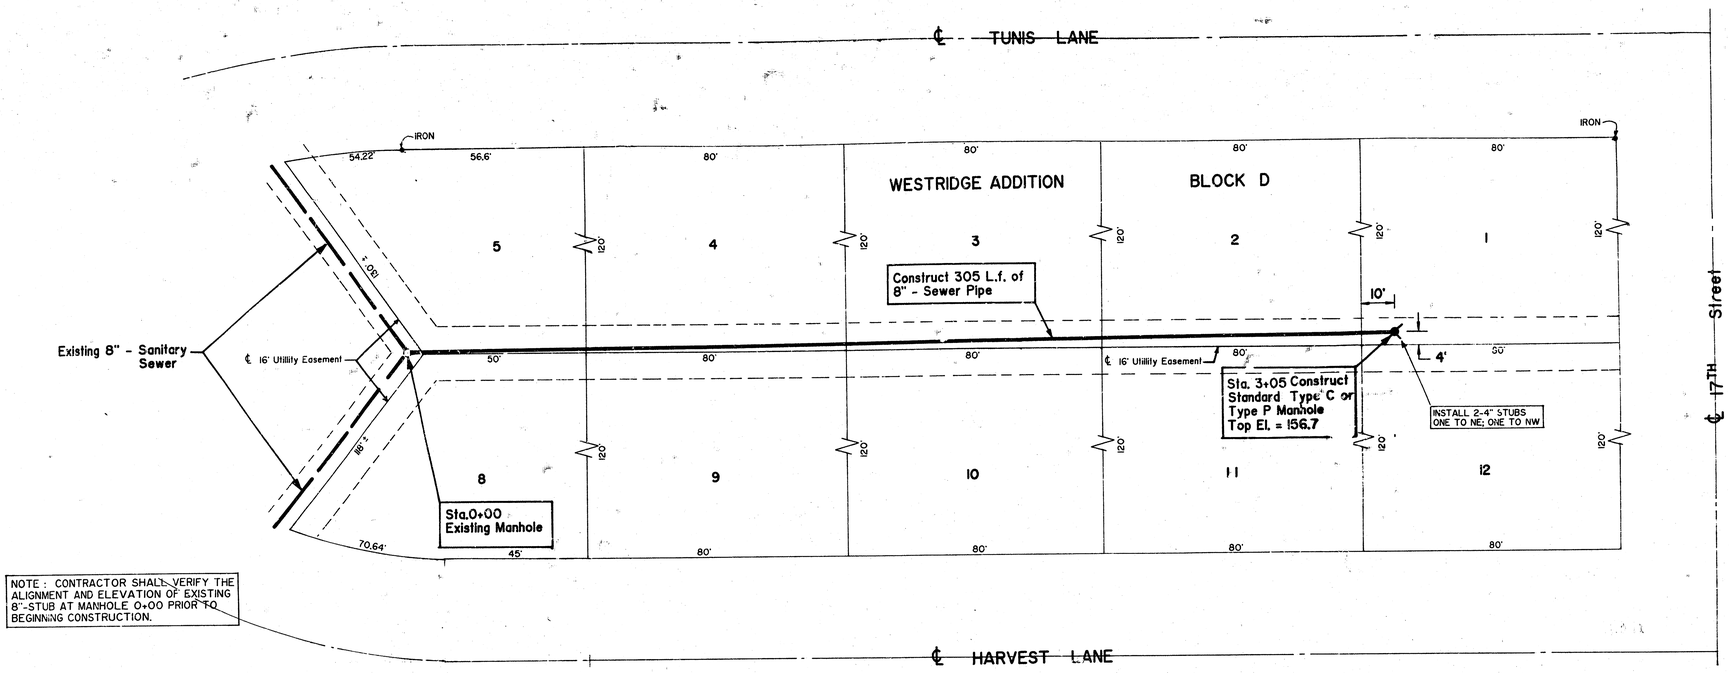

SCALE : PLAN - 1" = 20'
PROFILE - 1" = 20' (H)
1" = 5' (V)

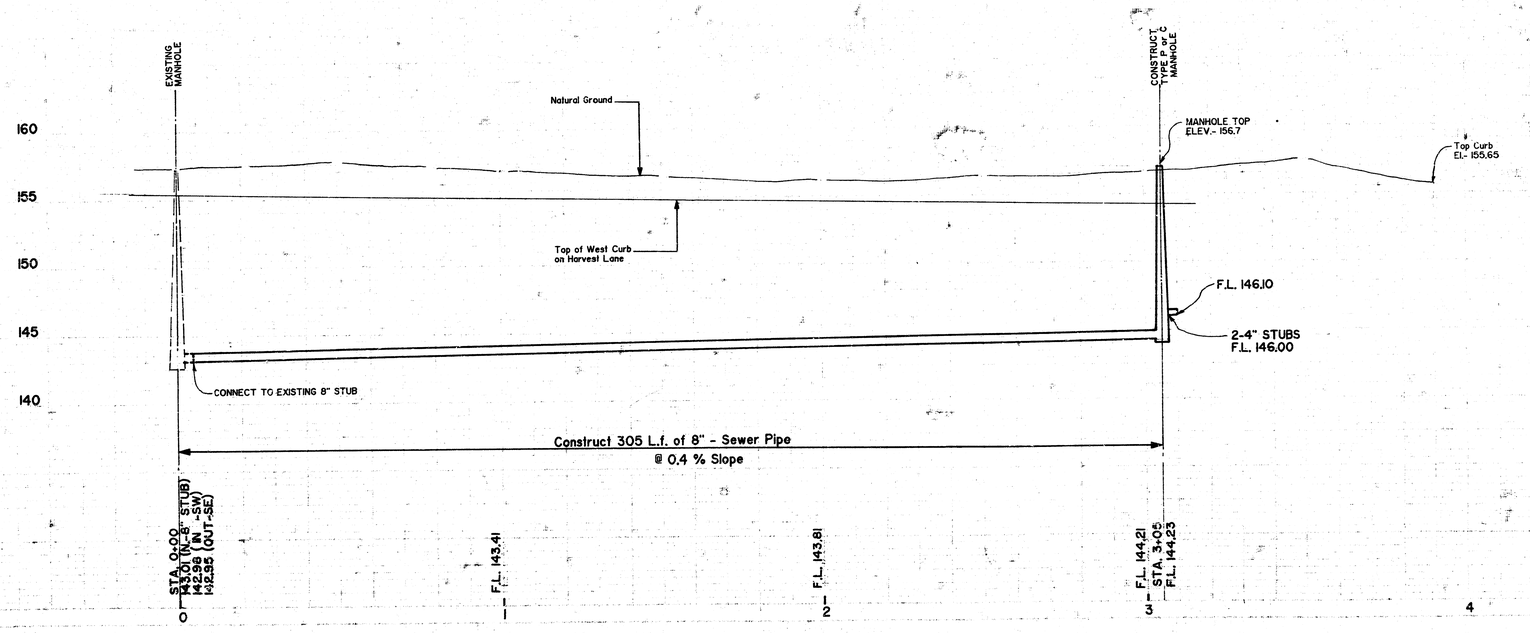

MUNICIPAL ENGINEERS
Civil Engineers & Land Surveyors
254 Laura, Suite 301
Wichita, Kansas 67211

PLAN & PROFILE SHEET		
SCALE: AS SHOWN	APPROVED BY: B.K.	DRAWN BY : M.W.
DATE: 2 - 89		REVISED :
LATERAL 280, S.W. INTERCEPTOR WESTRIDGE VILLAGE BLK D		
PROJECT NUMBER: 468-76-245-8'933-000-000-001		DRAWING NUMBER 2 of 2

21/2