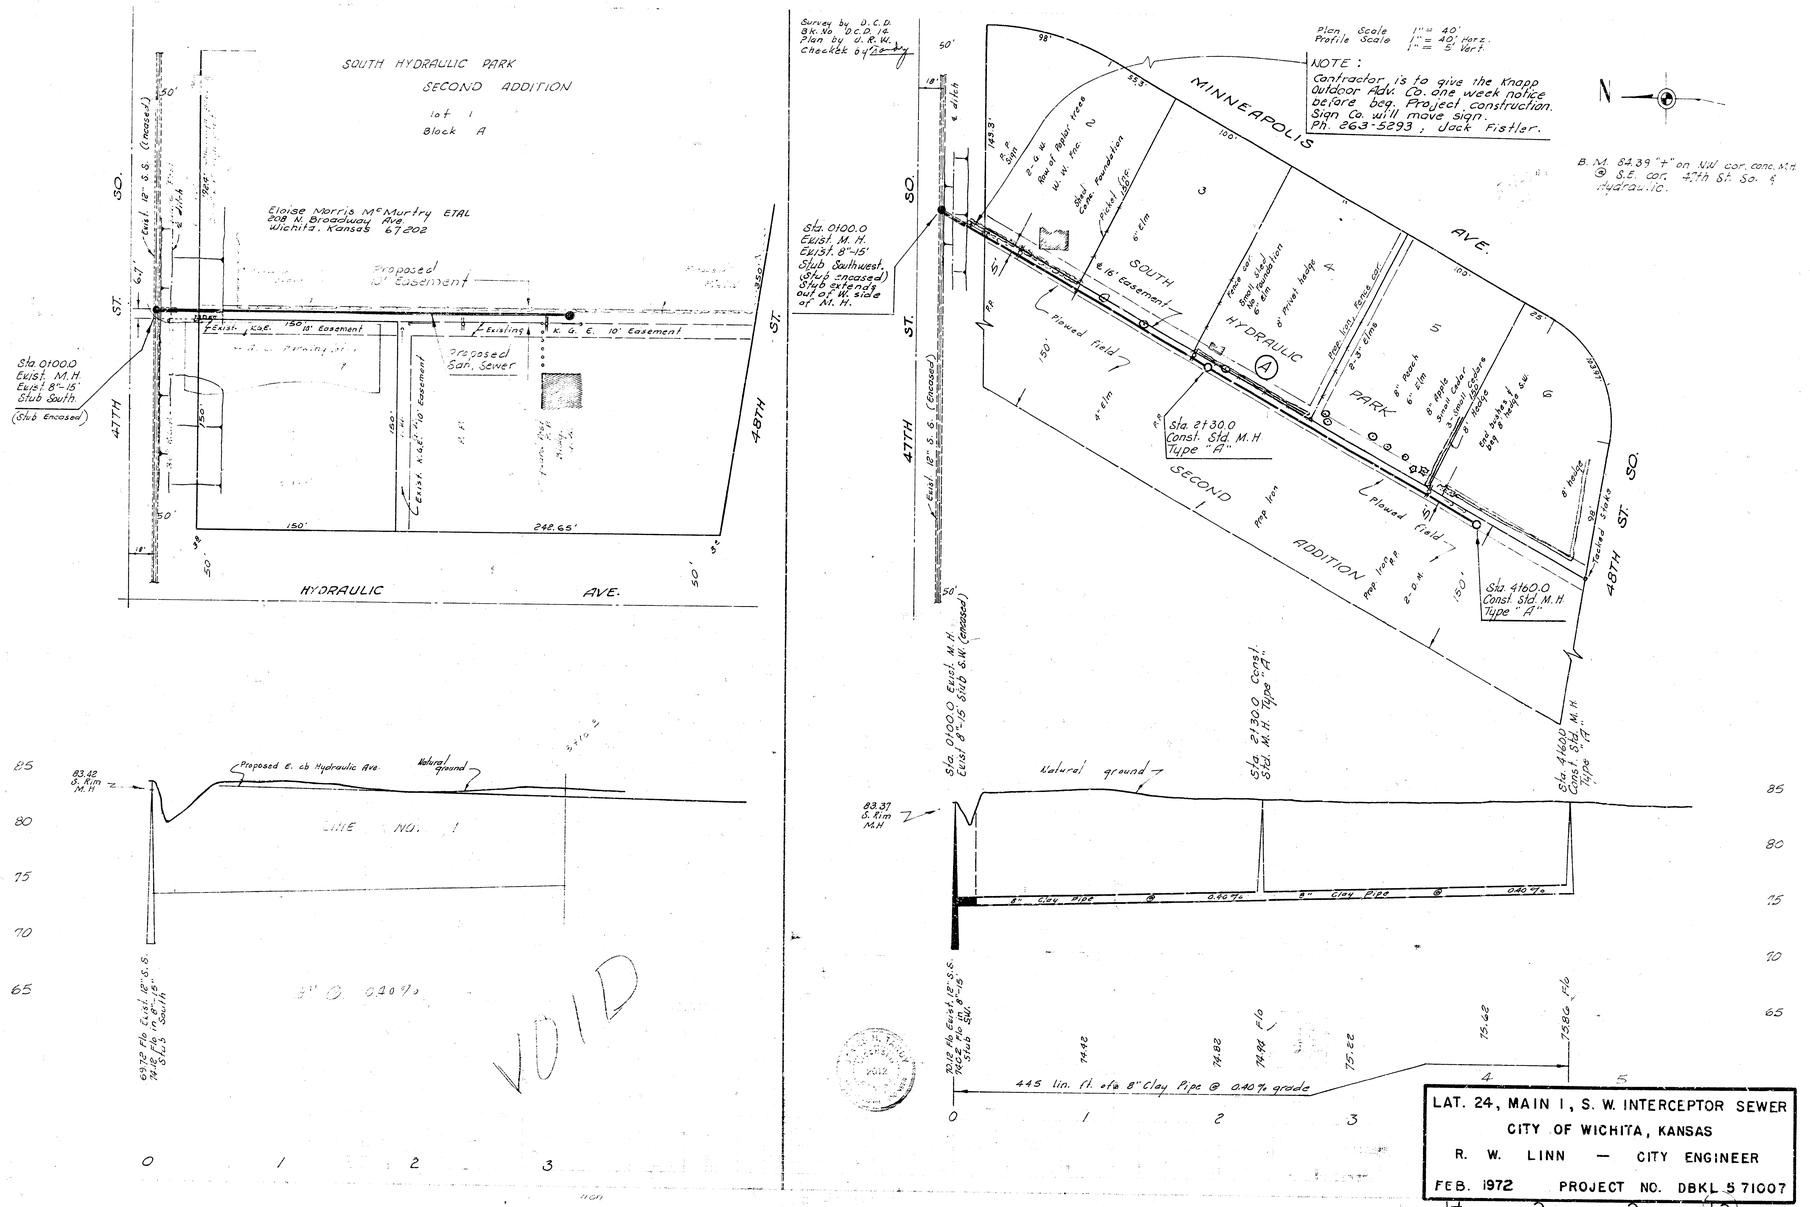
SOUTH HYDRAULIC PARK
SECOND ADDITION
lot 1
Block A
Eloise Morris McMurtry ETAL
208 N. Broadway Ave.
Wichita, Kansas 67202
Proposed 10' Easement
Exist. K.G.E. 150' 13' Easement
Existing K. G. E. 10' Easement
Proposed San. Sewer
Exist. K.G.E. 10' Easement
Sta. 0100.0
Exist. M.H.
Exist. 8"-15'
Stub South
(Stub Encased)
47TH ST. SO.
48TH ST.
HYDRAULIC AVE.
150'
248.65'
Survey by D.C.D.
Bk. No. D.C.D. 14
Plan by U.R.W.
Checked by
Sta. 0100.0
Exist. M.H.
Exist. 8"-15'
Stub Southwest.
(Stub Encased)
Stub extend's out of W. side of Al. H.
Exist. 12" S.S. (Encased)
Plan Scale 1" = 40'
Profile Scale 1" = 40' Horz.
1" = 5' Vert.
NOTE:
Contractor is to give the Knapp Outdoor Adv. Co one week notice before beg. Project construction. Sign Co. will move sign.
Ph. 263-5293; Jack Fistler.
N
B. M. 84.39 "+" on N.W. cor. conc. M.H. @ S.E. cor. 47th St. So. & Hydraulic.
MINNEAPOLIS AVE.
SOUTH HYDRAULIC PARK
SECOND ADDITION
Plowed field
Sta. 2+30.0
Const. Std. M.H.
Type "A"
Sta. 4+60.0
Const. Std. M.H.
Type "A"
Sta. 0100.0 Exist. M.H.
Exist. 8"-15' Stub S.W. (Encased)
Sta. 2130.0 Const. Std. M.H. Type "A"
Sta. 4600 Const. Std. M.H. Type "A"
Proposed E. cb Hydraulic Ave.
Natural ground
83.42
G. Rim
M.H.
LINE NO. 1
8" @ 0.40%
VOID
83.37
G. Rim
M.H.
8" Clay Pipe @ 0.40%
445 lin. ft. of a 8" Clay Pipe @ 0.40% grade
LAT. 24, MAIN 1, S. W. INTERCEPTOR SEWER
CITY OF WICHITA, KANSAS
R. W. LINN — CITY ENGINEER
FEB. 1972 PROJECT NO. DBKL 5 71007