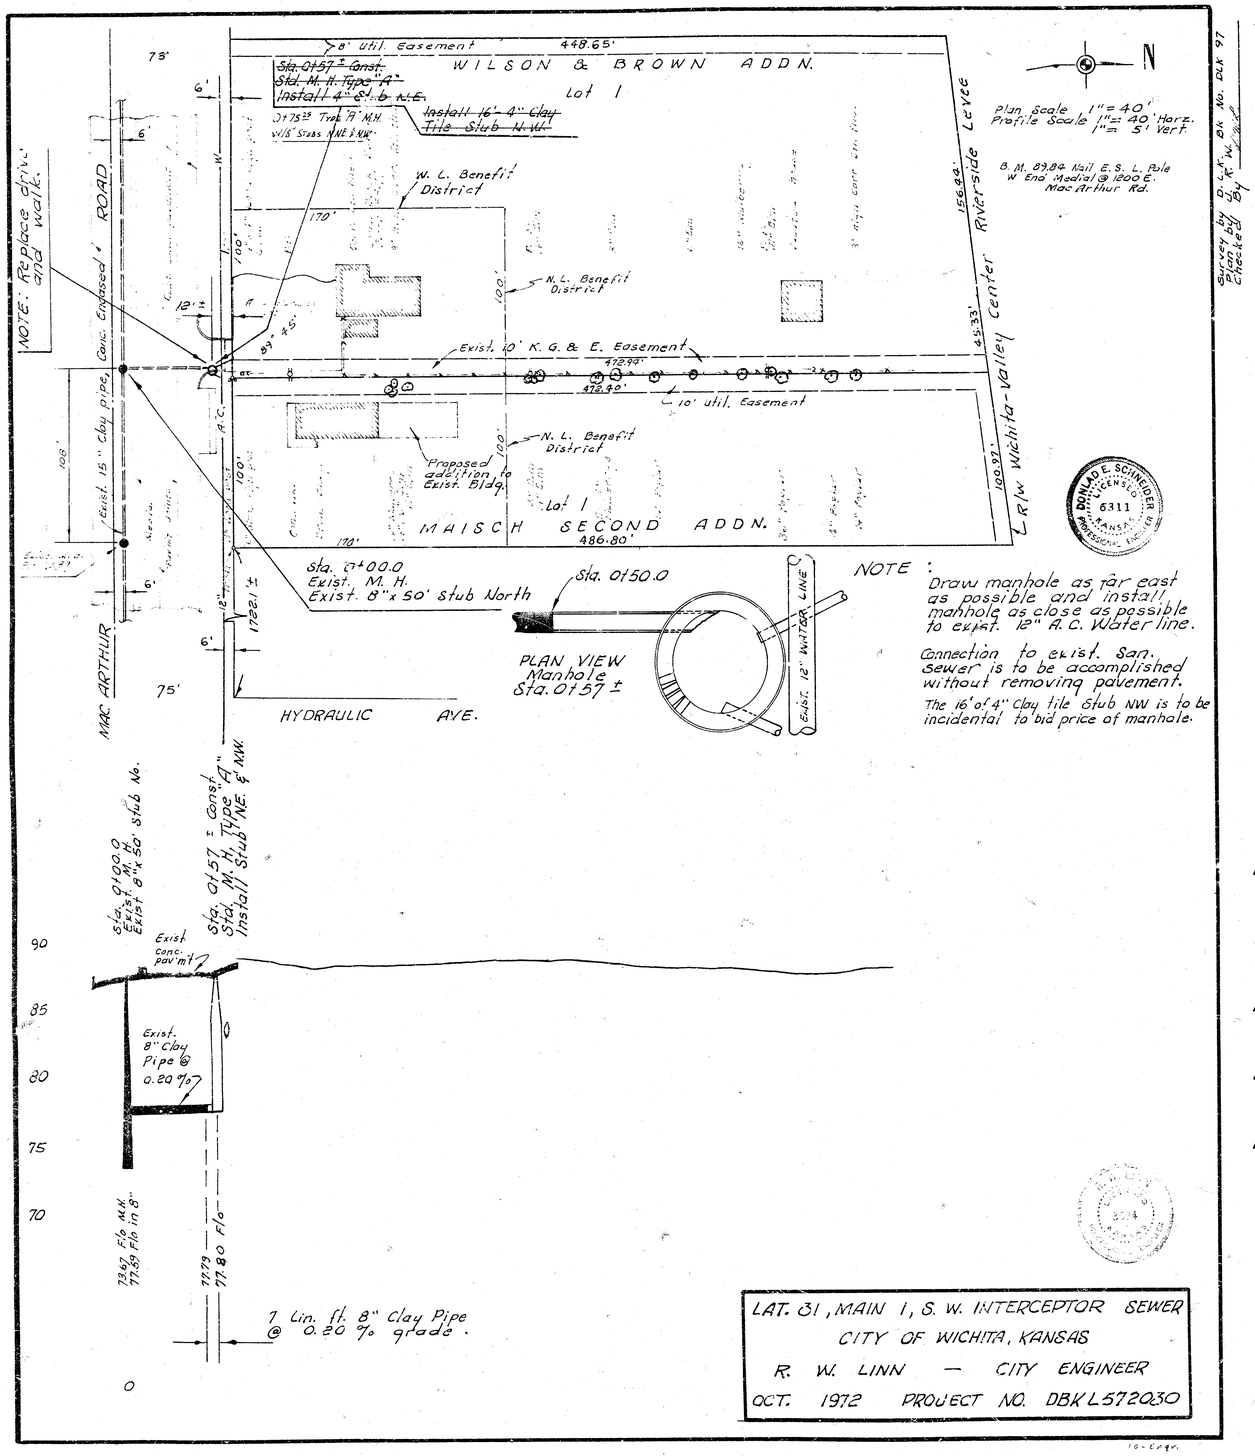

LAT. 31, MAIN 1, S. W. INTERCEPTOR SEWER
CITY OF WICHITA, KANSAS
R. W. LINN — CITY ENGINEER
OCT. 1972 PROJECT NO. DBKL572030

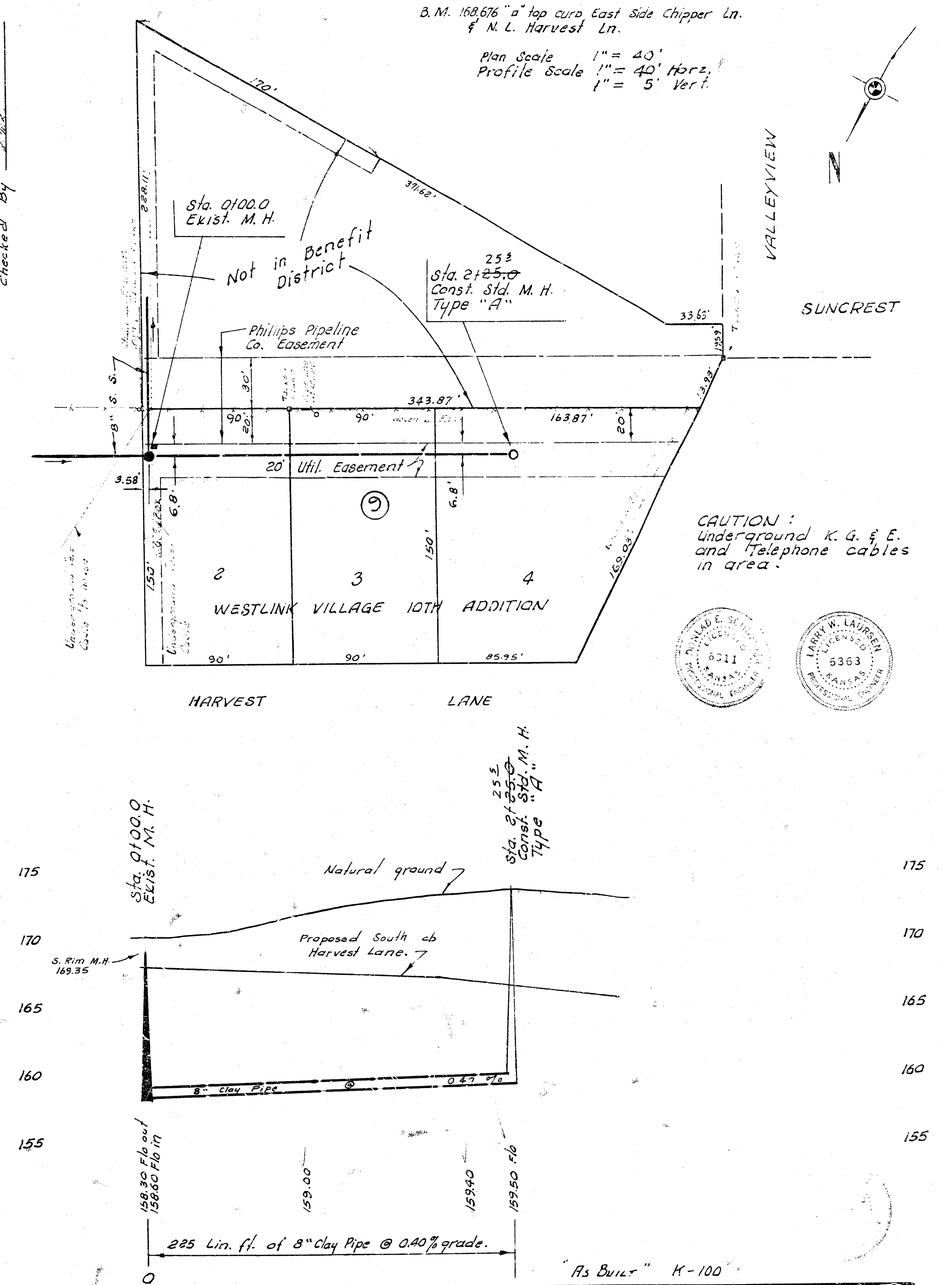

LAT. 56, WESTLINK SEWER
CITY OF WICHITA, KANSAS
R. W. LINN — CITY ENGINEER
NOV. 1972 PROJECT NO. DBKL572054

FILMED FROM THE BEST AVAILABLE COPY