
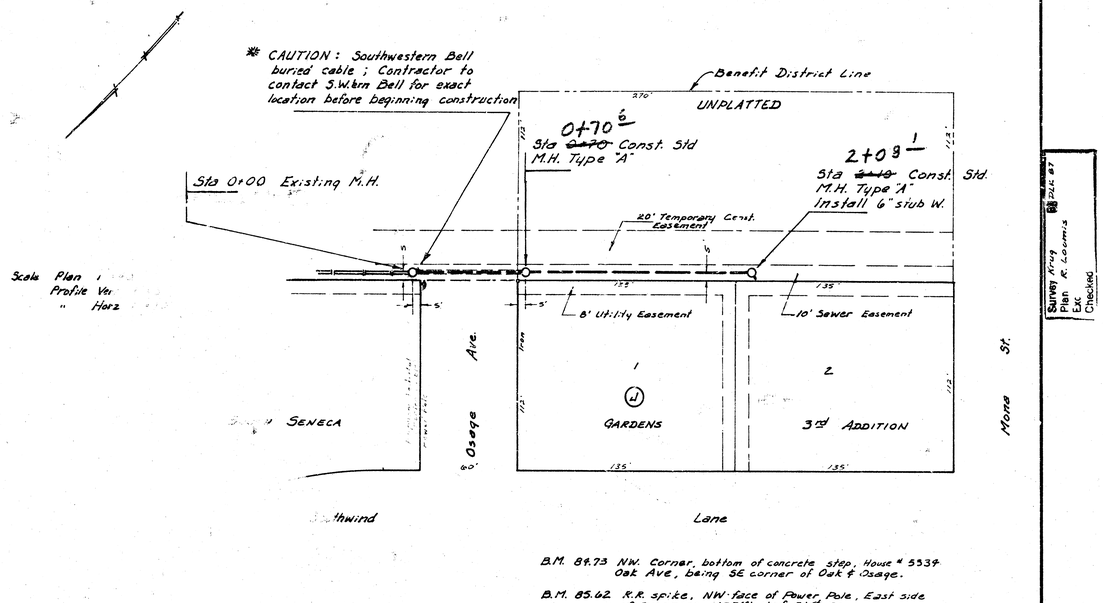


B.M. 84.73 N.W. Corner, bottom of concrete step, House # 5539 Oak Ave, being SE corner of Oak & Osage.

B.M. 85.62 R.R. spike, NW face of Power Pole, East side of Sycamore, 1351ft N. of 31st So.

B.M. 83.98 N.E. corner concrete porch, House # 801 W. 52nd St. So.

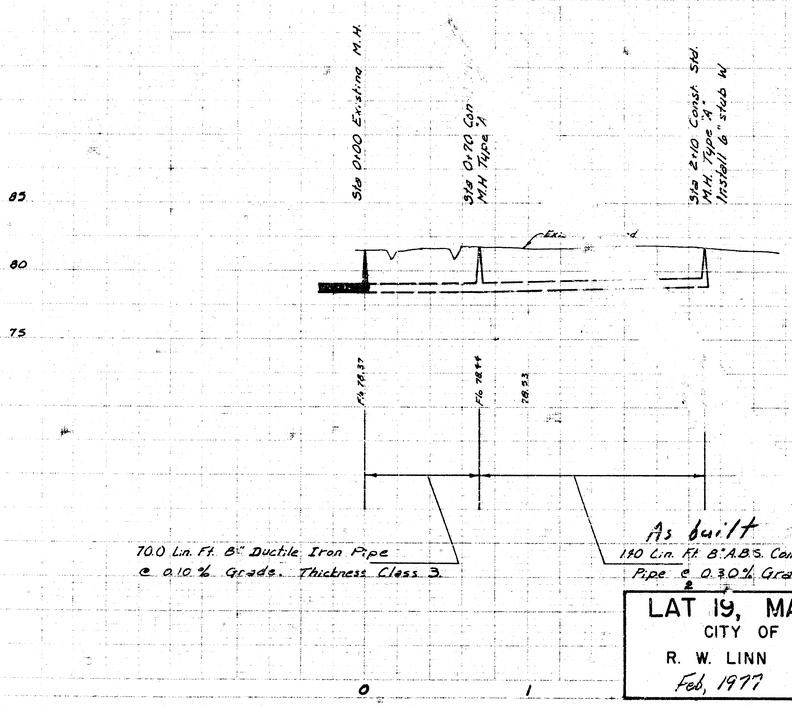


As built 7-77


DONALD E. SCHNEIDER LICENSED 6311 KANSAS PROFESSIONAL ENGINEER

LAT 19, MAIN 3, S.W. INTR.
CITY OF WICHITA, KANSAS
R. W. LINN — CITY ENGINEER
Feb, 1977 PROJ. NO. DBKL576054

NOTE: CONTRACTOR IS TO CONTACT MR. RICHARDSON WHOSE PHONE NUMBER IS 524-0881 AND DISCUSS WITH HIM THE PROBABLE EXTENT OF DAMAGE TO TREES ON HIS PROPERTY AS A RESULT OF THE SEWER CONSTRUCTION PRIOR TO STARTING WORK.

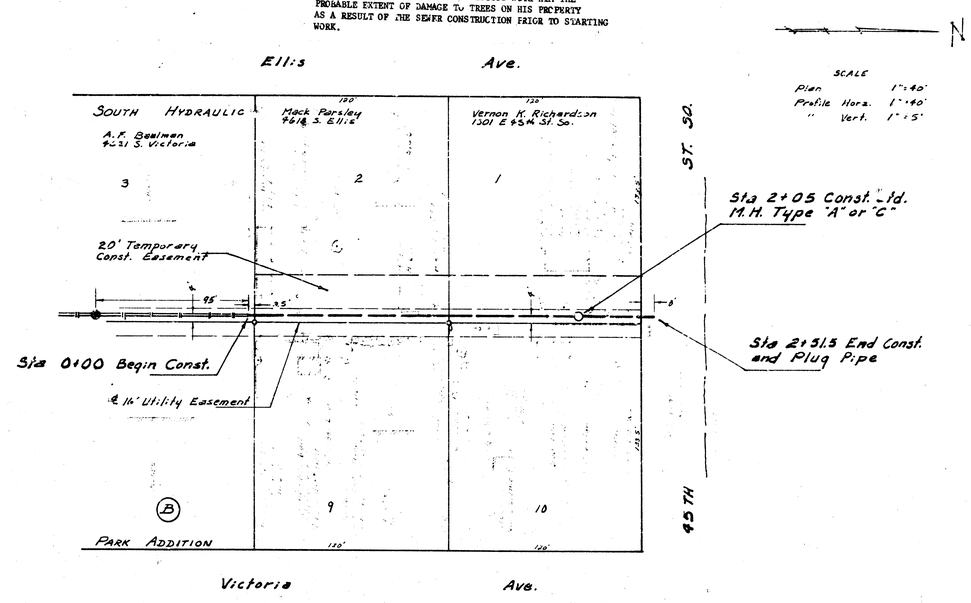

B.M. 85.37 Step Bench on S.S. power pole on N.W. corner Ellis & 44th St. S.

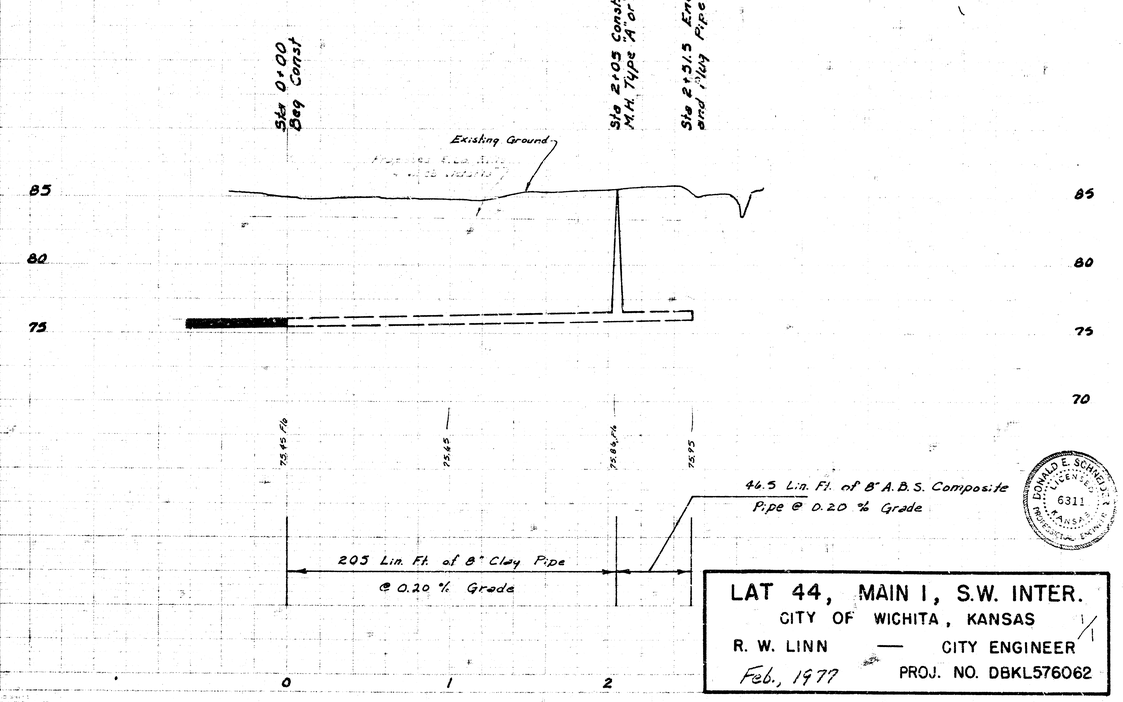

DONALD E. SCHNEIDER LICENSED 6311 KANSAS PROFESSIONAL ENGINEER

LAT 44, MAIN 1, S.W. INTER.
CITY OF WICHITA, KANSAS
R. W. LINN — CITY ENGINEER
Feb., 1977 PROJ. NO. DBKL576062

N 10 3 13