




—Z—

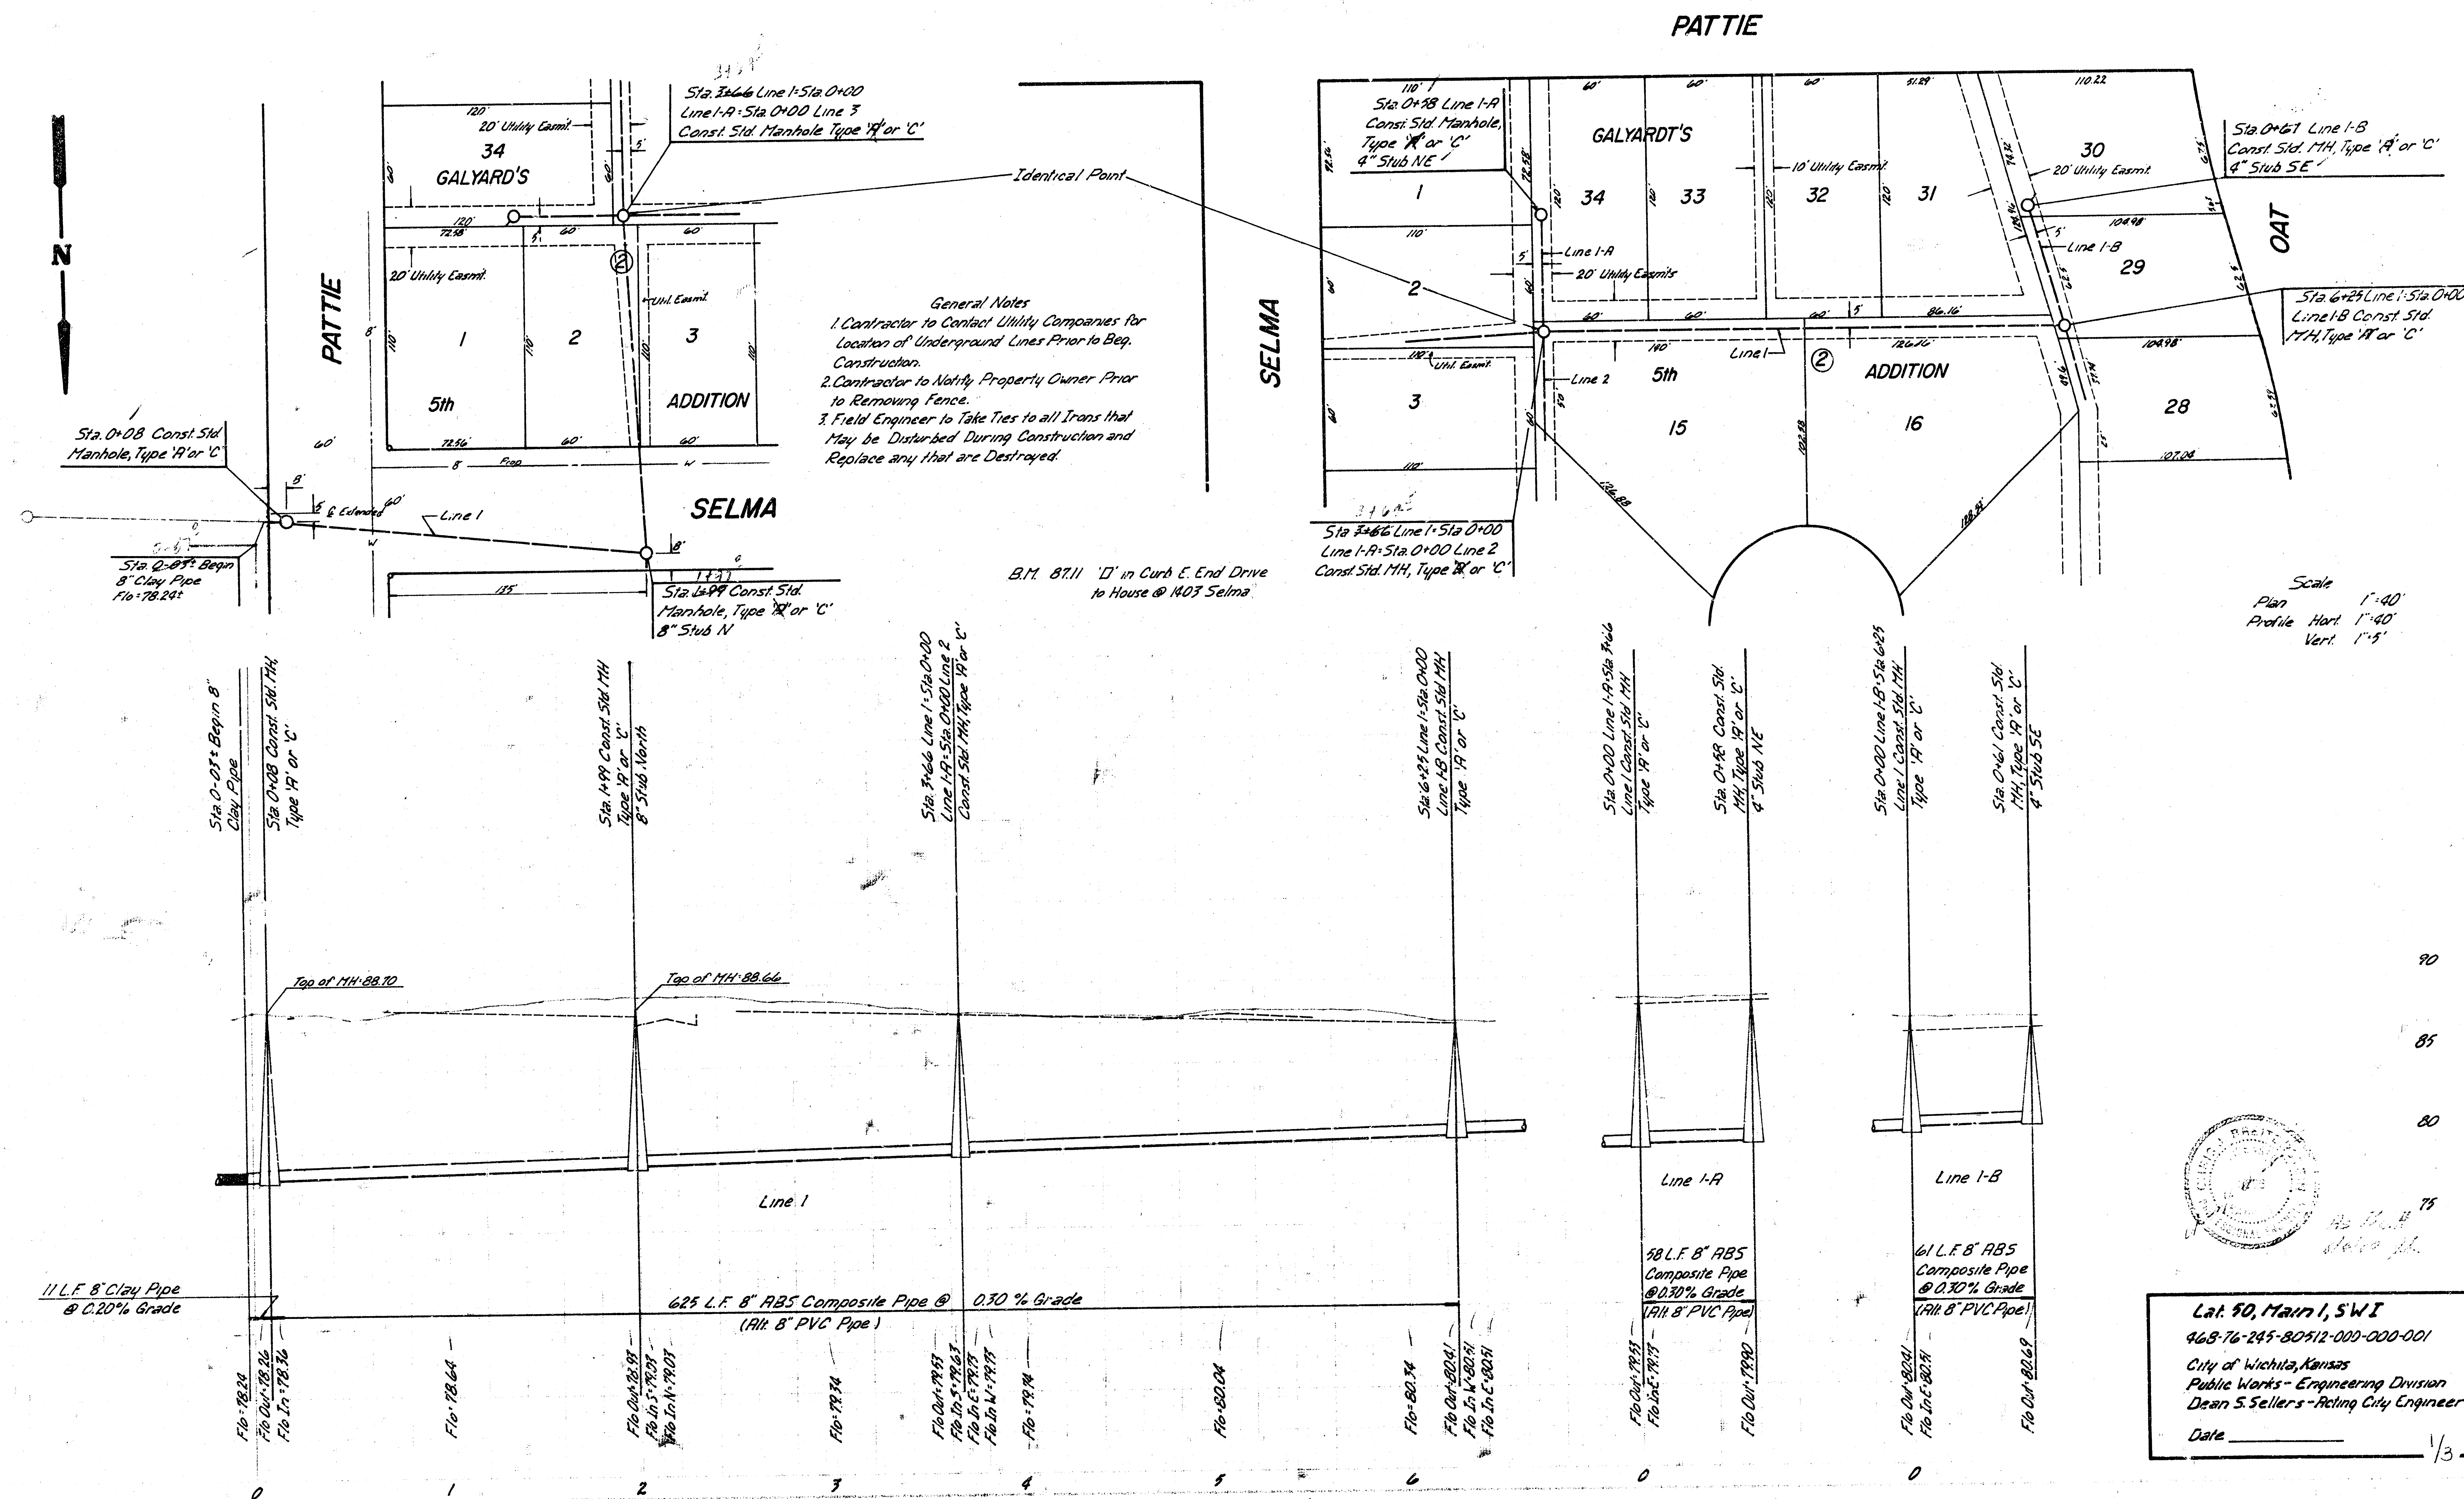


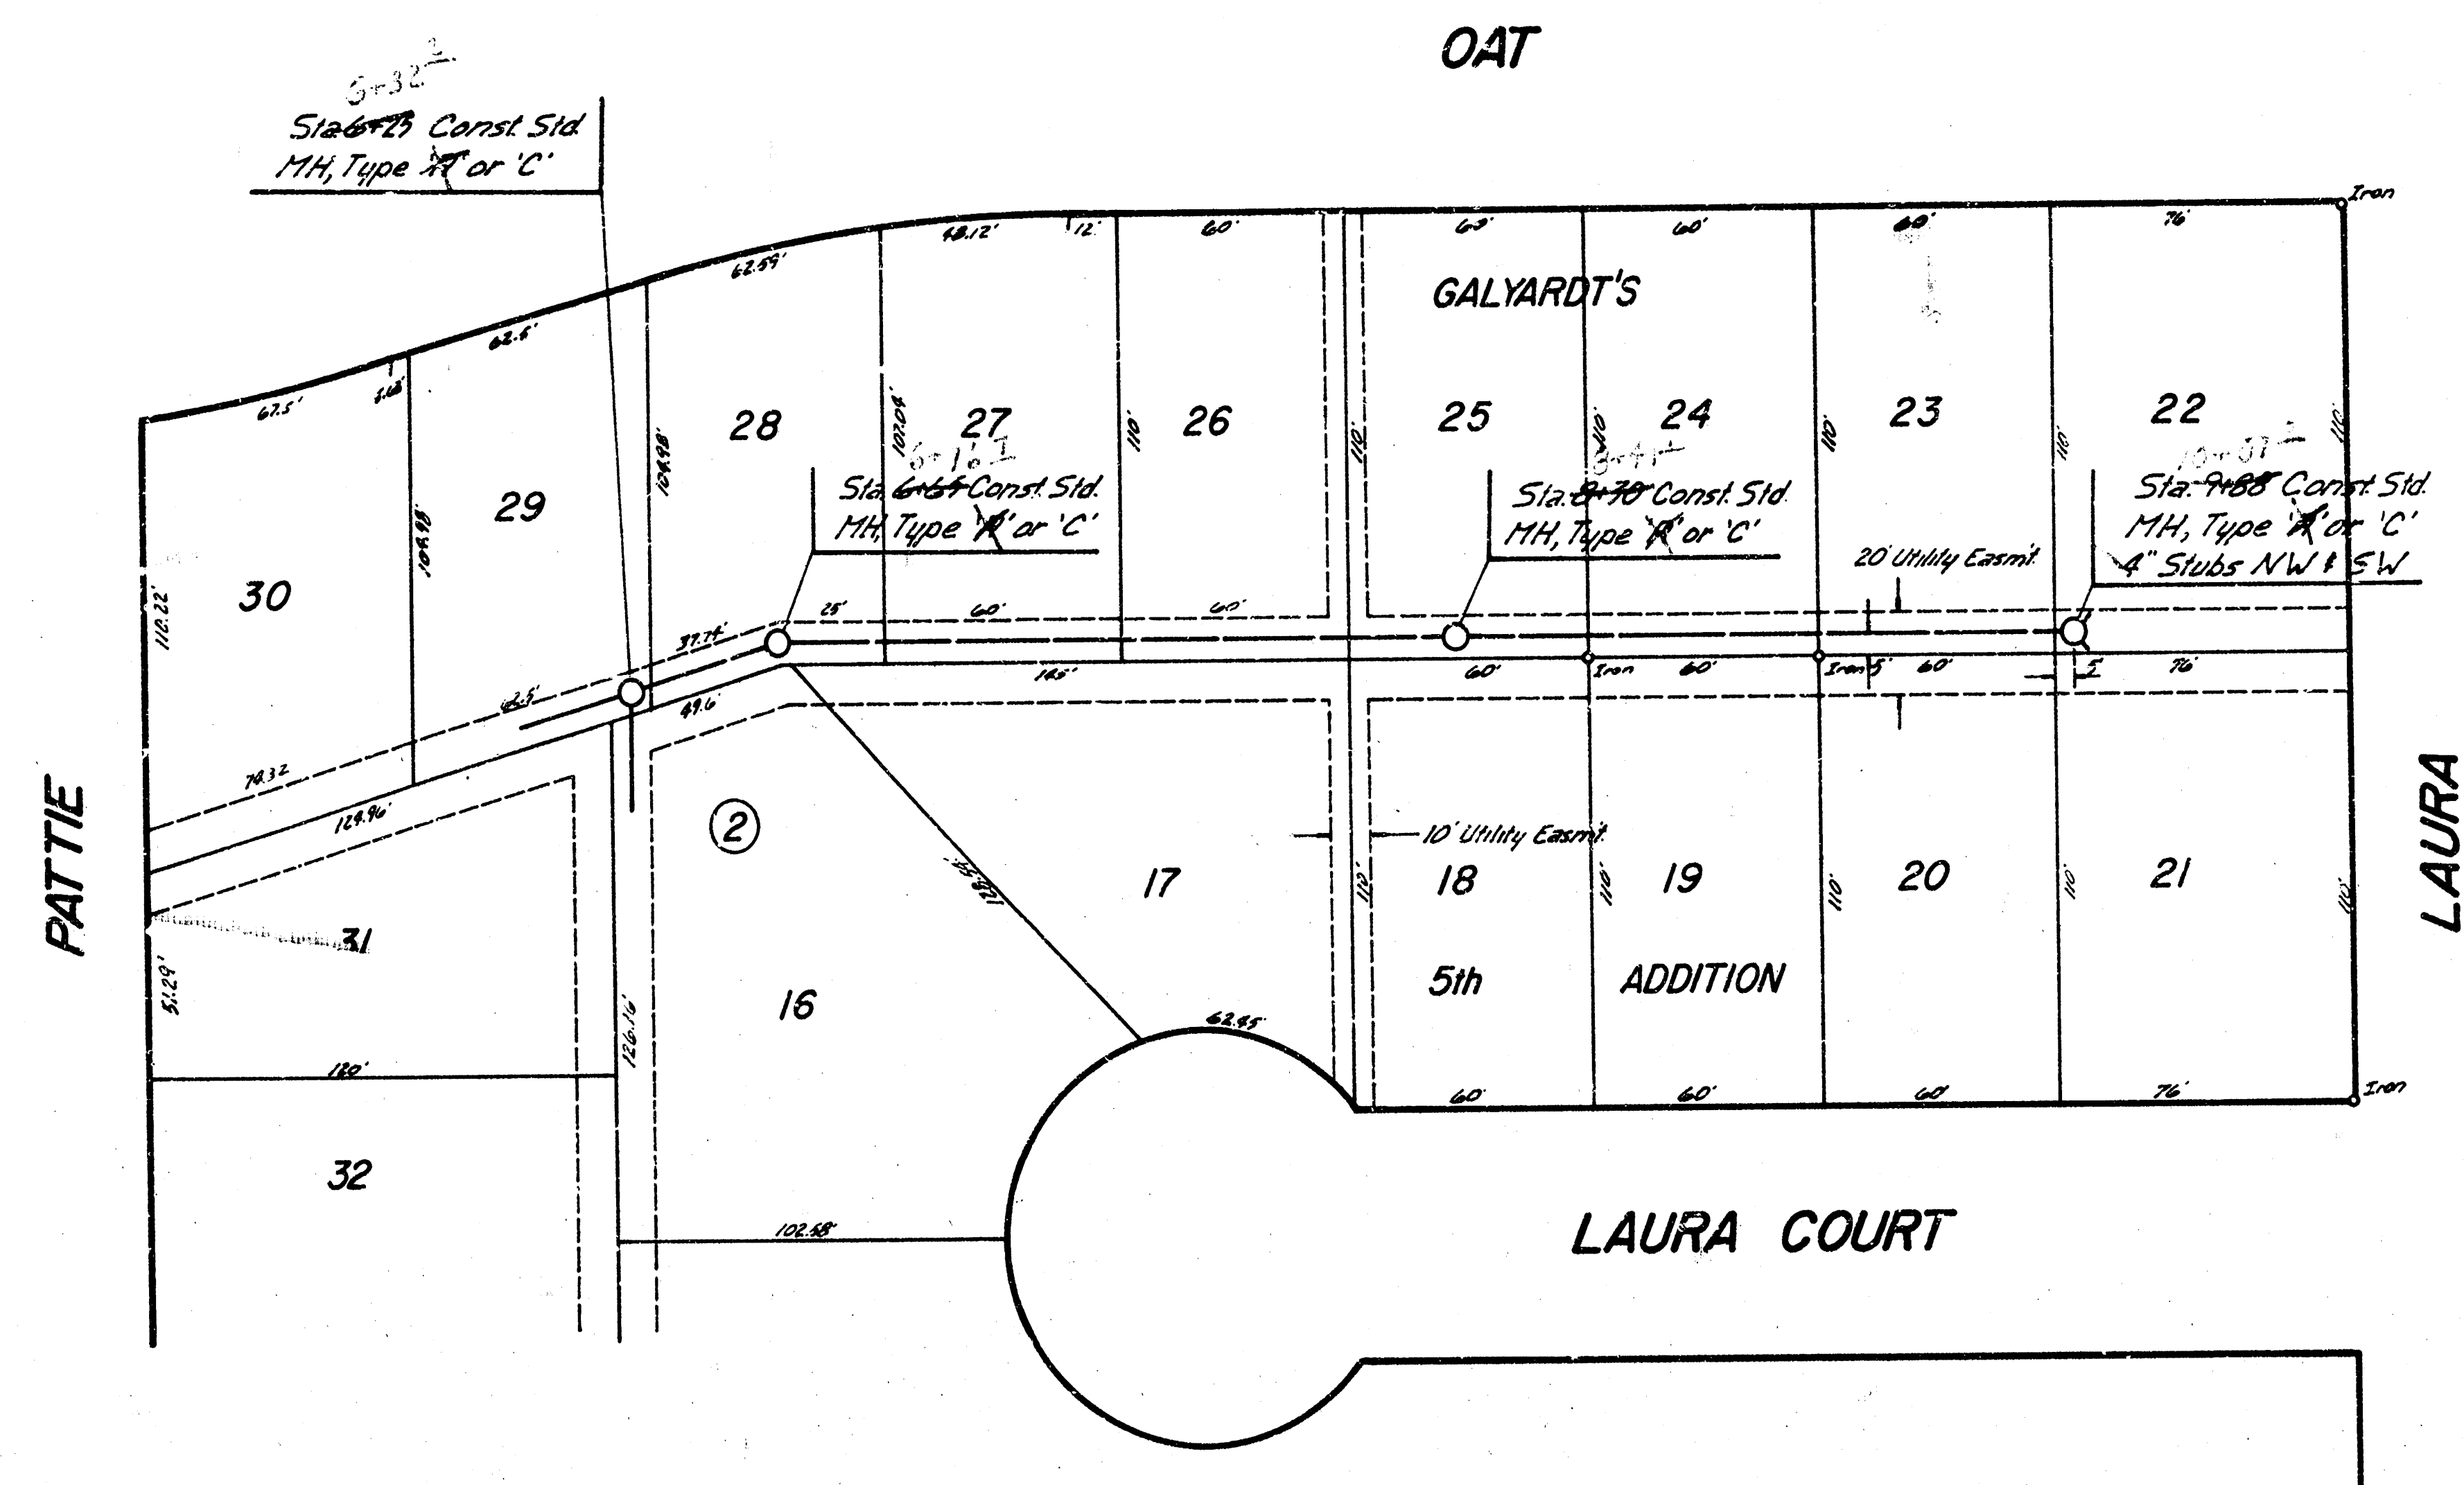


Scale
Plan 1"=40'
Profile Horiz 1"=40'
Vert 1"=5'

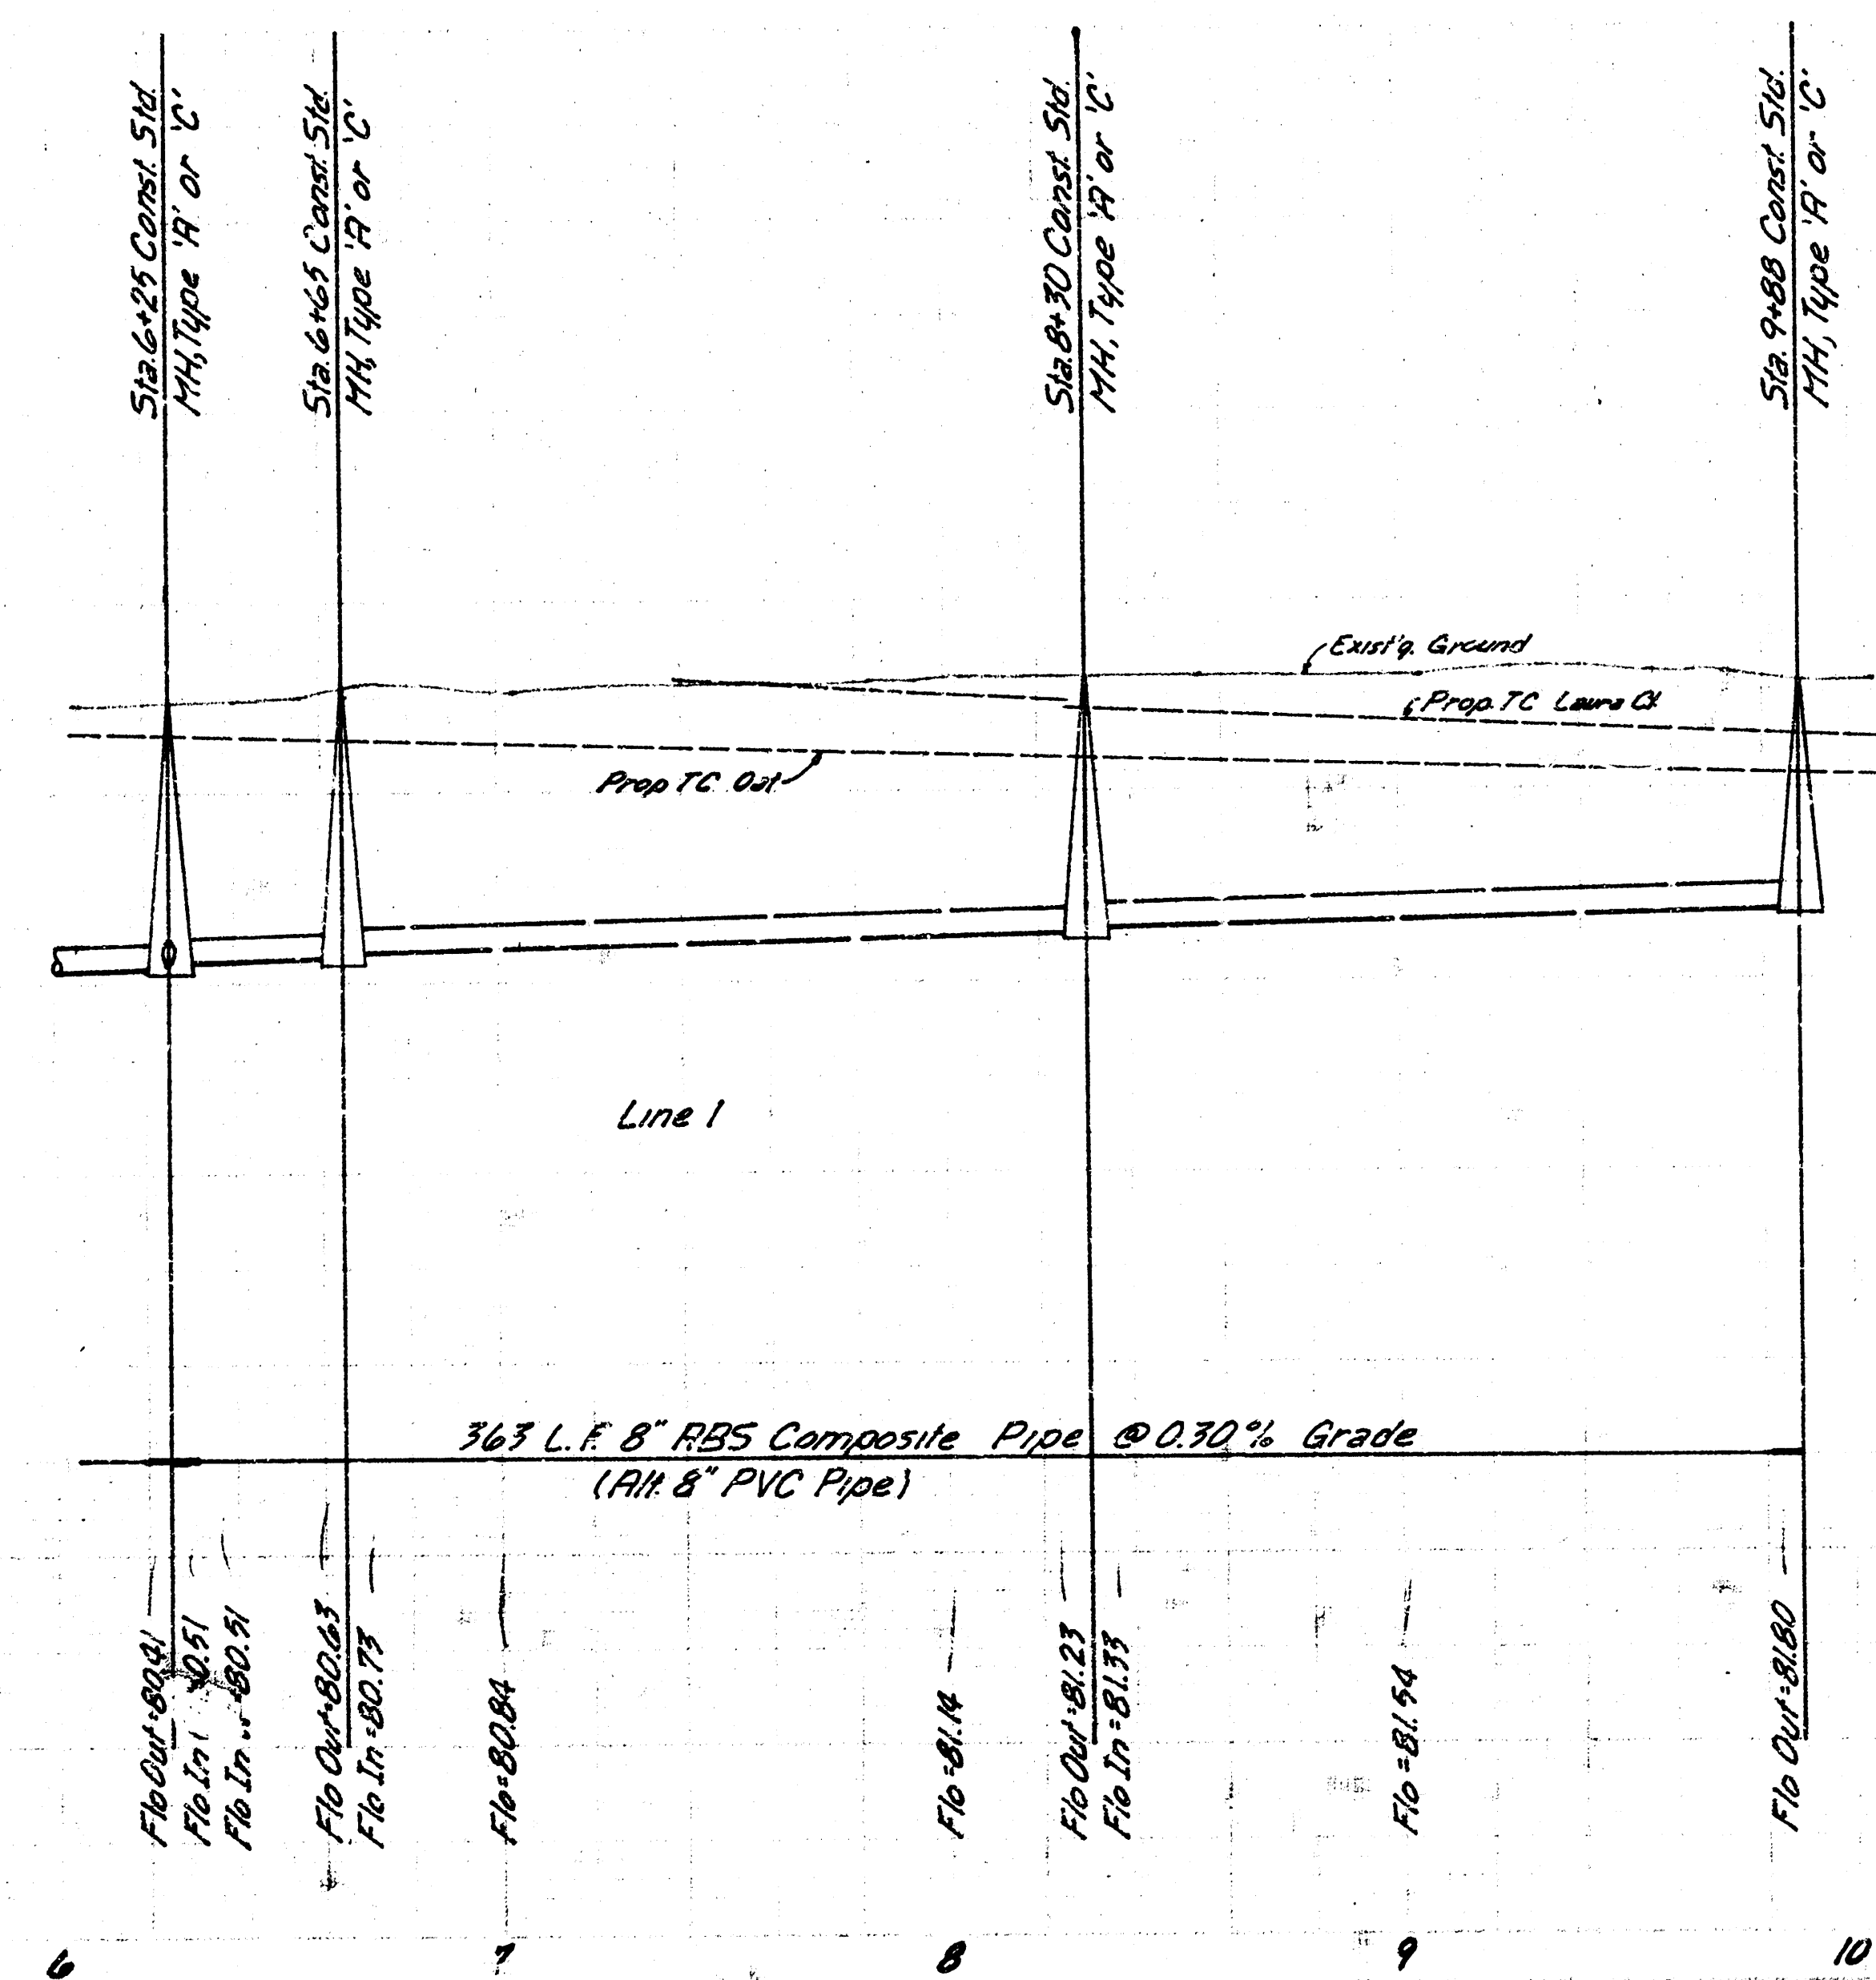

Line 1
Lat 50, Main 1 SWI 2/3

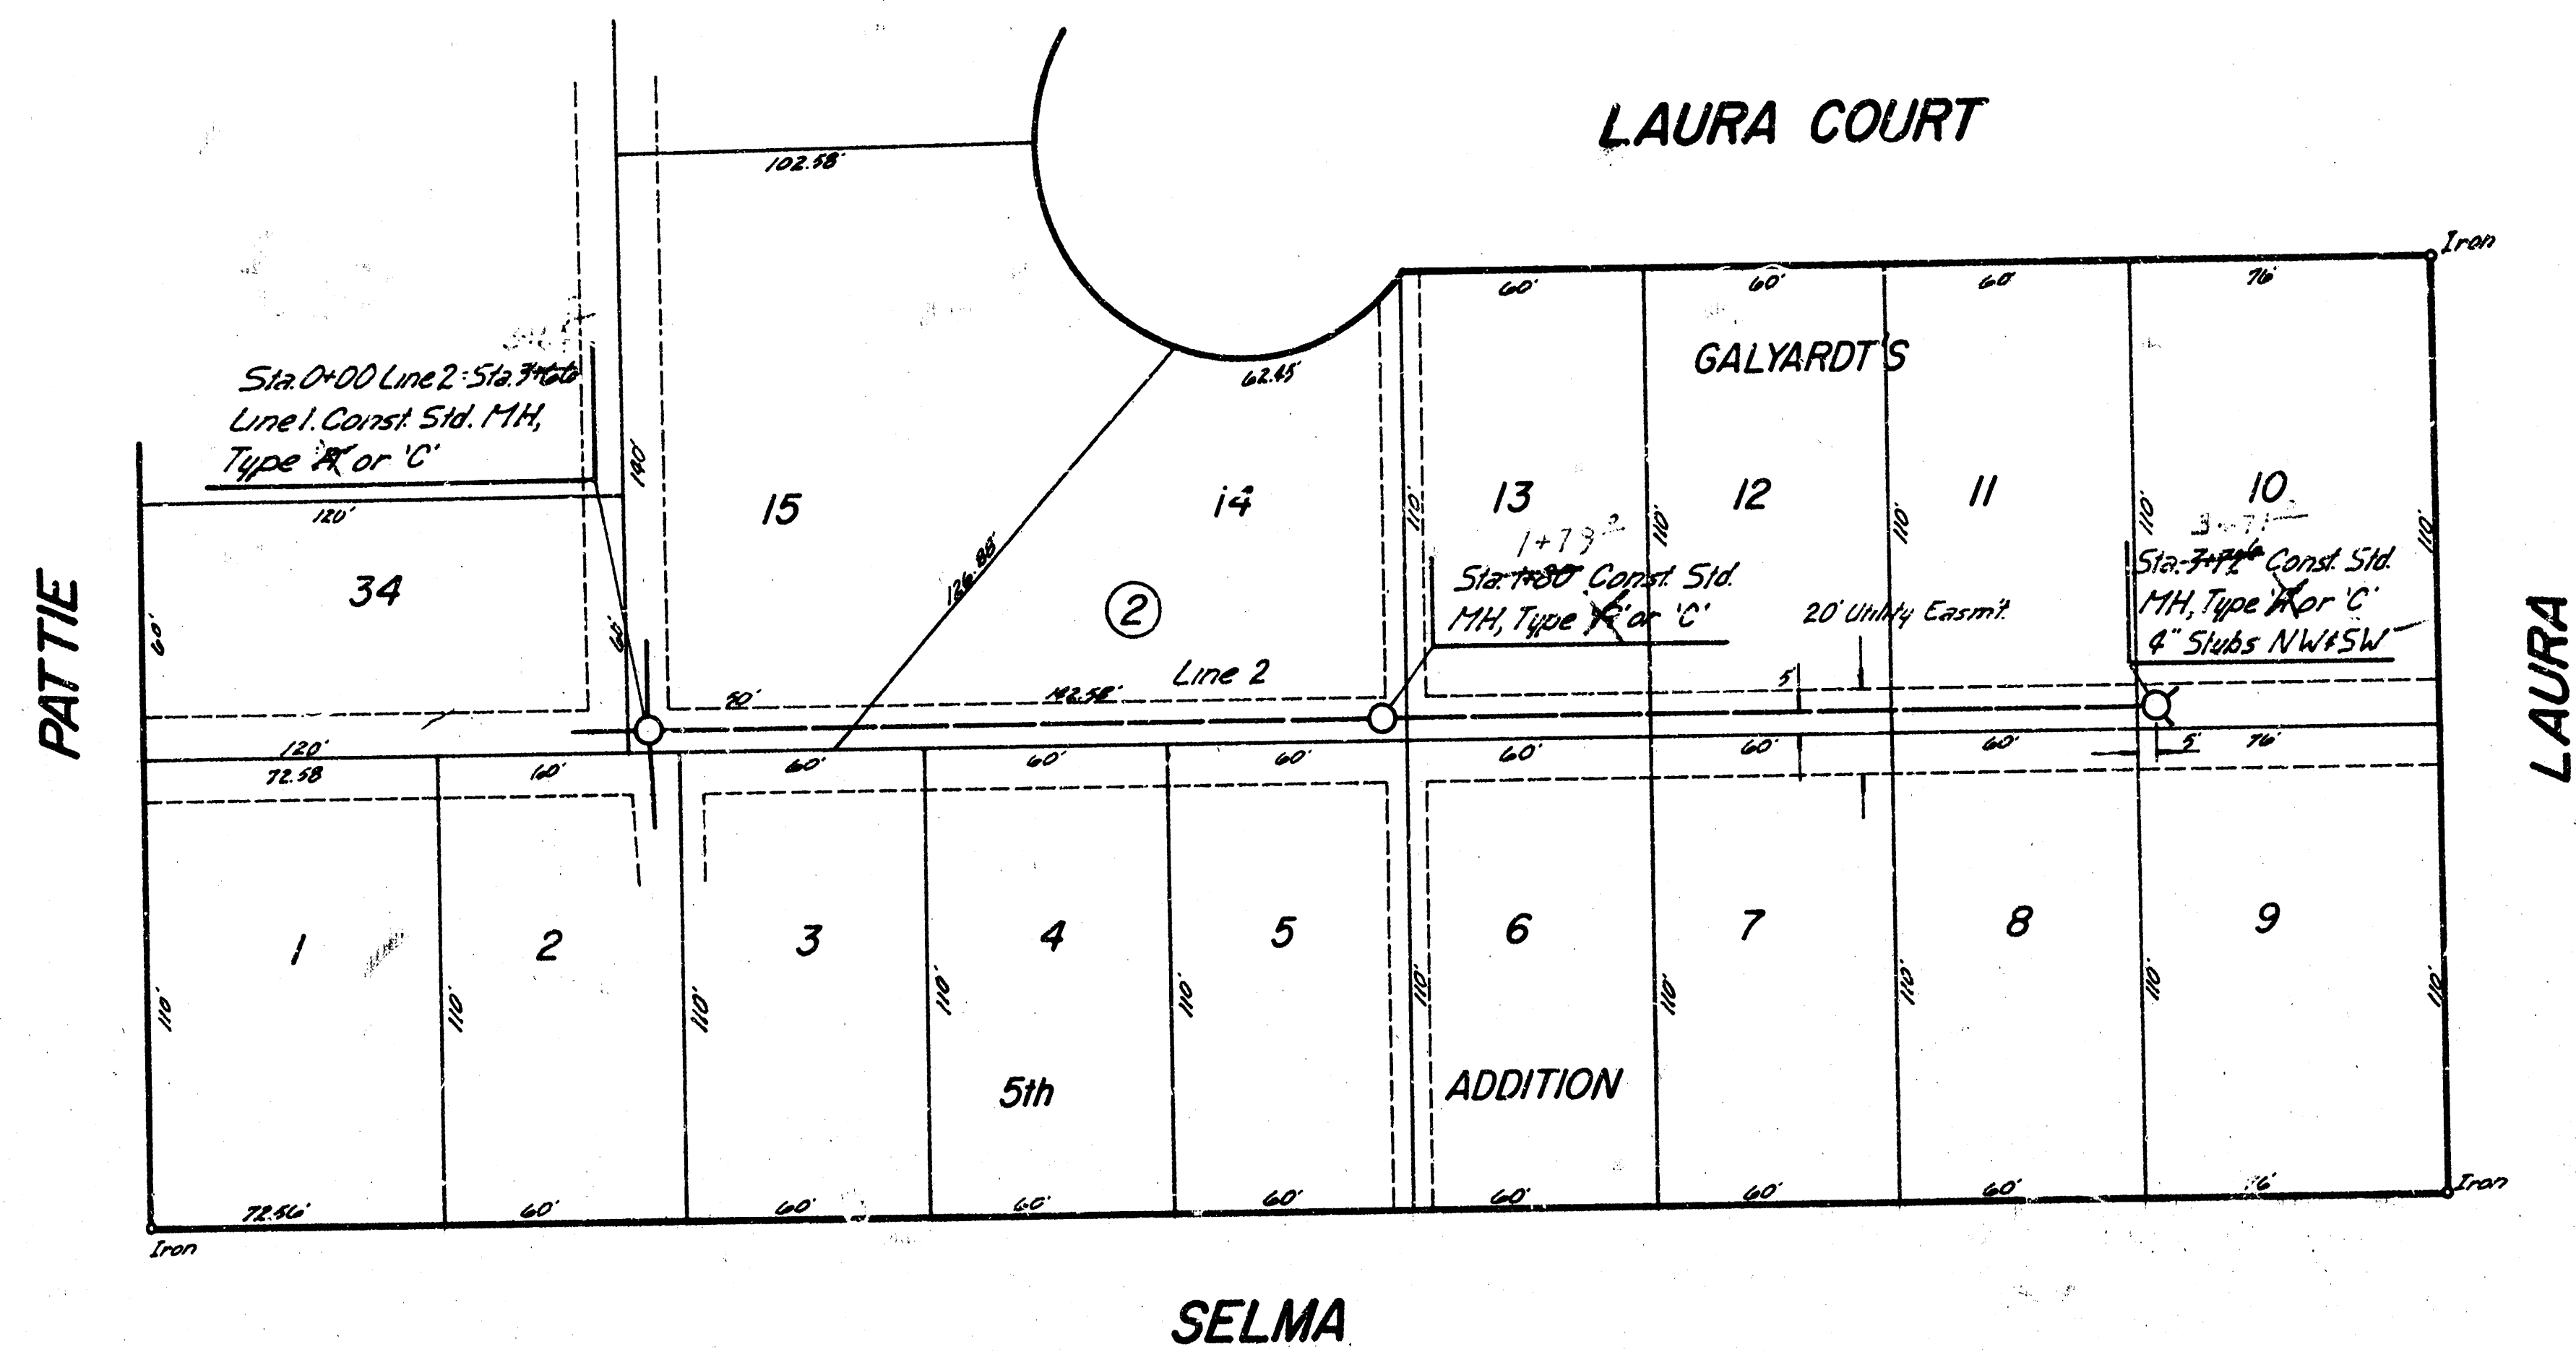

Scale
Plan 1"=40'
Profile Horiz 1"=40'
Vert 1"=5'

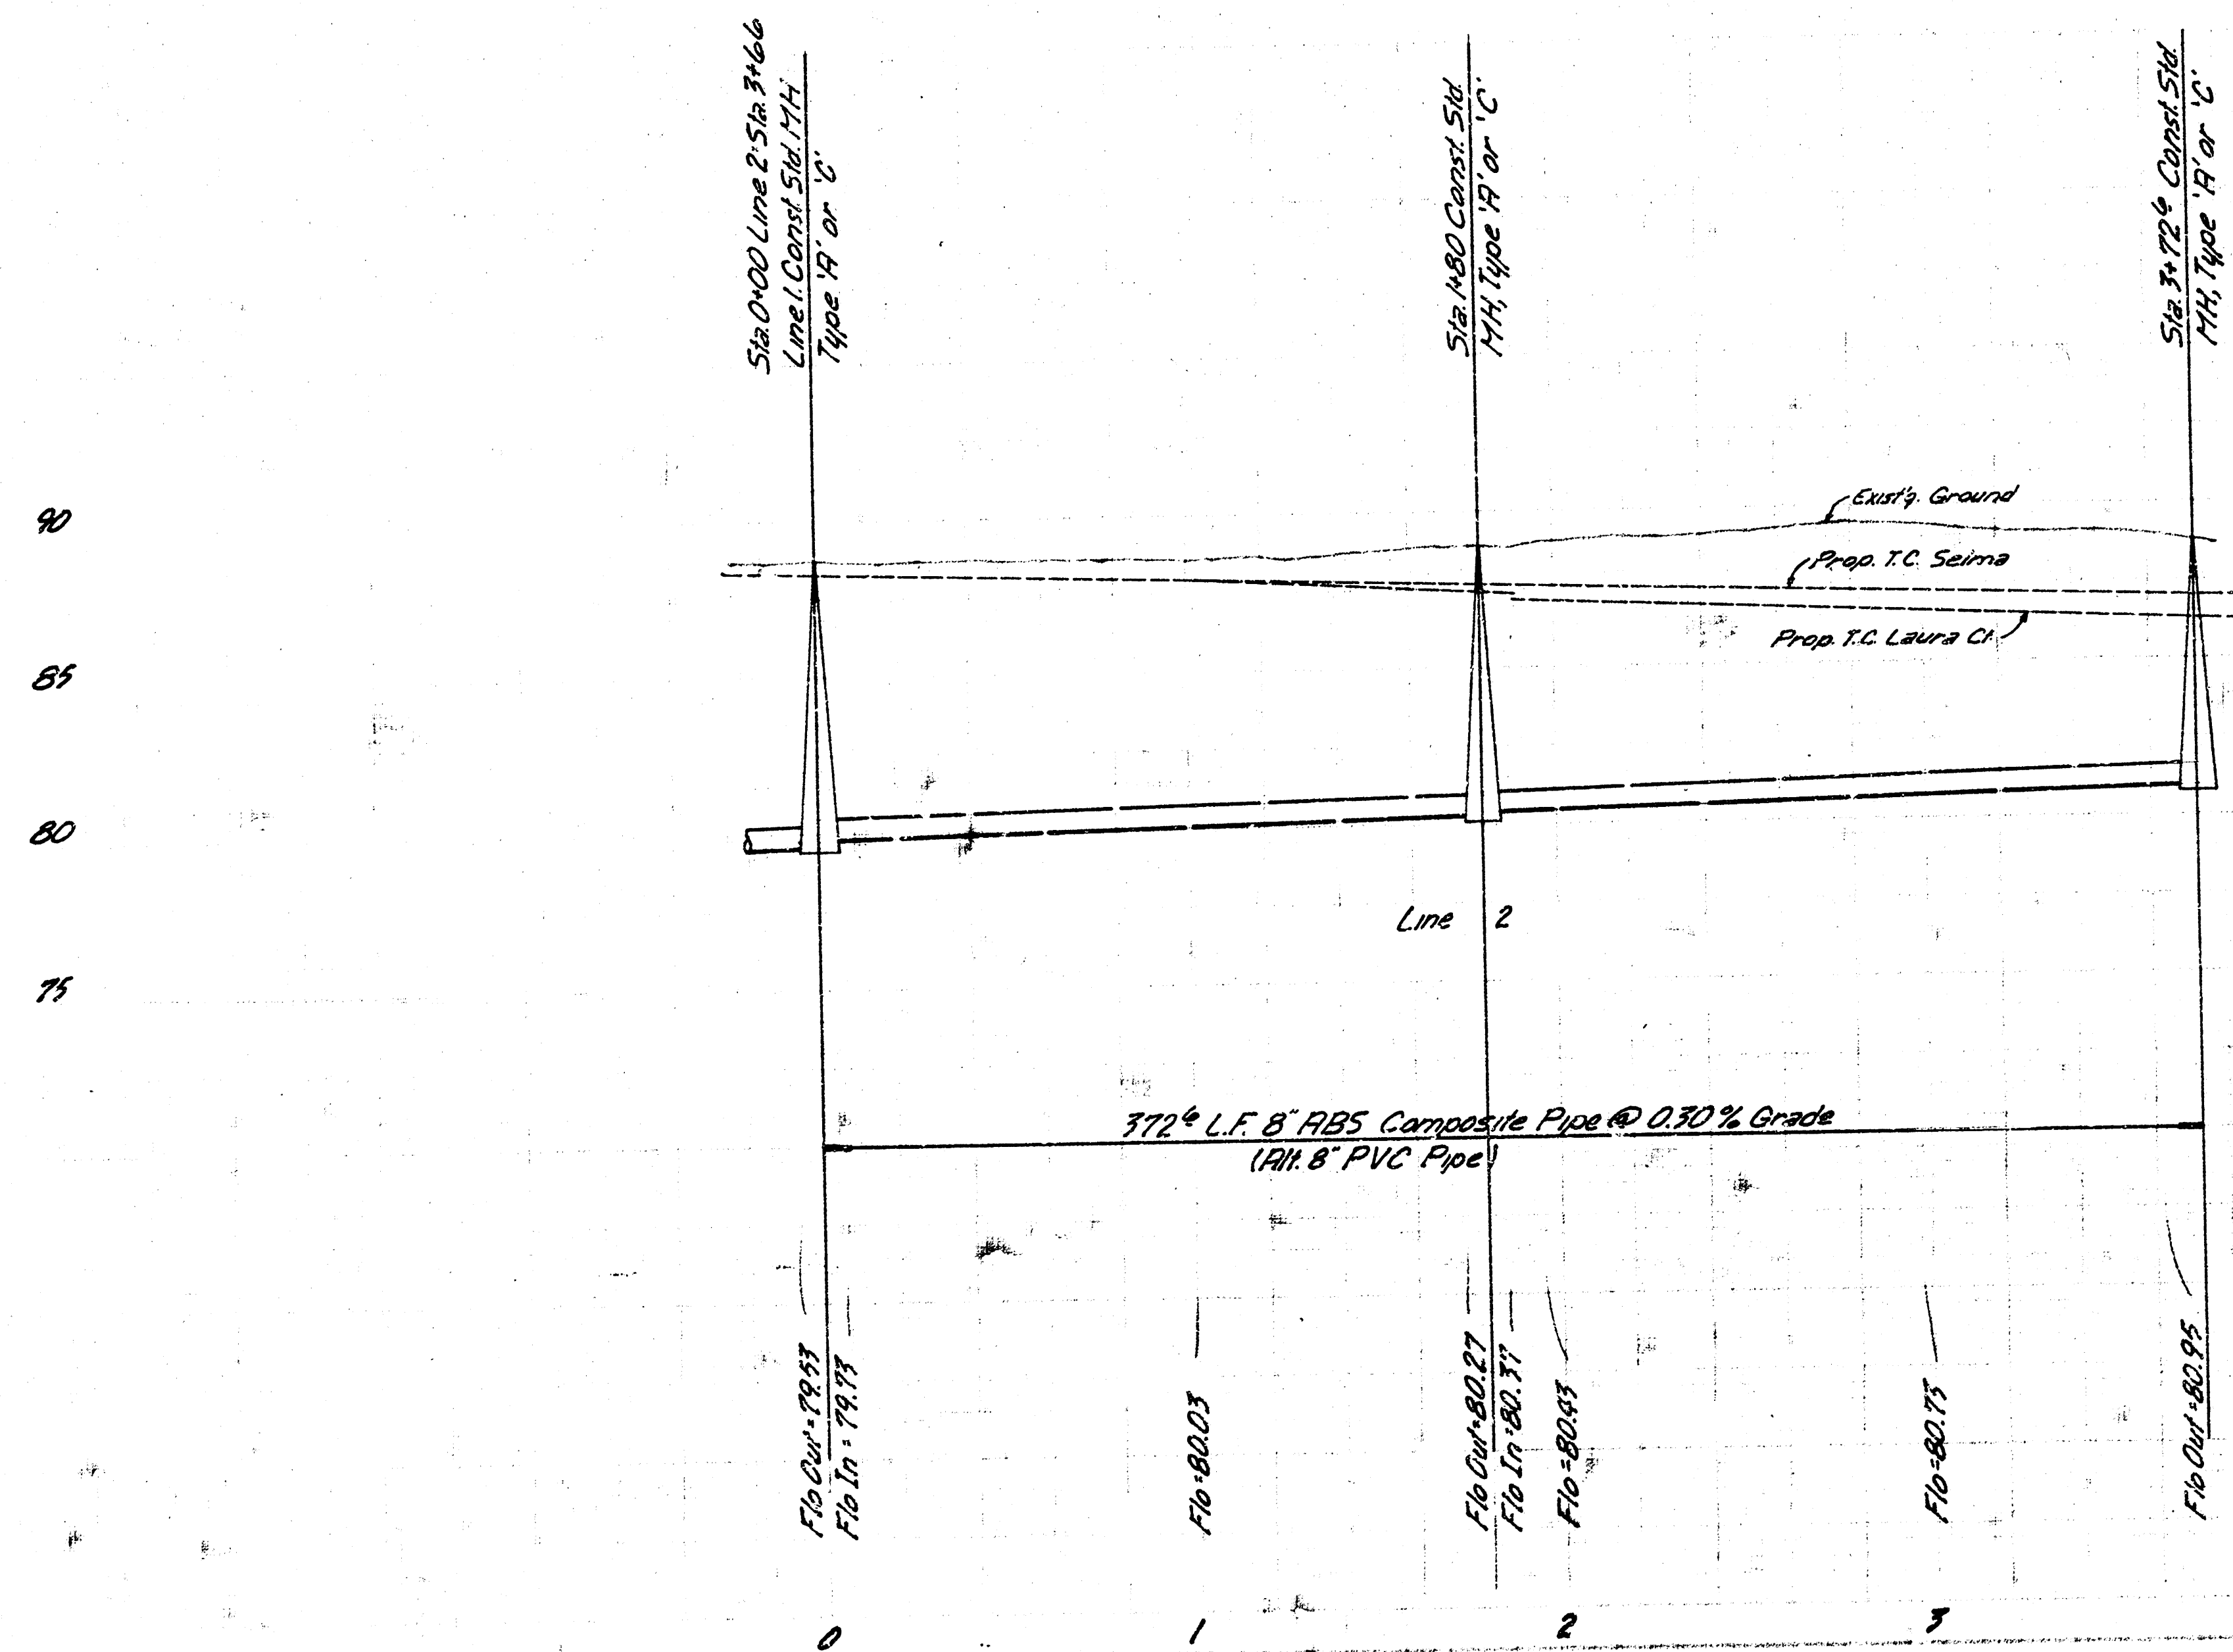

Line 2
Lat 90, Main, SW
3/3