



Plan Scale: 1" = 40'
Profile Scale: 1" = 40' Horiz.
1" = 5' Vert.

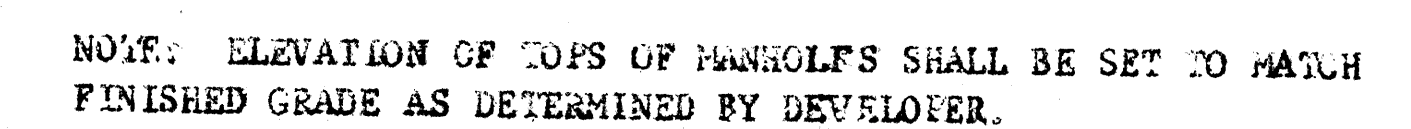

AD Bulet for 2/1/79
- T.D. 36
D 225 -

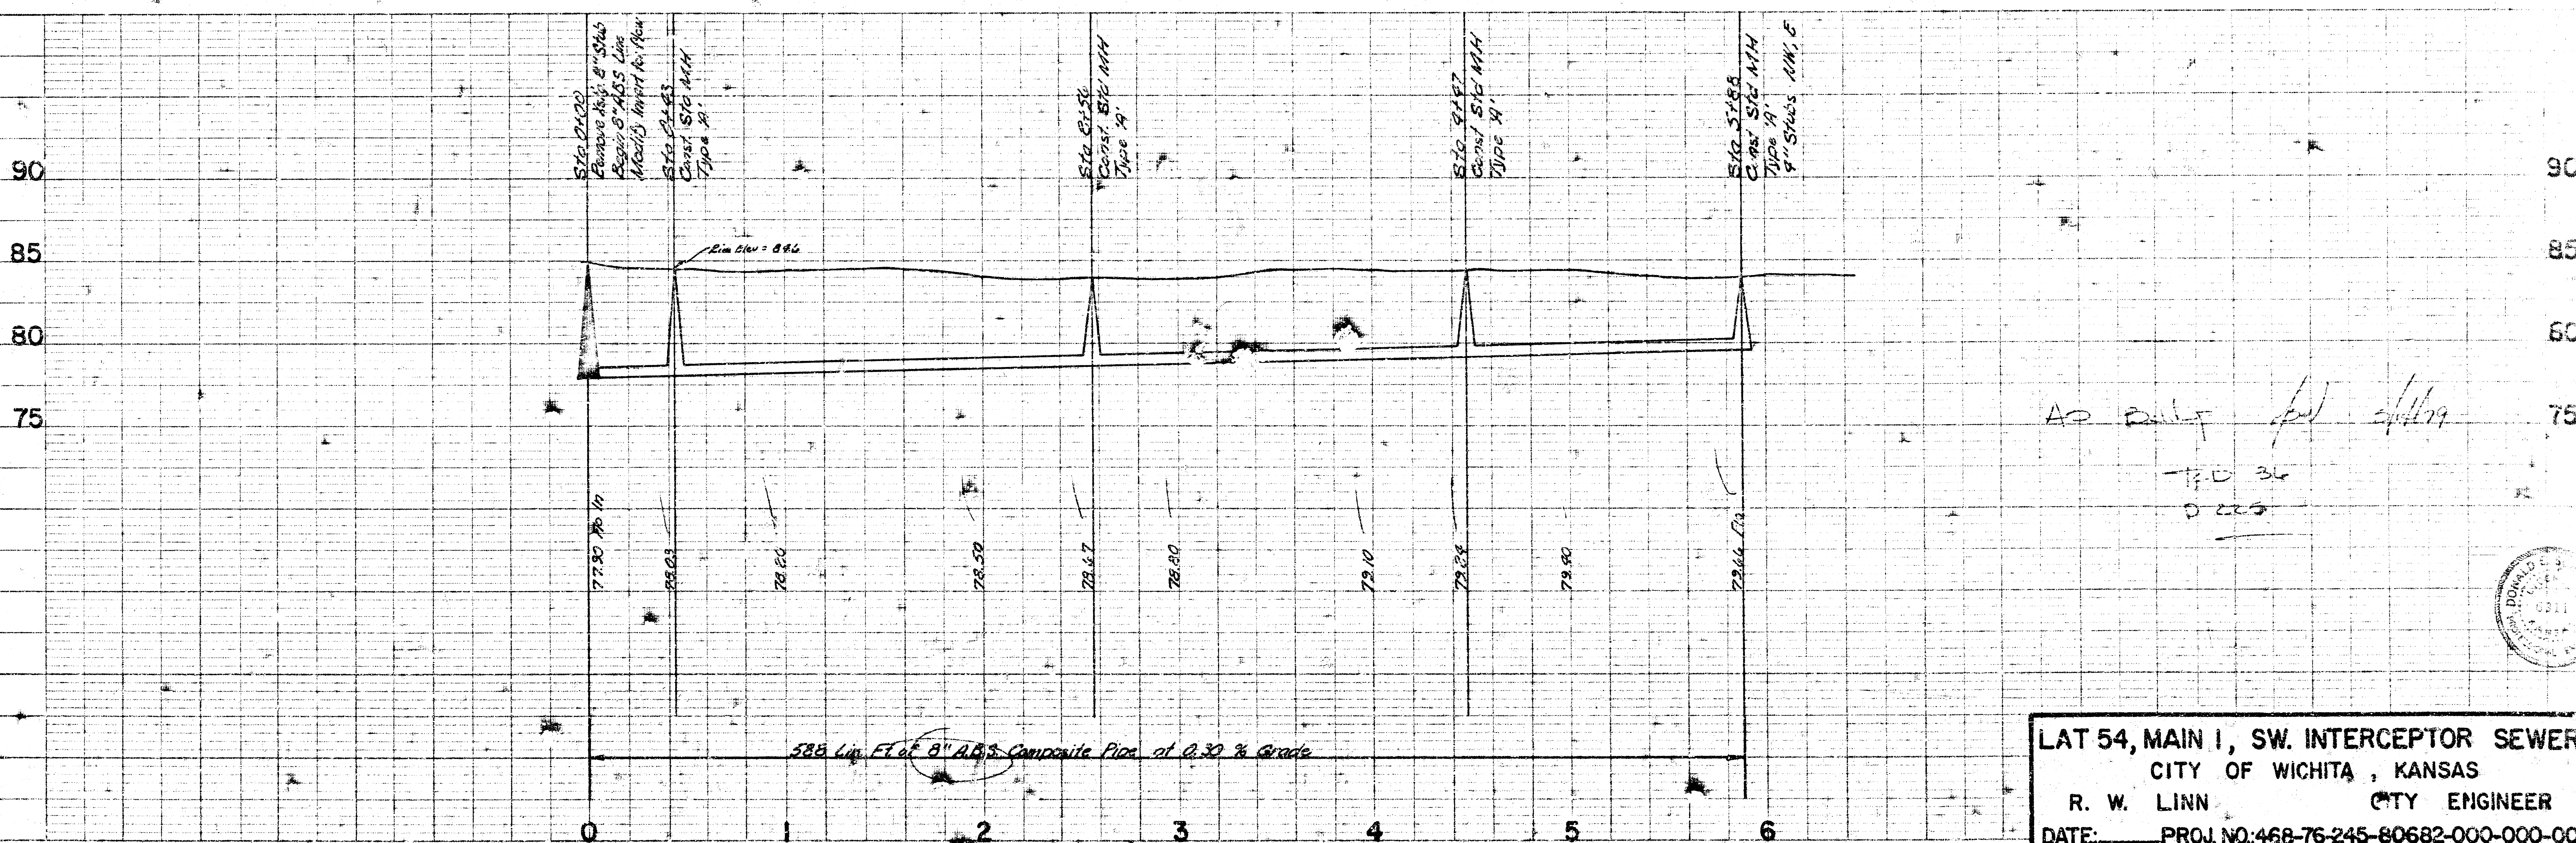

LAT 54, MAIN I, SW. INTERCEPTOR SEWER
CITY OF WICHITA, KANSAS
R. W. LINN **CITY ENGINEER**
DATE: _____ PROJ. NO. 468-76-245-80682-000-000-00