Scale Plan 1" = 40'
Profile 1" = 40' Horz.
1" = 5' Vert.

THE CONTRACTOR SHALL BE RESPONSIBLE FOR PRESERVING PROPERTY MONUMENTS. THE CONTRACTOR SHALL BE LIABLE TO RE-ESTABLISH ANY PROPERTY MONUMENTS THAT ARE DAMAGED OR DESTROYED DURING CONSTRUCTION OPERATIONS. SUCH MONUMENTS SHALL BE RE-ESTABLISHED BY A REGISTERED LAND SURVEYOR OR A QUALIFIED PROFESSIONAL ENGINEER IN ACCORDANCE WITH STATE LAWS.

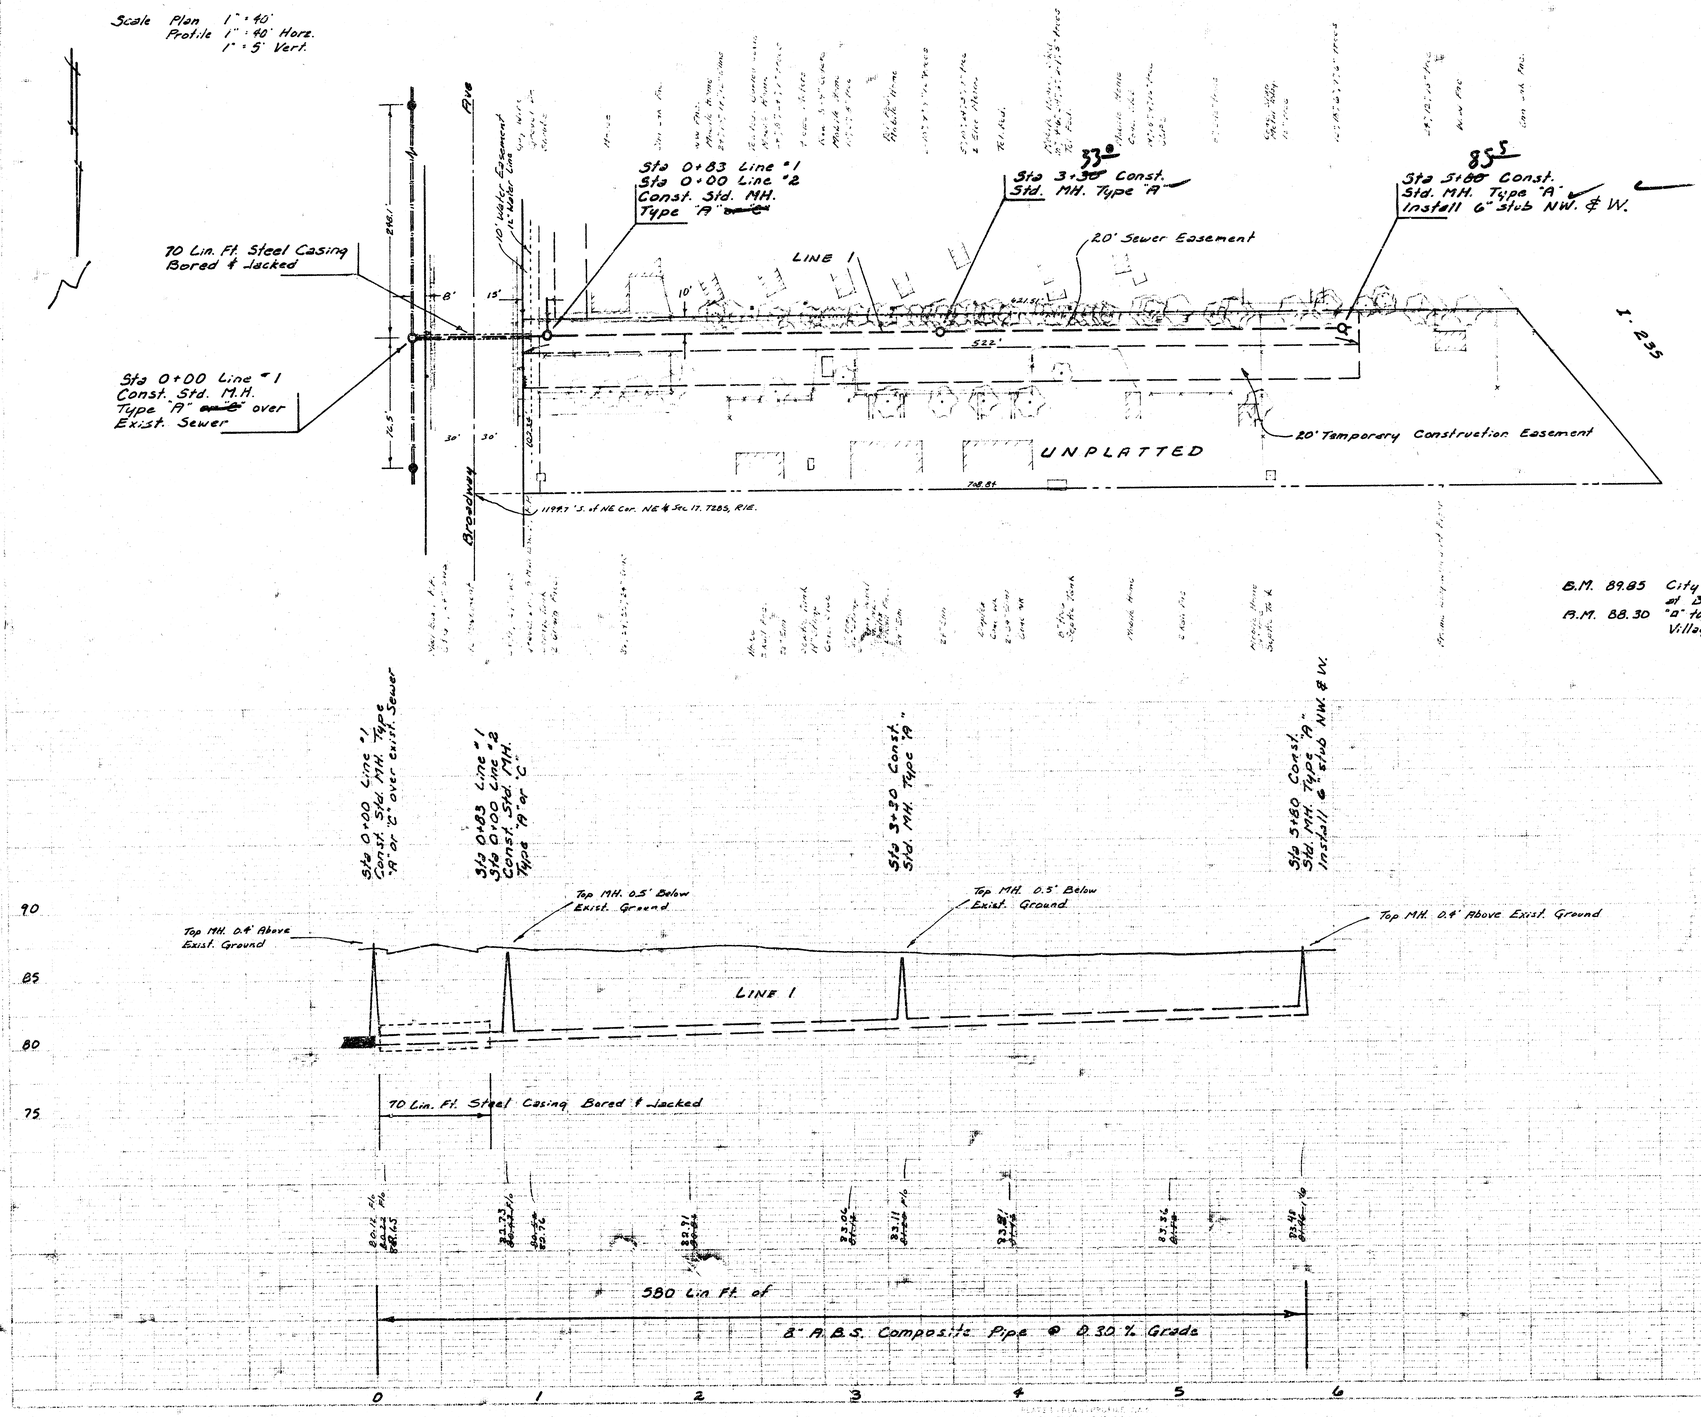

B.M. 89.85 City Std. 32' E. & 29' S. of the Section Corner at Broadway & MacArthur.
B.M. 88.30 "a" top SE corner concrete base for Bidwell Village sign, NW corner 43rd St. So & Broadway.

As Built
Odd
12/81

DONALD E. SCHNEIDER
LICENSED
6311
KANSAS
PROFESSIONAL ENGINEER

1/3

LAT 60, MAIN I, S.W. INTERCEPTOR
CITY OF WICHITA, KANSAS
R.W. BRUGGEMAN
DIRECTOR OF ENGINEERING / CITY ENGINEER
PROJ. NO. 468-76-245-81057-000-000-001

1/3

R. Krug
R. Loomis

KW-1
DLK 361

FILMED FROM THE BEST AVAILABLE COPY

Scale Plan 1" = 40'
Profile 1" = 40' Horz.
1" = 5' Vert.

1+01

Sta 0+00 Line #2
Sta 0+83 Line #1

Sta ~~0+96~~ Line 2
Sta 0+00 Line 3
Const. Std. MH.
Type "A" ✓

1+64

Sta ~~2+44~~ Line 2
Sta 0+00 Line 4
Const. Std. MH.
Type "A" ✓

7+79

Sta ~~3+81.4~~ Const. Std. ✓
M.H. Type "A" ✓
Install 6" stub W. & S.W. ✓

Broadway

Ave

Sewer Easement

10' Water Easement

12" Water Line

LINE 2

Temporary Construction Easement

NOTE: Mobile Home to be temporarily relocated by the property Owner.

UNPLATTED

I-235

1320.04' S. of NE Cor. NE¼, Sec. 17, T2S., R1E

Sta 0+00 Line 2
Sta 0+83 Line 1

Sta 0+96 Line 2
Sta 0+00 Line 3
Const. Std. MH.
Type "A".

Sta 2+11.4 Line 2
Sta 0+00 Line 4
Const. Std. MH.
Type

Sta 3+71.4 Const.
Std. MH. Type "A".
Install 6" Stub W. & S.W.

top MH. 0.5' below Exist. Ground

top MH. @ Exist. Pavement

top MH. 0.5' below Exist. Ground

top MH. @ Exist. Pavement

LINE 2

90
85
80
75

371.4 Lin. Ft. of 8" A.B.S. Composite Pipe @ 0.30 % Grade

0 1 2 3 4

Sta 0+00 Line 3
Sta 0+96 Line 2

10' Water Easement

Temporary Construction Easement

Sta 2+30 Const.
Std. MH. Type "A"

6+32

Sta 6+~~80~~ Const. ✓
Std. MH. Type "A" ✓
Install 6" Stub W. & N.W. ✓

UNPLATTED

LINE 3

20' Sewer Easement

297.06' S. of NE Cor. NE¼, Sec. 17, T2S., R1E

10' Sewer Easement

Sta 0+00 Line 3
Sta 0+96 Line 2

Sta 2+30 Const.
Std. MH. Type "A"

Sta 6+32 Const.
Std. MH. Type "A".
Install 6" Stub W. & N.W.

Top MH. @ Exist. Pavement

Top MH. 0.5' Below Exist Ground

Top MH. 0.9' Above Exist. Ground

LINE 3

90
85
80
75

462 Lin. Ft. of 8" A.B.S. Composite Pipe @ 0.30 % Grade

0 1 2 3 4 5

As Built
Jdd
12/81

LAT 60. MAIN 1. SWI
468-76 295-81037-000-000-001

2/3
2/3

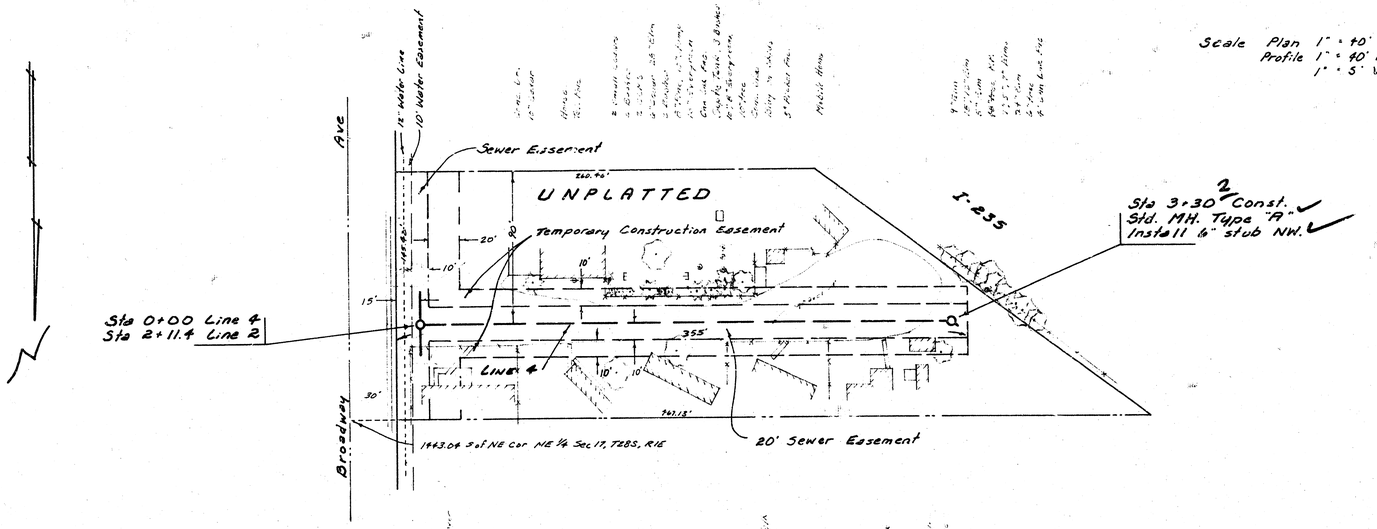

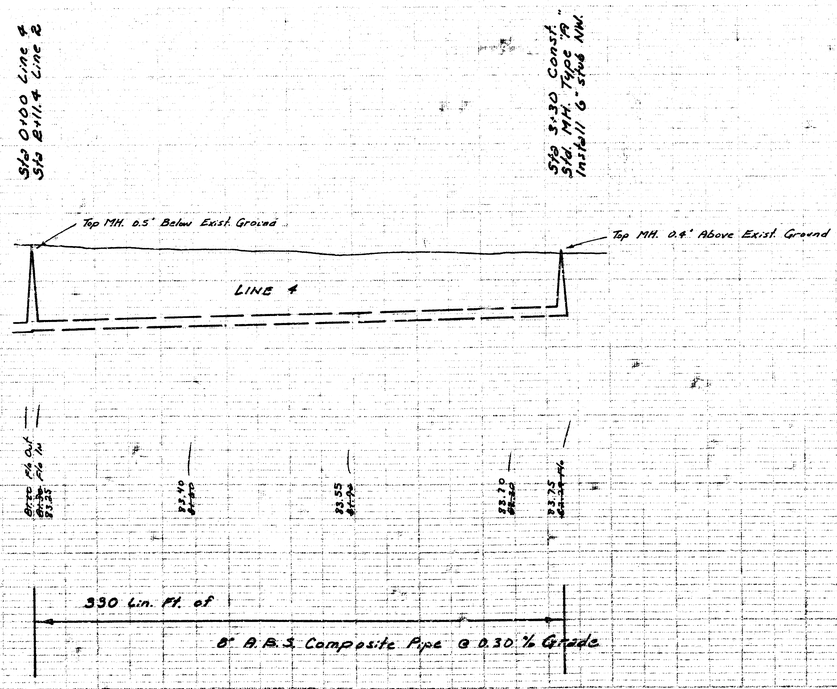

As Built
ddd
12/8/

LAT. 60, MAIN 1, SM 1
468-76-245-81057-000-000-001

3/3