


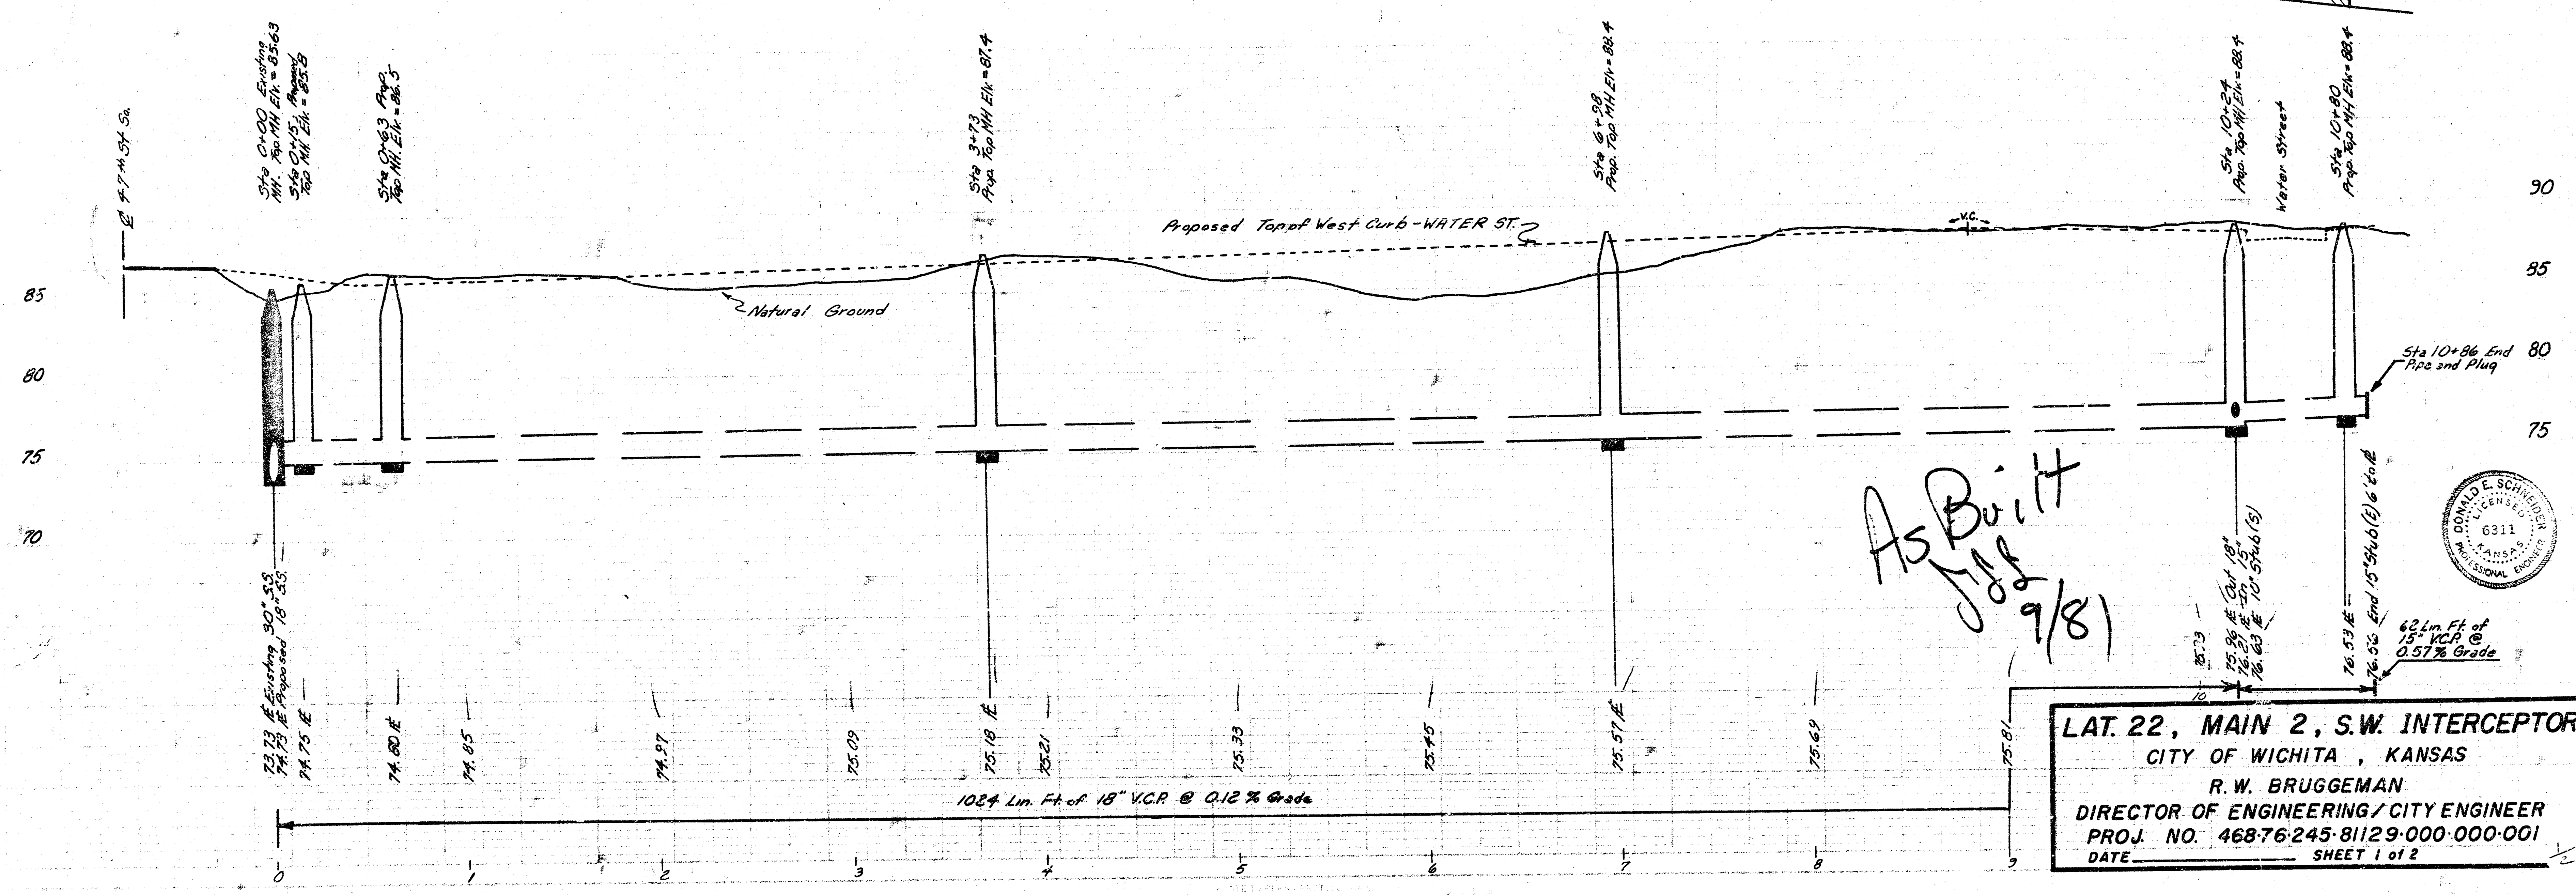
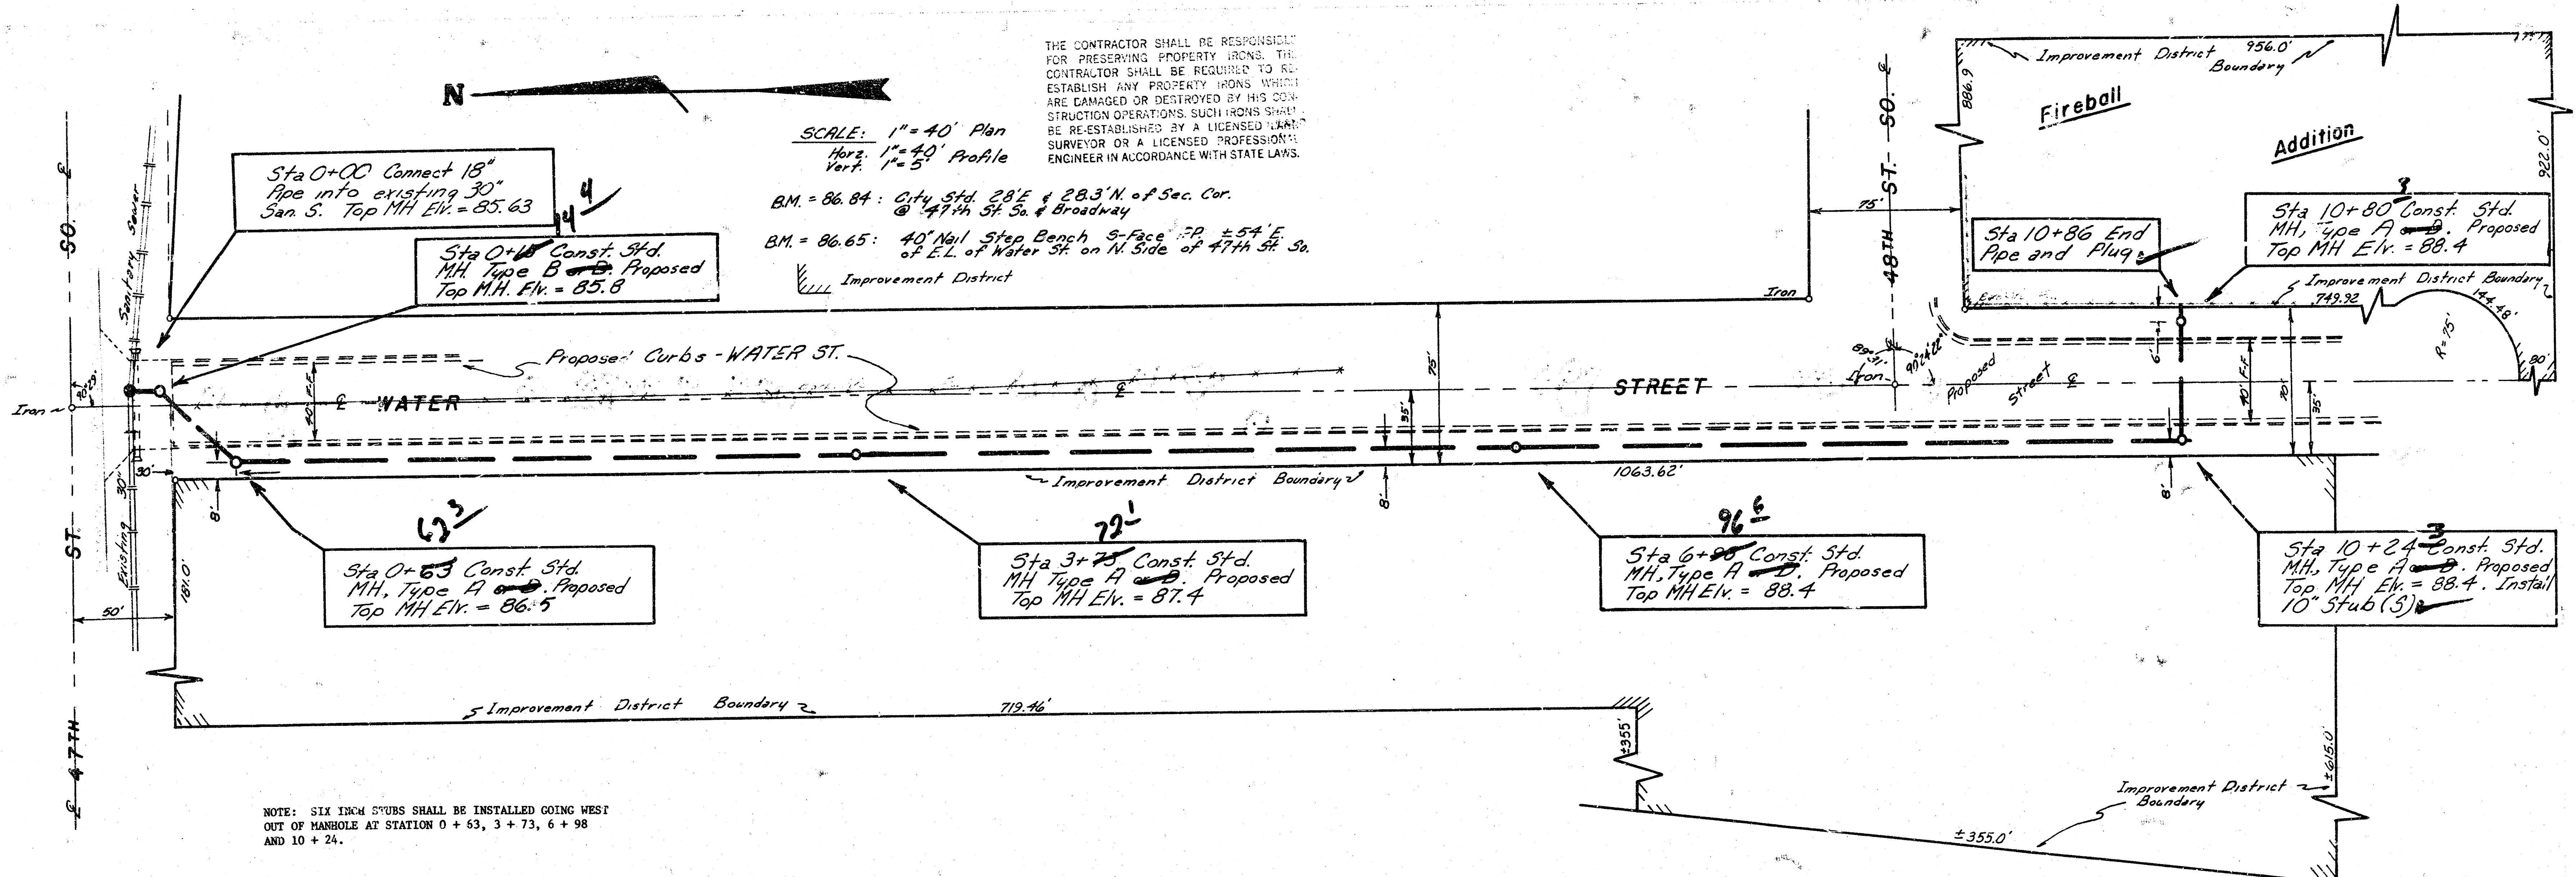
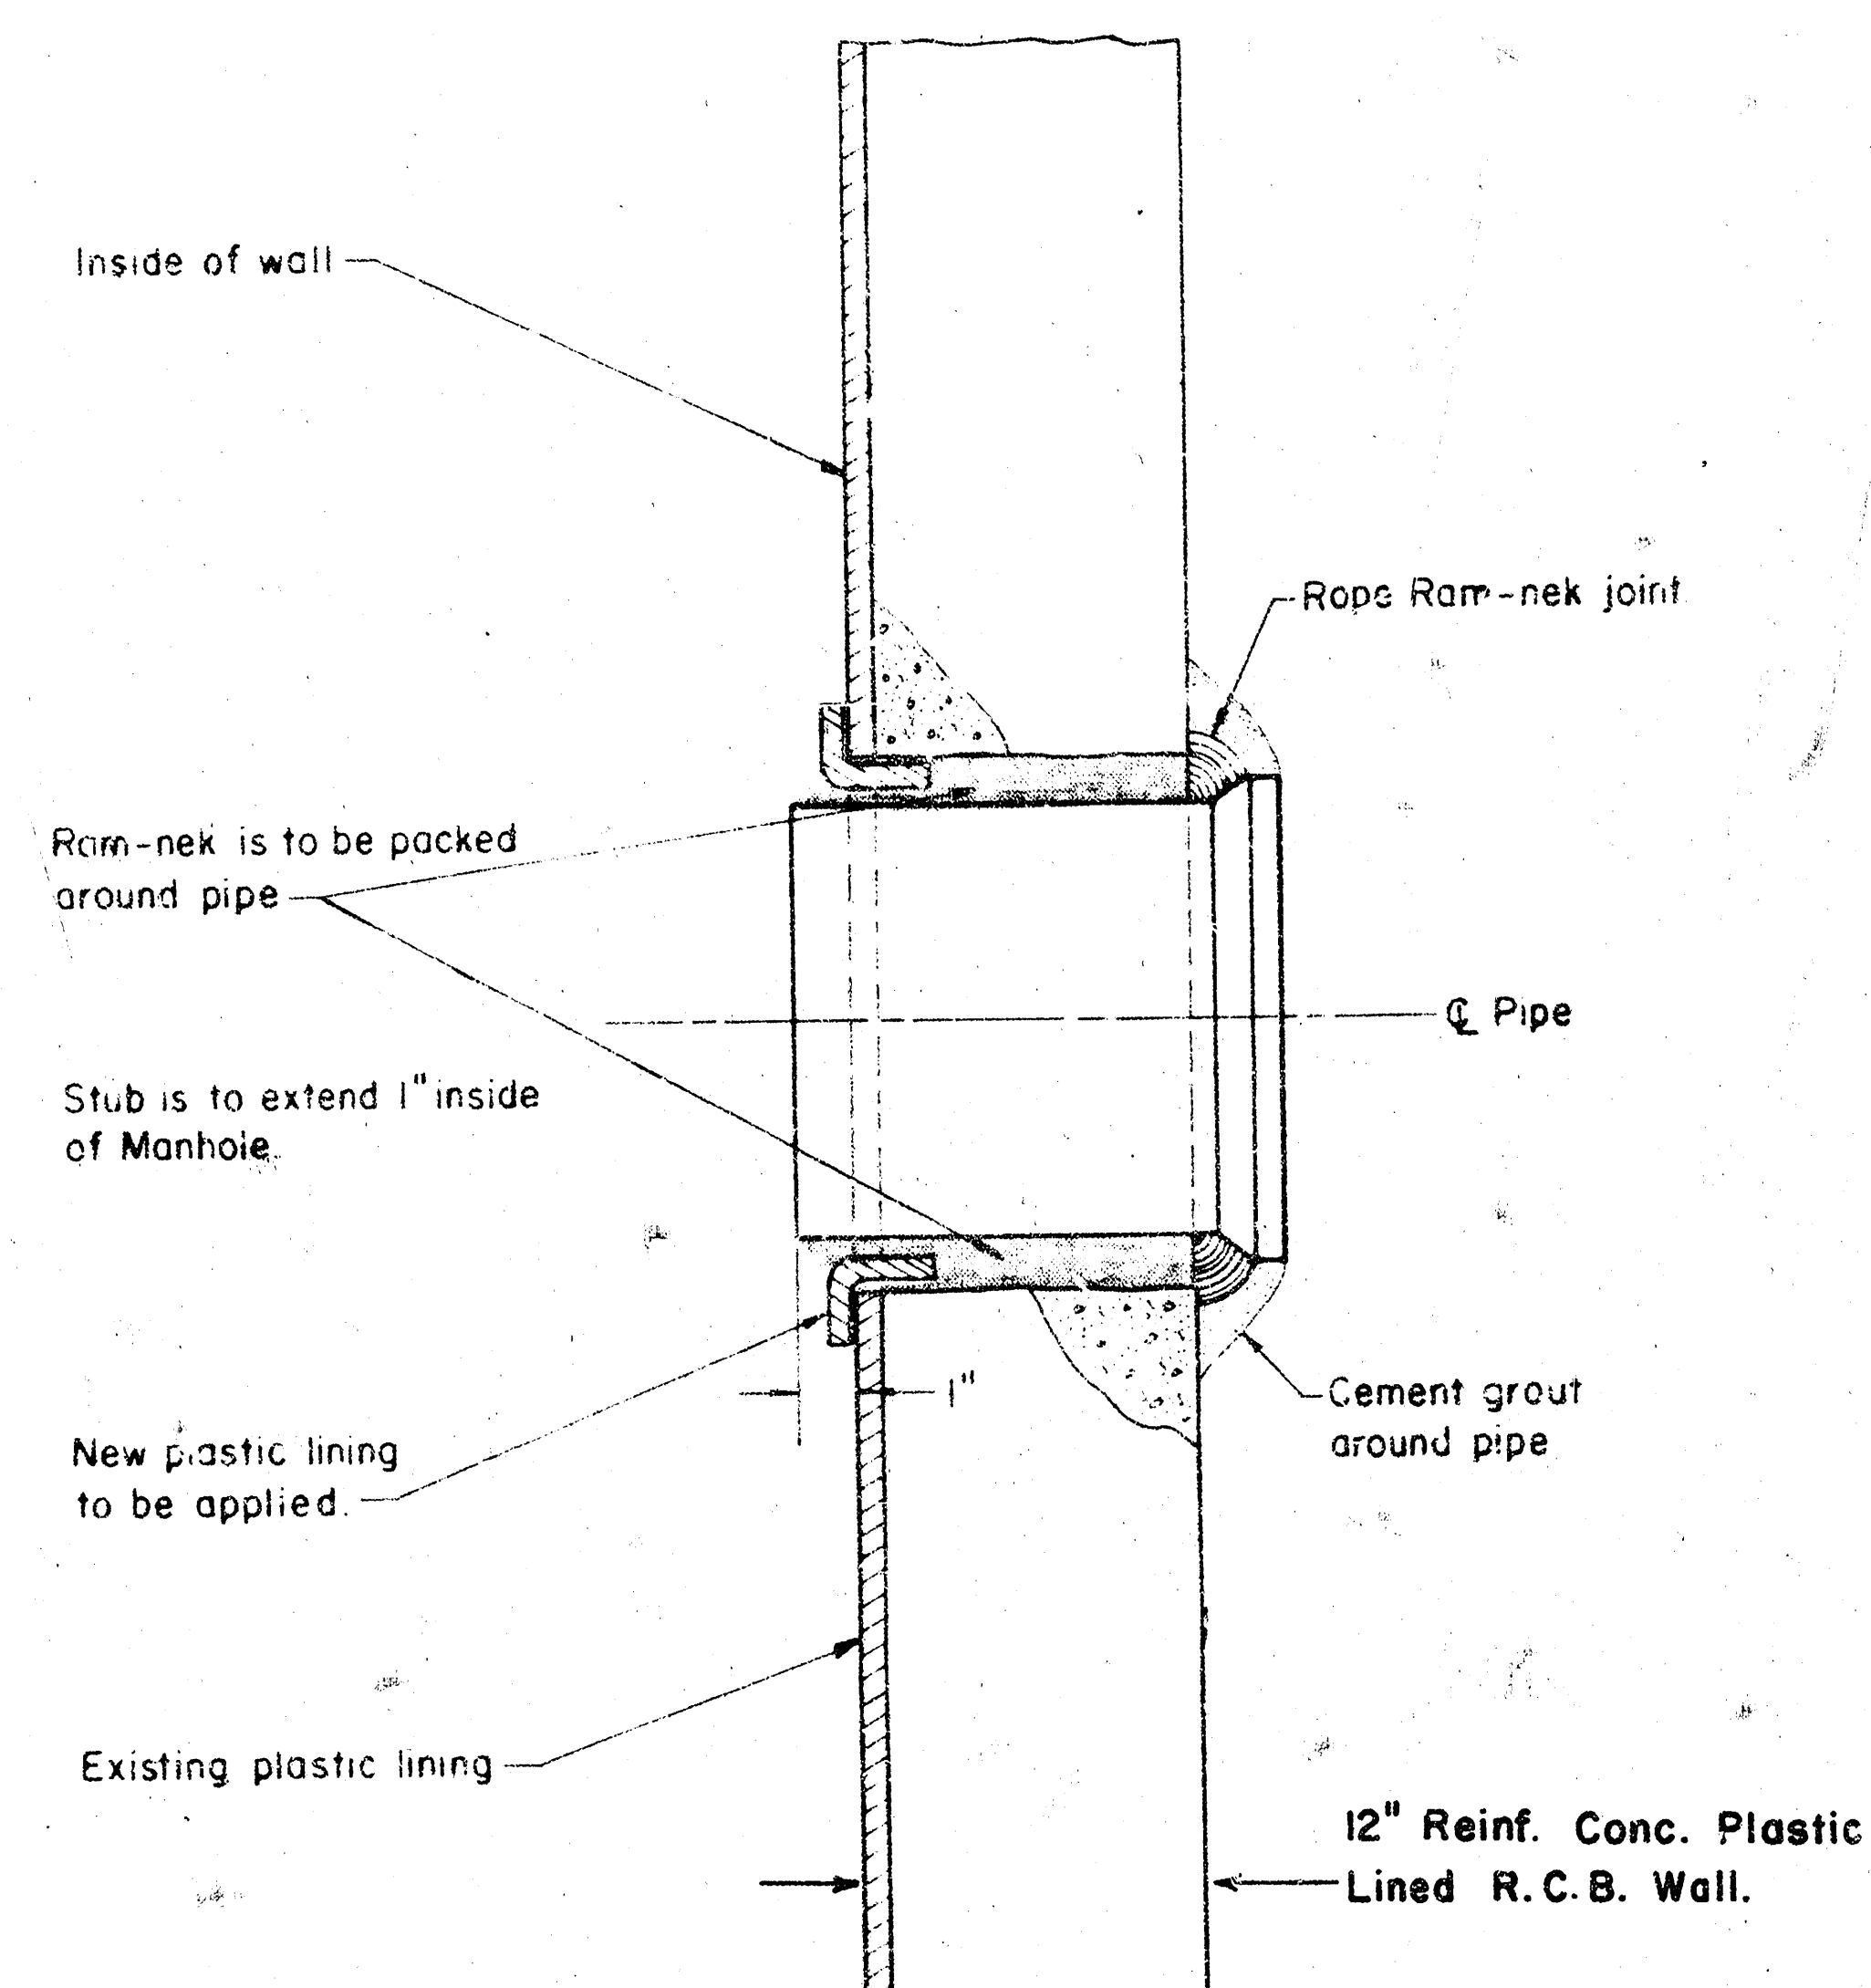


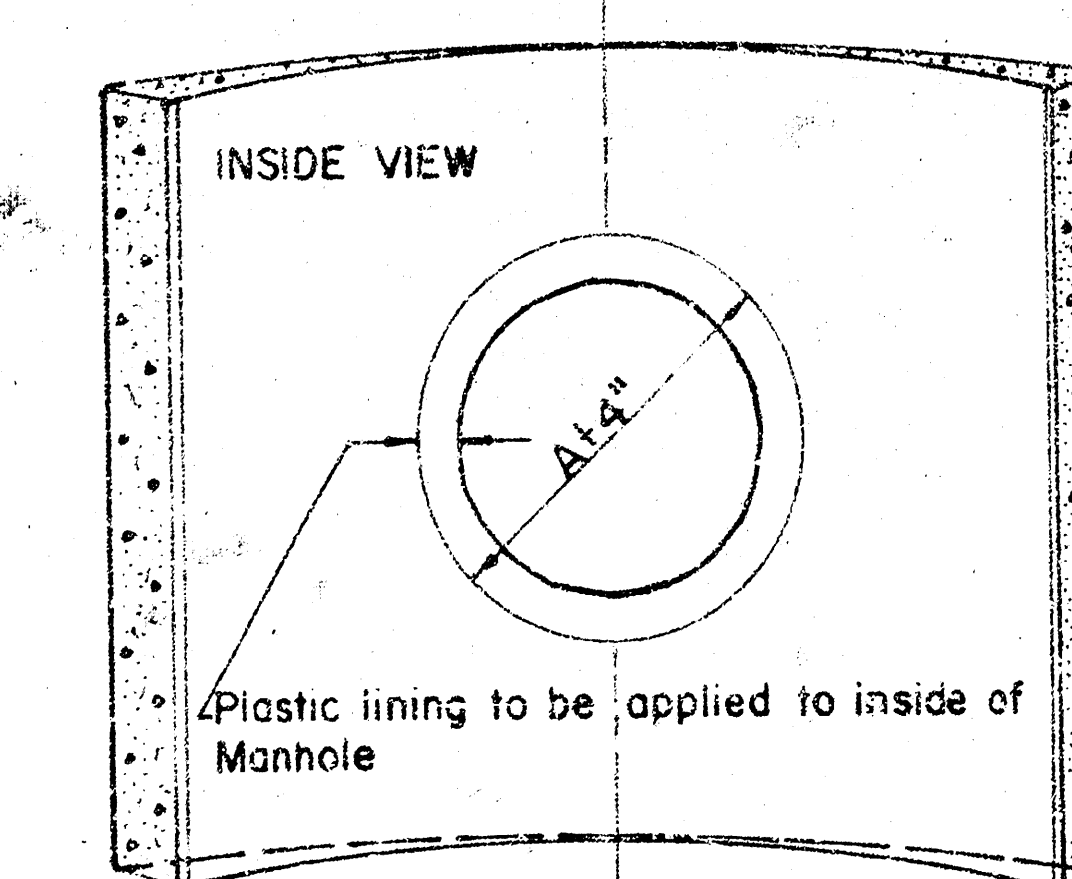

LAT. 22, MAIN 2, S.W. INTERCEPTOR
 CITY OF WICHITA, KANSAS
 R. W. BRUGGEMAN
 DIRECTOR OF ENGINEERING / CITY ENGINEER
 PROJ. NO. 468-76-245-81129-000-000-001
 DATE _____ SHEET 1 of 2

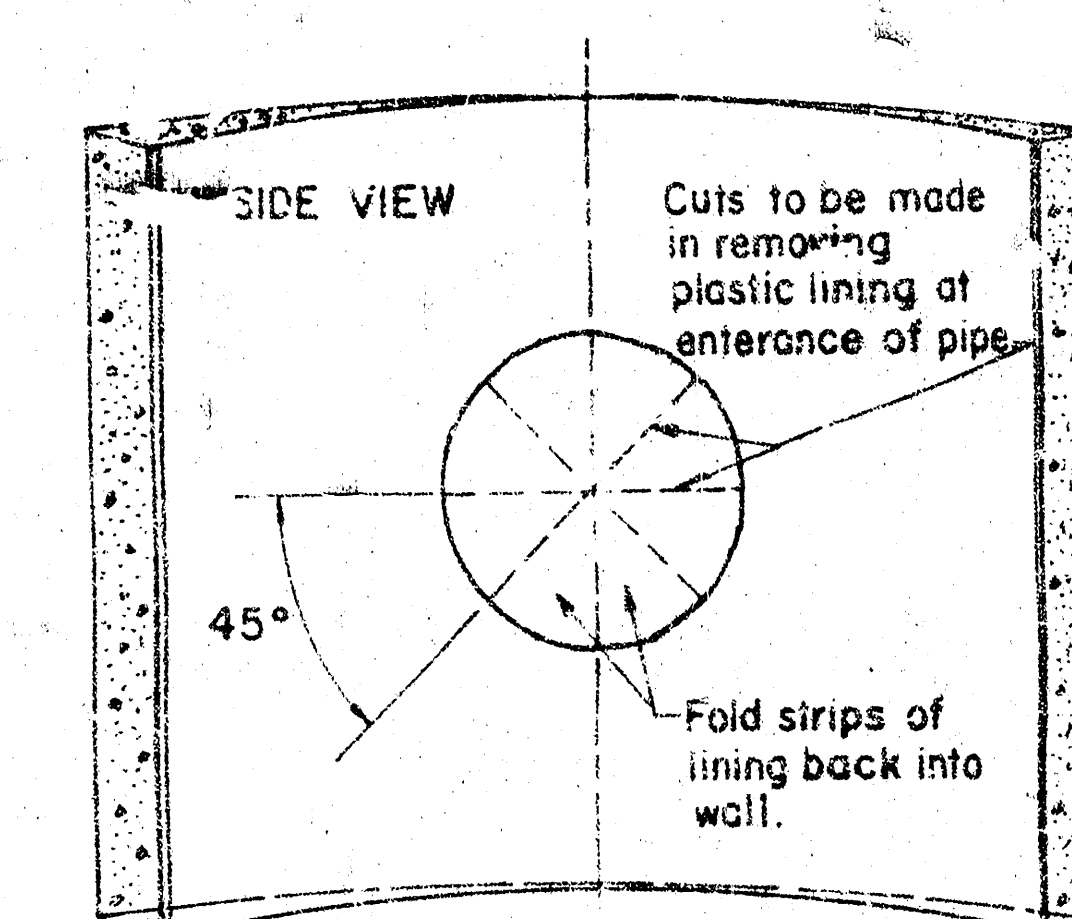

NOTE: DRAWING DEPICTS CONNECTION TO STRUCTURAL TEE MANHOLE BUT THESE SAME REQUIREMENTS ARE TO APPLY TO CONNECTION TO BE MADE TO THE PLASTIC LINED REINFORCED CONCRETE BOX MANHOLE AT STATION 0 + 00.

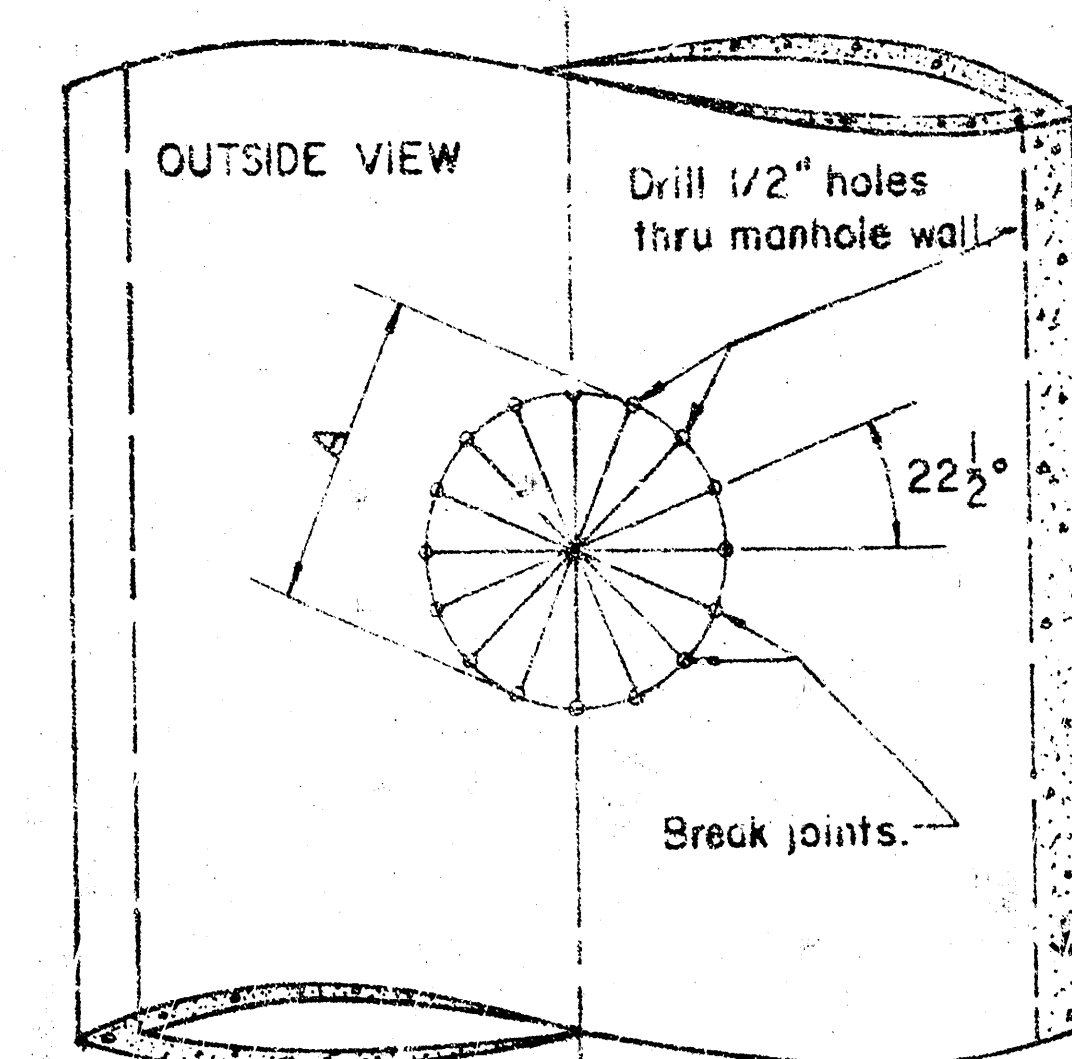

A = OUTSIDE DIAMETER OF PIPE + 2"

DRAWN: Oct. 1978

DETAIL OF PIPE CONNECTION
TO STRUCTURAL TEE MANHOLE
CITY OF WICHITA, KANSAS
LAT. 22, MAIN 2, S.W. INTERCEPTOR
PROJECT NUMBER: 468-76-245-81129-000-001
DATE: SHEET 2 of 2

FILMED FROM THE BEST
AVAILABLE COPY