

B.M. 92.23 "X" in conc. on S-end of wing wall 3' N. end of bridge span on W-side of Seneca & Carey Lane.

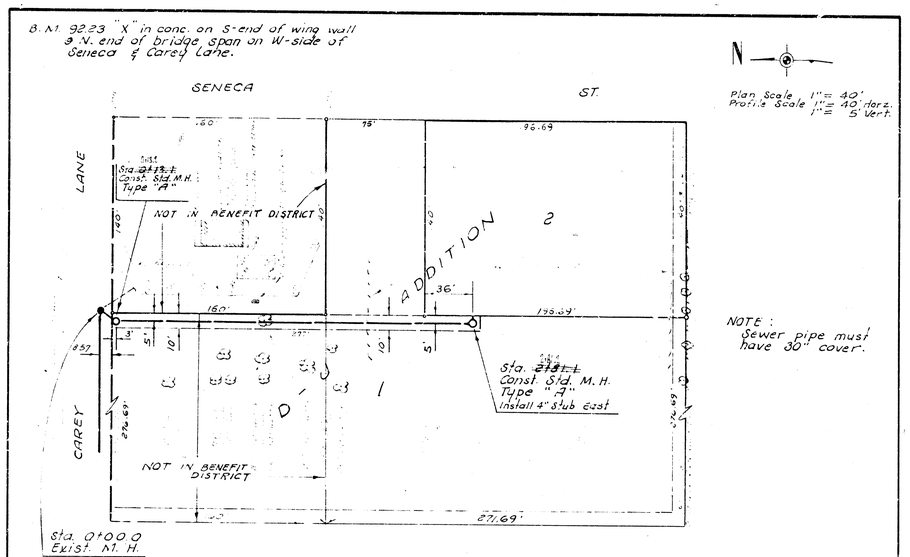

Plan Scale 1" = 40'
Profile Scale 1" = 40' Horz.
1" = 5' Vert.

NOTE:
Sewer pipe must have 30" cover.

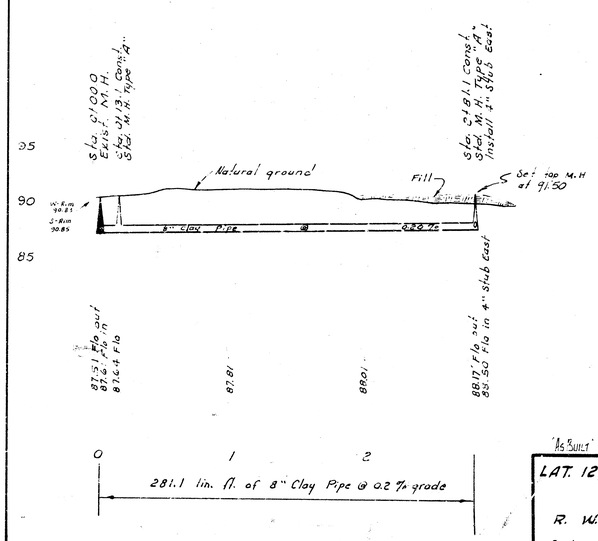

"As Built" final measurements by S.S. & W.J.K.

DEAN S. SELLERS
LICENSED
3683
KANSAS
PROFESSIONAL ENGINEER

LAT. 12, MAIN 3, S.W. INTERCEPTOR SEWER
CITY OF WICHITA, KANSAS
R. W. LINN — CITY ENGINEER
Sept. 1972 PROJECT NO. DBKL572039

123 S.W.S.

Checked by [illegible]

14 4 5 12