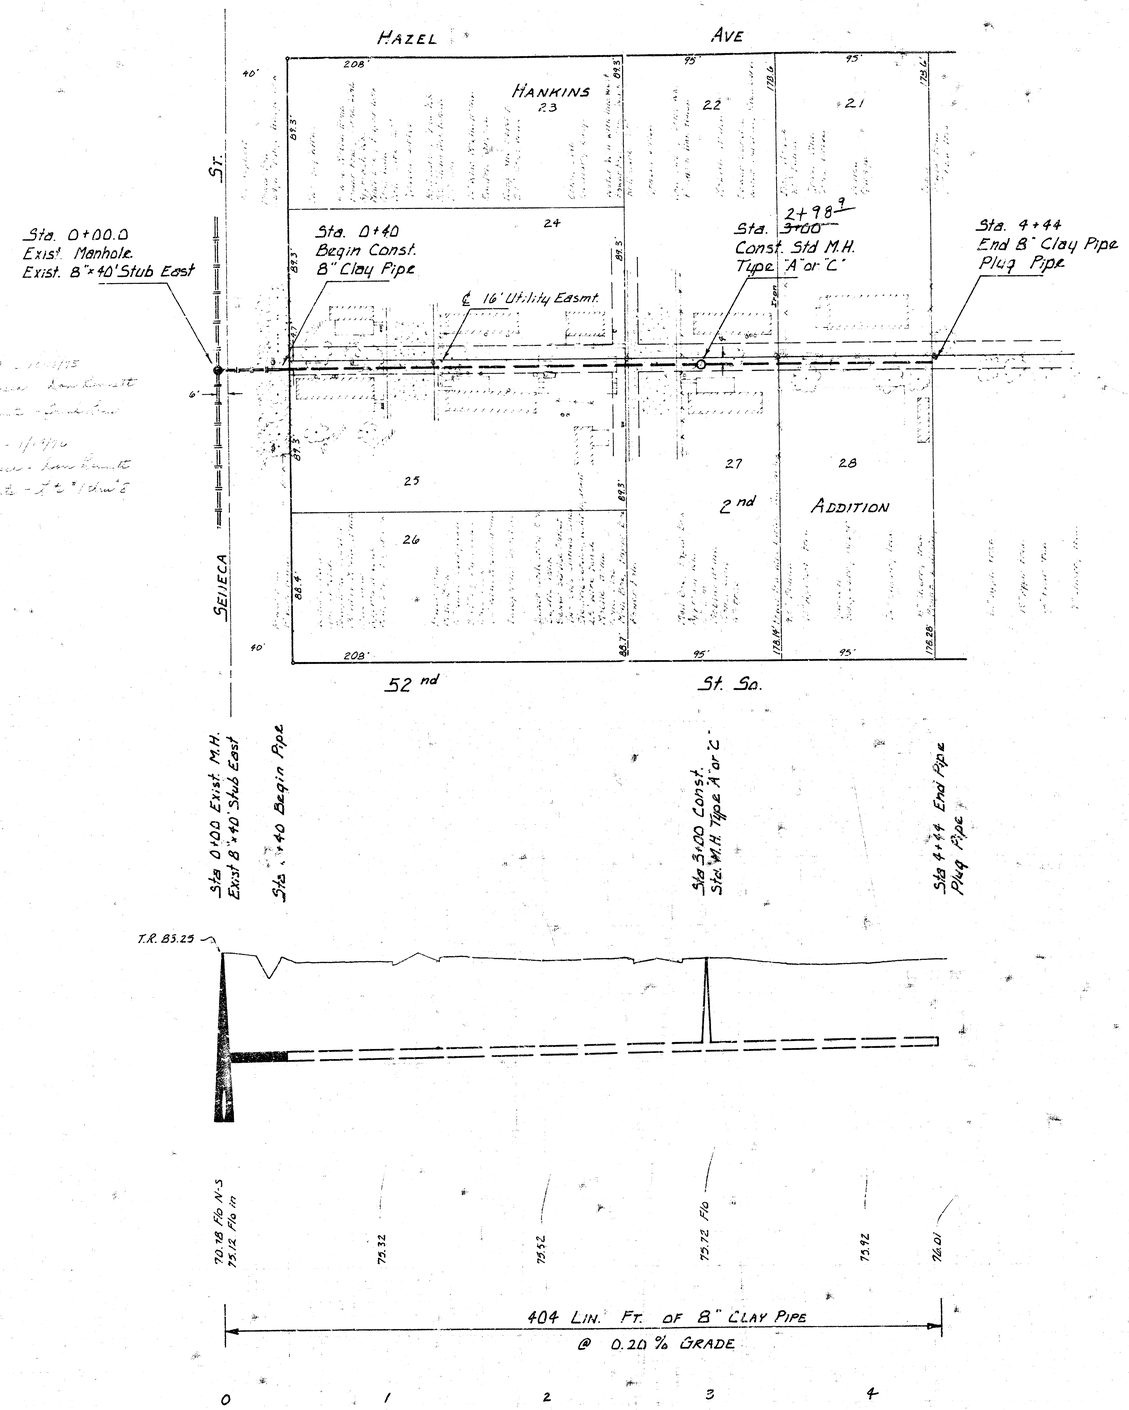

Plan Scale 1" = 40'
Profile Scale 1" = 40' Horz.
1" = 5' Vert.

B.M. 82.97 R.R. spike E. face Power Pole NW corner Seneca & 51st St So.
B.M. 80.72 City Std. disc 30' S. and 45' E. of ℄ of Seneca & 55th St So.

GENERAL NOTE

PRIVATE UTILITIES MAY BE LOCATED ON UTILITY EASEMENT. CONTRACTOR SHALL BE REQUIRED TO REMOVE PRIVATE UTILITIES AS REQUIRED TO CONSTRUCT THE SEWER. PRIVATE UTILITIES WILL BE REPLACED BY OWNER OF MOBILE HOME COURT. MOBILE HOME ON SOUTH SIDE OF PROPOSED SEWER BETWEEN STA. 0+50 and STA. 1+00 WILL BE MOVED BY THE OWNER OF THE COURT TO FACILIATE CONSTRUCTION OF THE SEWER. CONTRACTOR MUST CONTACT MANAGER OF MOBILE HOME COURT AND MAKE ARRANGEMENTS FOR TEMPORARY RELOCATION OF SAID MOBILE HOME PRIOR TO CONSTRUCTION OF THE SEWER.

DONALD E. SCHNEIDER LICENSED 6311 KANSAS PROFESSIONAL ENGINEER

As Built 1-29-76

LAT 15, MAIN 3, S.W.I.
CITY OF WICHITA, KANSAS
R. W. LINN — CITY ENGINEER
Aug-75 PROJECT NO. DBKL575020

1/1