B.M. 83.30 NE Corner of Conc. porch @ House # 5319 S. Osage

B.M. 81.19 R.R. Spike in S. side of L.P. on the W. corner of the intersection of Lockwood St. & Southwind St.

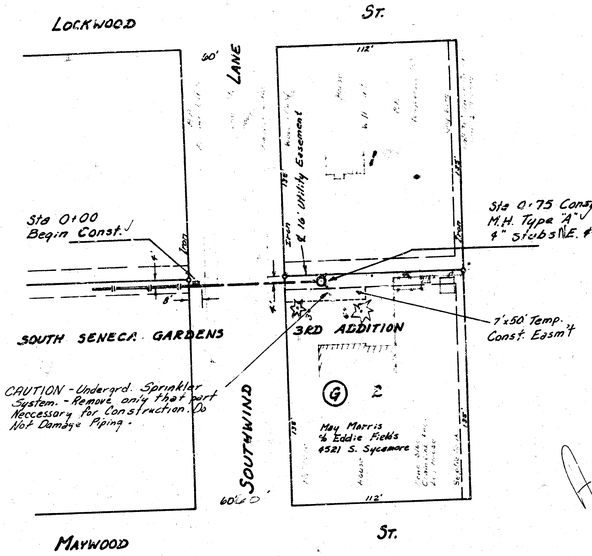

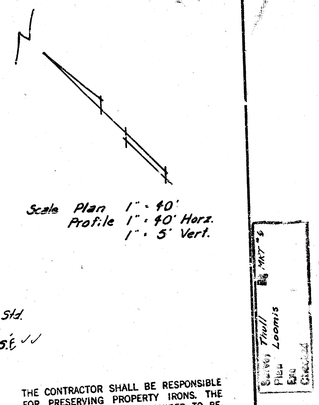

THE CONTRACTOR SHALL BE RESPONSIBLE FOR PRESERVING PROPERTY IRONS. THE CONTRACTOR SHALL BE REQUIRED TO RE-ESTABLISH ANY PROPERTY IRONS WHICH ARE DAMAGED OR DESTROYED BY HIS CONSTRUCTION OPERATIONS. SUCH IRONS SHALL BE RE-ESTABLISHED BY A LICENSED LAND SURVEYOR OR A LICENSED PROFESSIONAL ENGINEER IN ACCORDANCE WITH STATE LAWS.

As Built J.L. 4/83

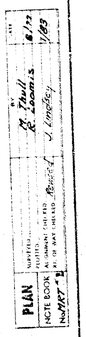

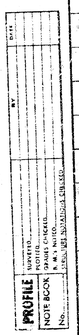

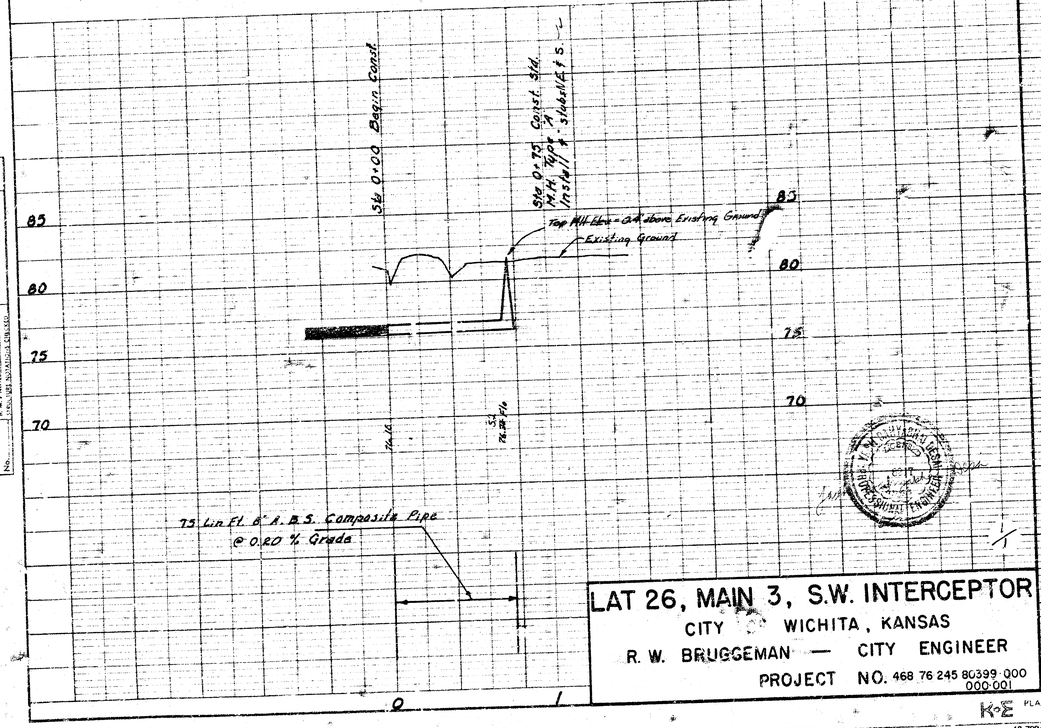

LAT 26, MAIN 3, S.W. INTERCEPTOR
CITY OF WICHITA, KANSAS
R. W. BRUGGEMAN — CITY ENGINEER
PROJECT NO. 468 76 245 80399 000 000-001

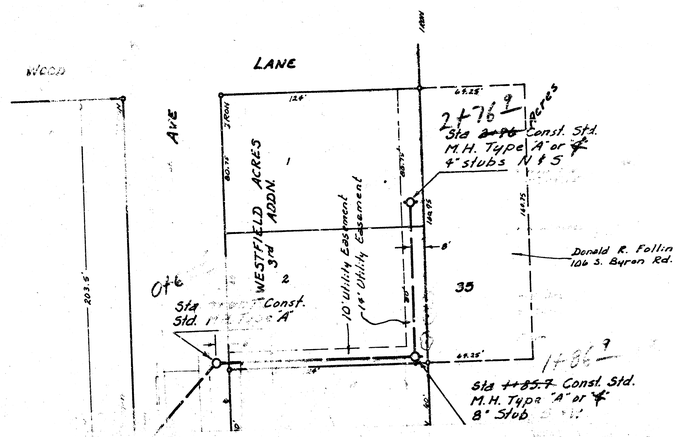

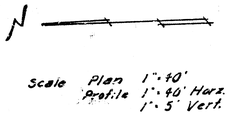

B.M. 143.91 City Std Disc. 34.2' E & 27.2' S of ℄ of Tyler Road & Maple

B.M. 195.04 R.R. Spike in SE side P.P. approx. 75' W. & 5' N. of the intersection of the ℄ Wood St. & N. edge of Douglas.

FROM BLUE PRINTS

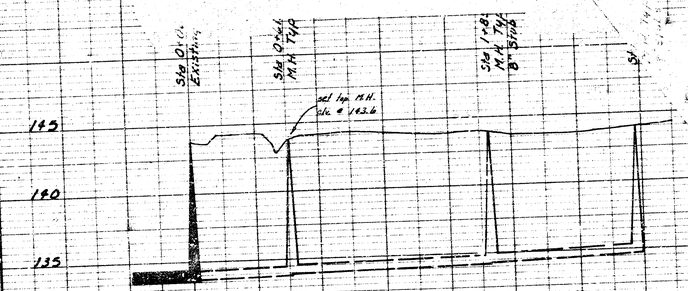

As Built 4-27-78

LAT 15, MAIN 1, WESTLINK SEWER
CITY OF WICHITA, KANSAS
R. W. LINN — CITY ENGINEER
PROJECT NO. DB[illegible]7522



K&E PLATE 1, PLAN-PROFILE KEUFFEL & ESSER CO. 48 7024 MADE IN U.S.A.

14 3 1 12

FILMED FROM THE BEST AVAILABLE COPY