NOTE: EXISTING PAVEMENT IS TO BE REMOVED FULL WIDTH BETWEEN COMBINED CURB AND GUTTER IN THE AREA OF SEWER CONSTRUCTION ON 46TH STREET SOUTH. EXISTING PAVEMENT SHALL BE RECONSTRUCTED AS 8" ASPHALT PAVEMENT WITH 6" BITUMINOUS BASE.

Scale Plan 1" = 40'
Profile 1" = 40' Horz.
1" = 5' Vert.

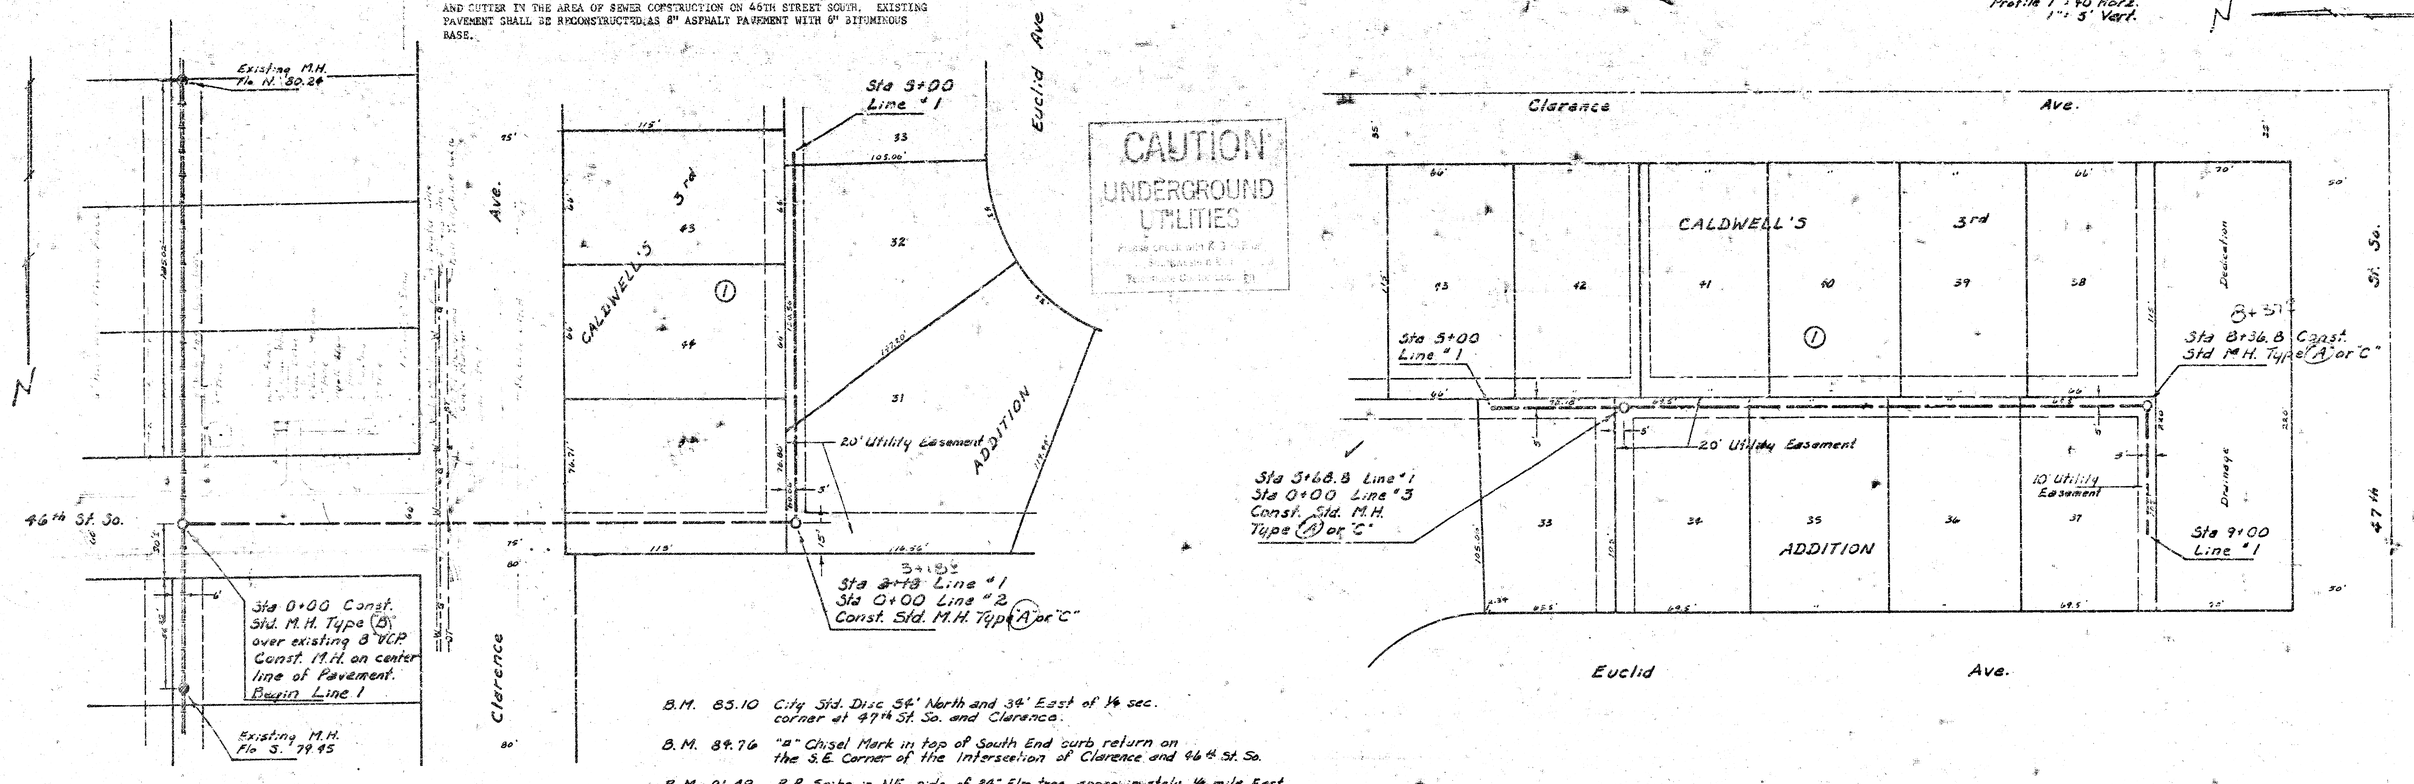

B.M. 85.10 City Std. Disc 54' North and 34' East of ¼ sec. corner at 47th St. So. and Clarence.

B.M. 84.76 "□" Chisel Mark in top of South End curb return on the S.E. Corner of the Intersection of Clarence and 46th St. So.

B.M. 91.49 R.R. Spike in N.E. side of 24" Elm tree approximately ¼ mile East and 250 ft. North of the Intersection of Meridian & 47th St. So.

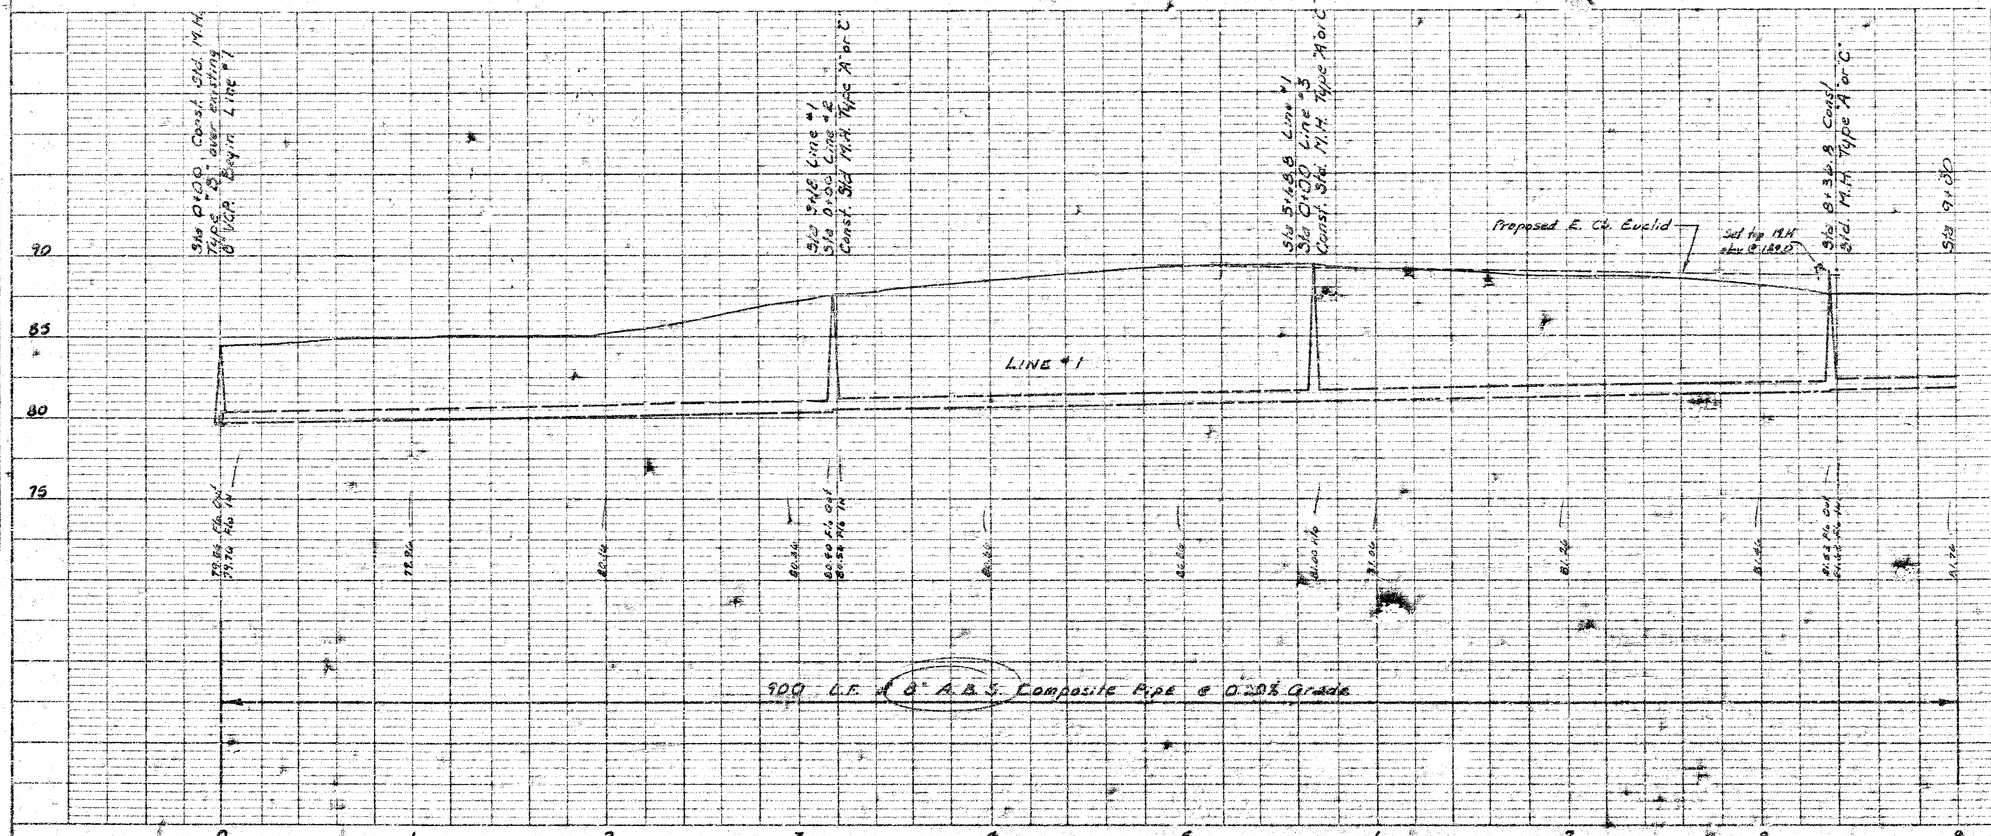

AS Built 4-30-79

CLG 07
D 253

LAT 27, MAIN 3, S.W. INTERCEPT

CITY OF WICHITA, KANSAS

R. W. LINN — CITY ENGINEE

PROJECT NO. 468-76-245-80516-000-000-00

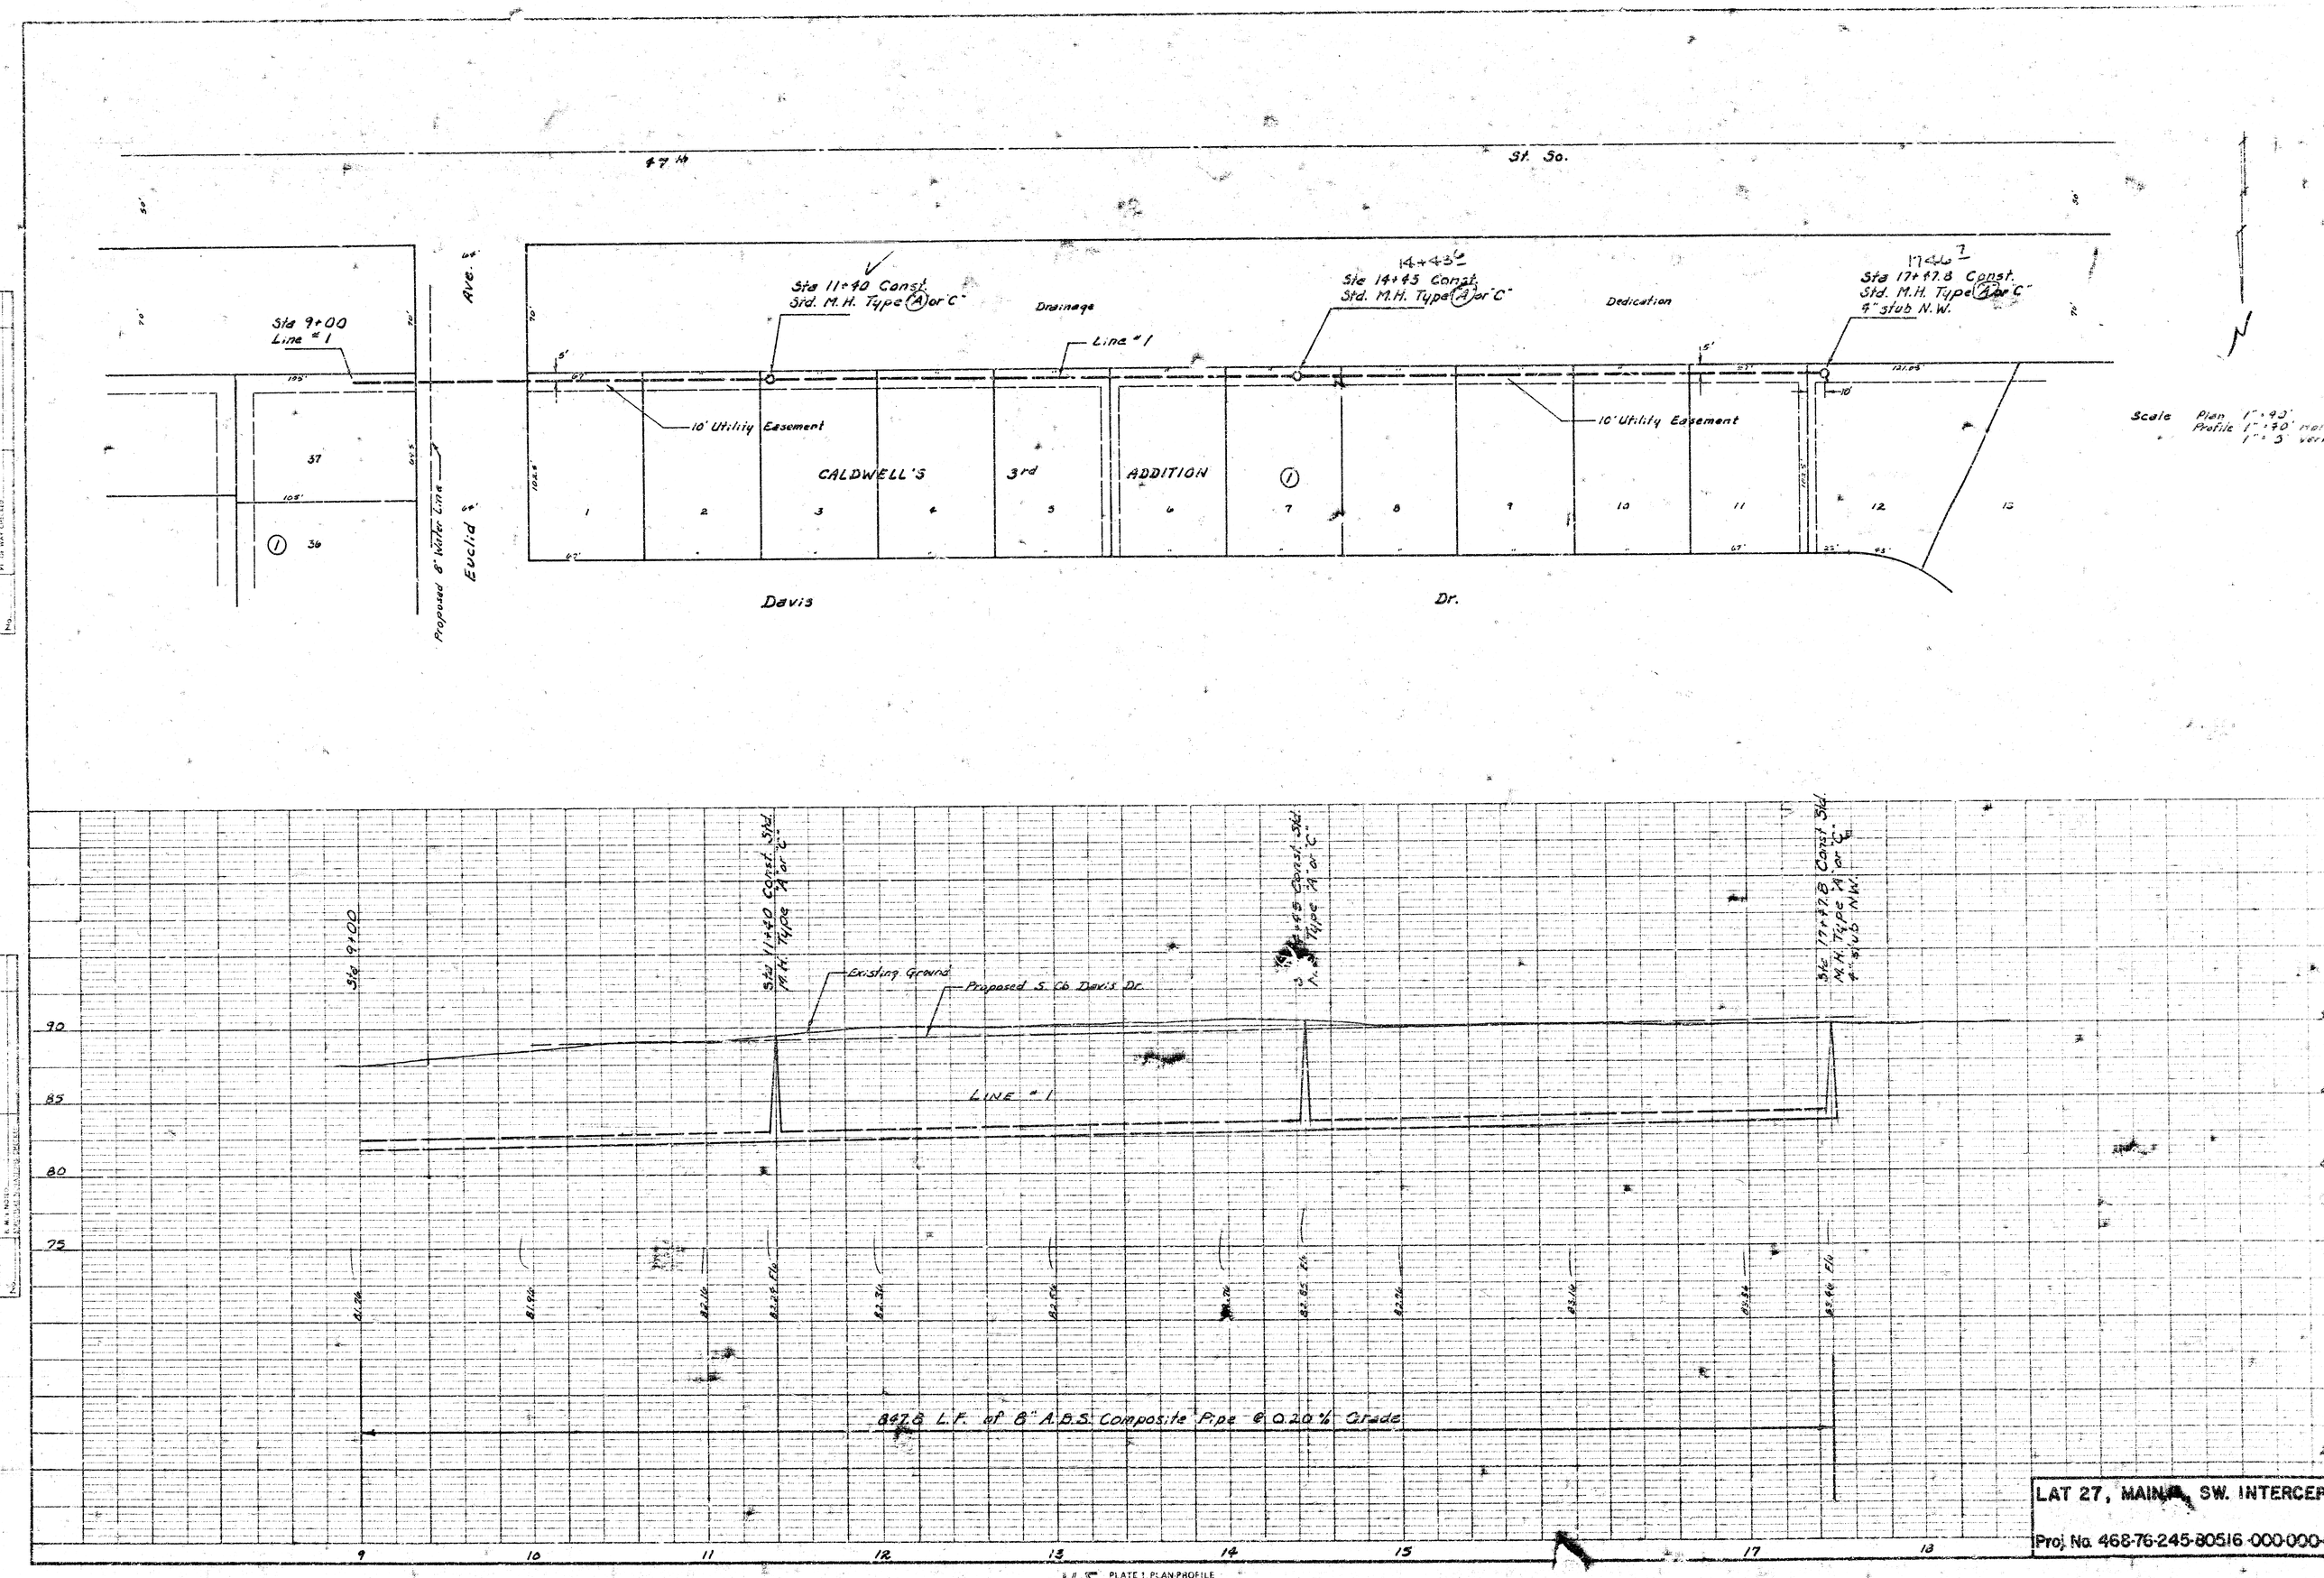

LAT 27, MAIN [illegible], SW. INTERCEP

Proj. No. 468-76-245-80516-000-000-

PLATE 1 PLAN-PROFILE

Scale Plan 1" = 40'
Profile 1" = 40' Horz.
1" = 5' Vert.

N

46th St. So.

Clarence Ave

CALDWELL'S 3rd ADDITION

20' Utility Easement

20' Utility Easement

LINE # 2

Sta 0+00 Line #2
Sta 3+18 Line #1
Const. Std. M.H.
Type "A" or "C"

2+99 ?
Sta 3+00 Const.
Std. M.H. Type "A" or "C"

5+98 ?
Sta 6+00 Const.
Std. M.H. Type "A" or "C"

9+02 ?
Sta 9+03 Const.
Std. M.H. Type "A" or "C"
Install 4" stub S.W.

Sta 0+00 Line #2
Sta 3+18 Line #1
Const. Std. M.H. Type "A" or "C"

Sta 3+00 Const. Std. M.H. Type "A" or "C"

Sta 6+00 Const. Std. M.H. Type "A" or "C"

Sta 9+03 Const. Std. M.H. Type "A" or "C" Install 4" stub S.W.

Existing Ground

Proposed N. Cl. 46th St. So.

LINE # 2

903 L.F. of 8" A.B.S. Composite Pipe @ 0.20 % Grade

PLATE 1. PLAN PROFILE

LAT 27, MAIN 3, SW. INTERCE

Proj. No. 468-76-245-80516-000-000

DAVIS DRIVE

EUCLID AVE.

BENNETT

46th ST. SO.

Proposed 8" Water Line

Sta 0+00 Line "3
Sta 3+68.8 Line "1
Const. Std. M.H.
Type "A" or "C"

Sta 4+99± Const.
Std. M.H. Type "A" or "C"

Sta 4+99± Const.
Std. M.H. Type "A" or "C"

Sta 7+79± Const.
Std. M.H. Type "A" or "C"

Sta 10+00
Line "3

20' Utility Easement

Line "3

CALDWELL'S 3rd ADDITION

Scale Plan 1"
Profile 1"

Existing Ground

Proposed N. Cb. Davis Dr.

Proposed S. Cb. 46th St. So.

LINE "B"

1000 L.F. of 8" A.B.S. Composite Pipe @ 0.20% Grade

LAT 27, MAIN 3, SW. INTERCE

Proj. No. 468-76-245-80516-000-00

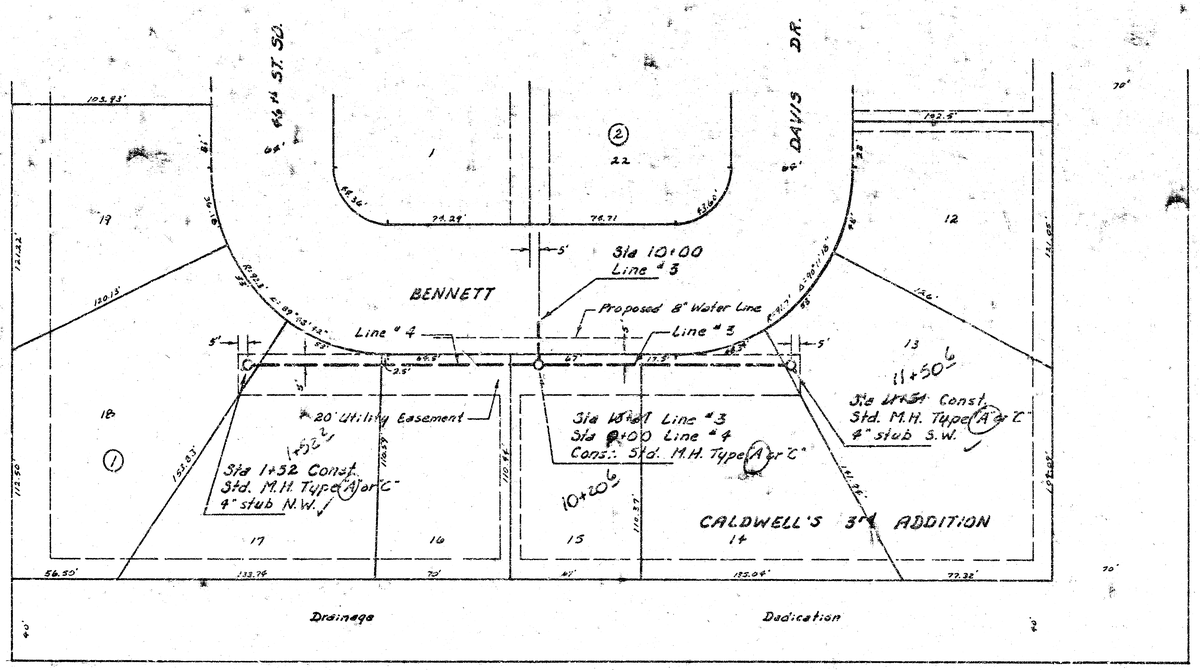

N

Scale Plan 1" = 40'
Profile 1" = 40' Horz.
1" = 5' Vert.

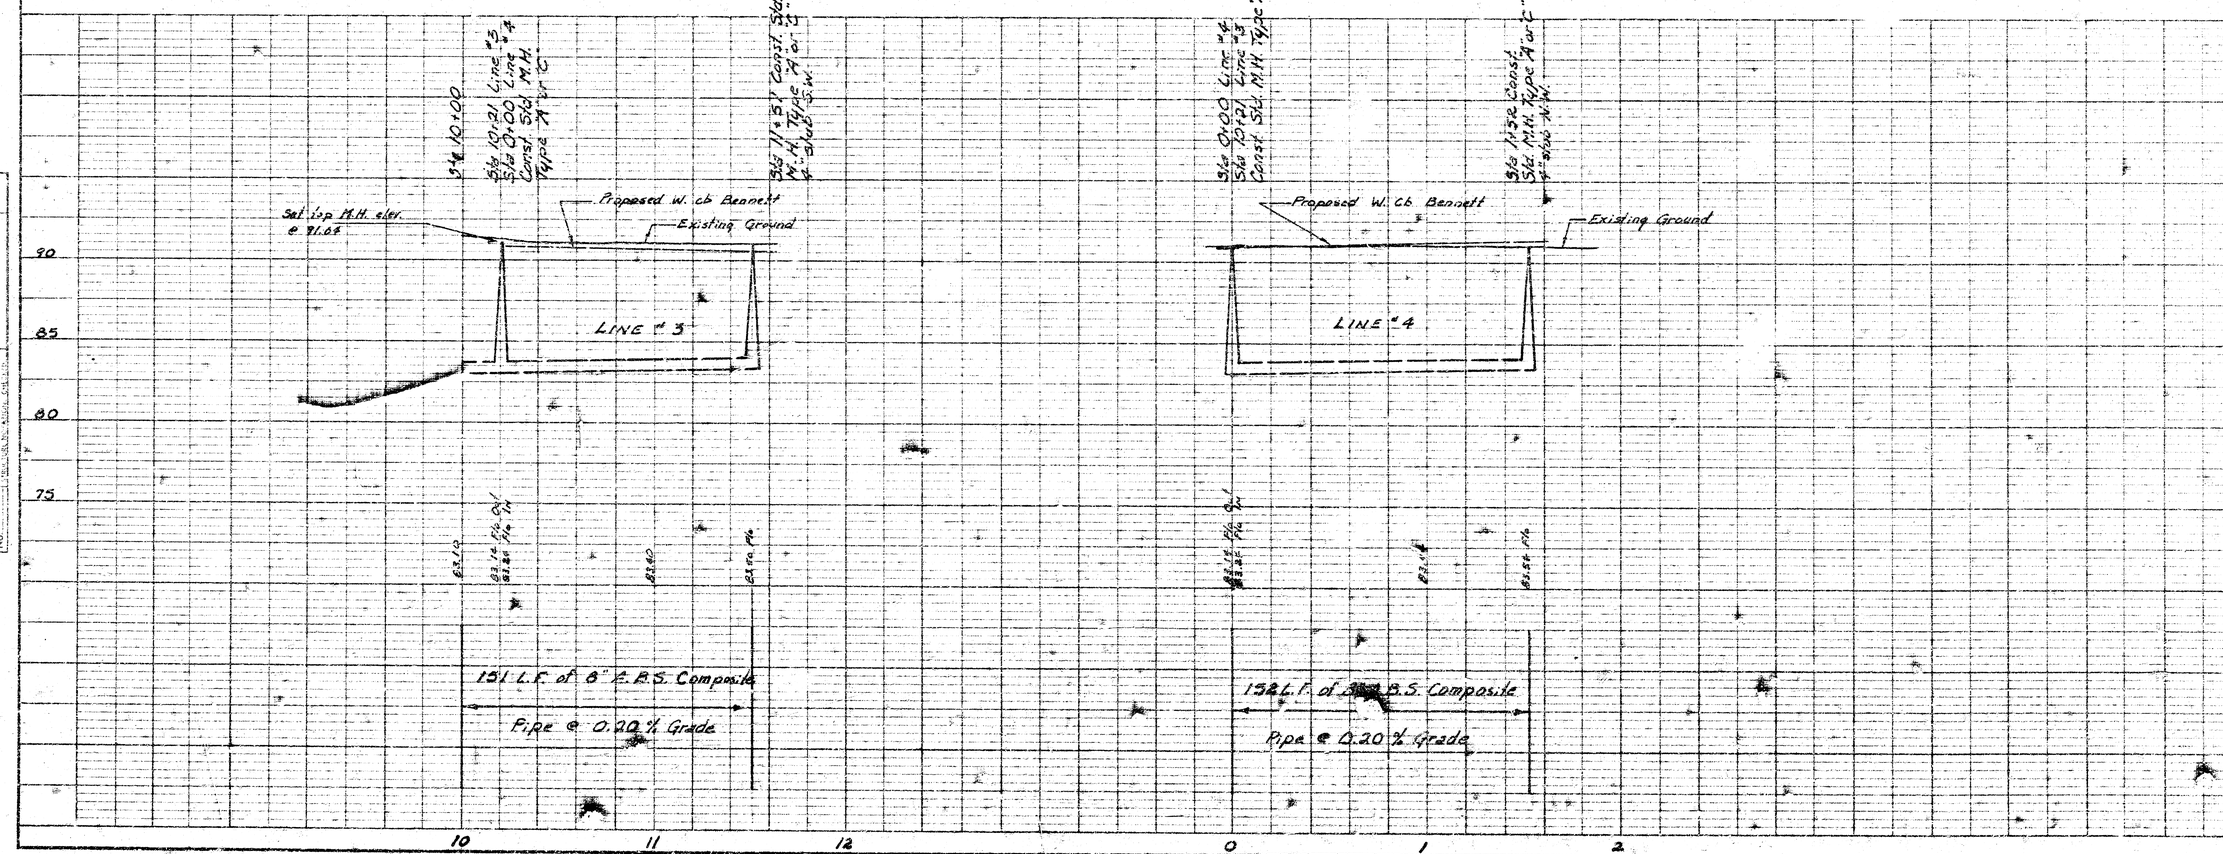

LAT 27, MAIN 3, SW. INTERCE

Proj. No. 468-76-245-80516-000-00

K&E PLATE 1, PLAN-PROFILE