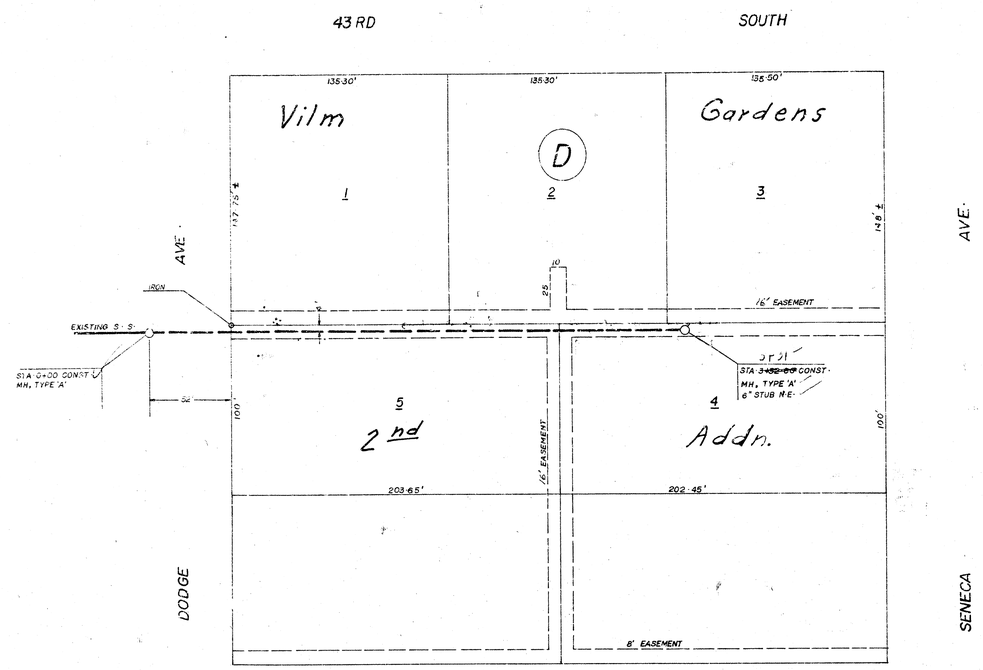

VILM GARDENS SECOND ADDITION

NOTE: CONTRACTOR SHALL GIVE PROPERTY OWNERS AND/OR TENANTS AFFECTED BY THE CONSTRUCTION OF THIS PROJECT A MINIMUM ADVANCED NOTICE OF 24 HOURS PRIOR TO STARTING CONSTRUCTION.

NOTES

1- FIELD ENGINEER TO TAKE TIES TO ALL IRONS THAT MAYBE DISTURBED DURING CONSTUCTION AND REPLACE ANY THAT ARE DESTROYED.

2- CONTRACTOR TO CONTACT UTILITY COMPANIES FOR LOCATION OF ANY UNDER GROUND LINES.

3- FIELD ENGINEER TO SET TOP OF MANHOLES TO FINISH GRADE AS DETEMINED BY DEVELOPER.

4- FIELD ENGINEER SHOULD DECIDE FOR REMOVING TREES IF IS NECESSERY.

NOTE

Benefit District Are Lots 1 Through 5

B.M = 88.01 City Std. Disc 48' E. of 42.80' S. of ℄ Seneca & 43RD ST. S.

SCALE

PLAN		1" = 40'
Profile	HORT.	1" = 40'
	VERT.	1" = 5'

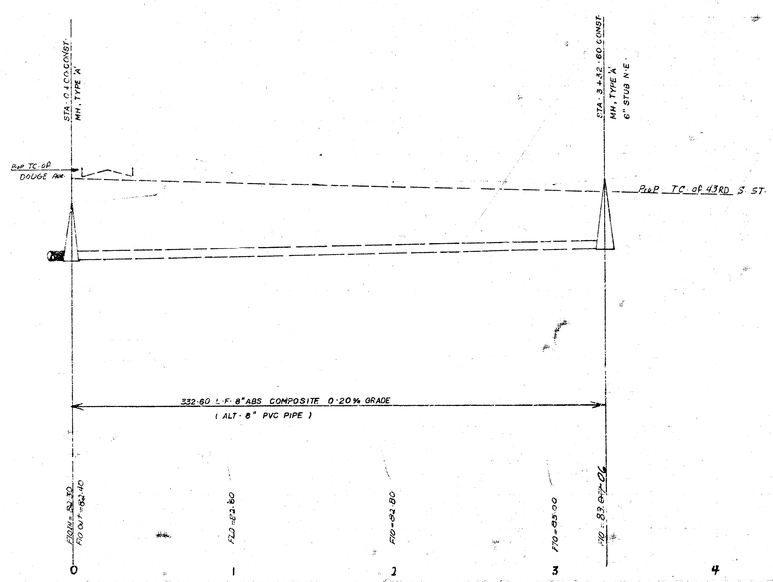

As Built
SSL
WSI

LAT-30, Main 3 SWI
468-76-245-80745-00-9-000-001
City of Wichita, Kansas
Dept. of Public Work—Engineering DIV.
Dean Sellers Acting City Engineer
DATE

FILMED FROM THE BEST AVAILABLE COPY