

B. M. 130.58 R.R. Spk. S. Side P.P. on N.E. cor. Taft & Ralstin.

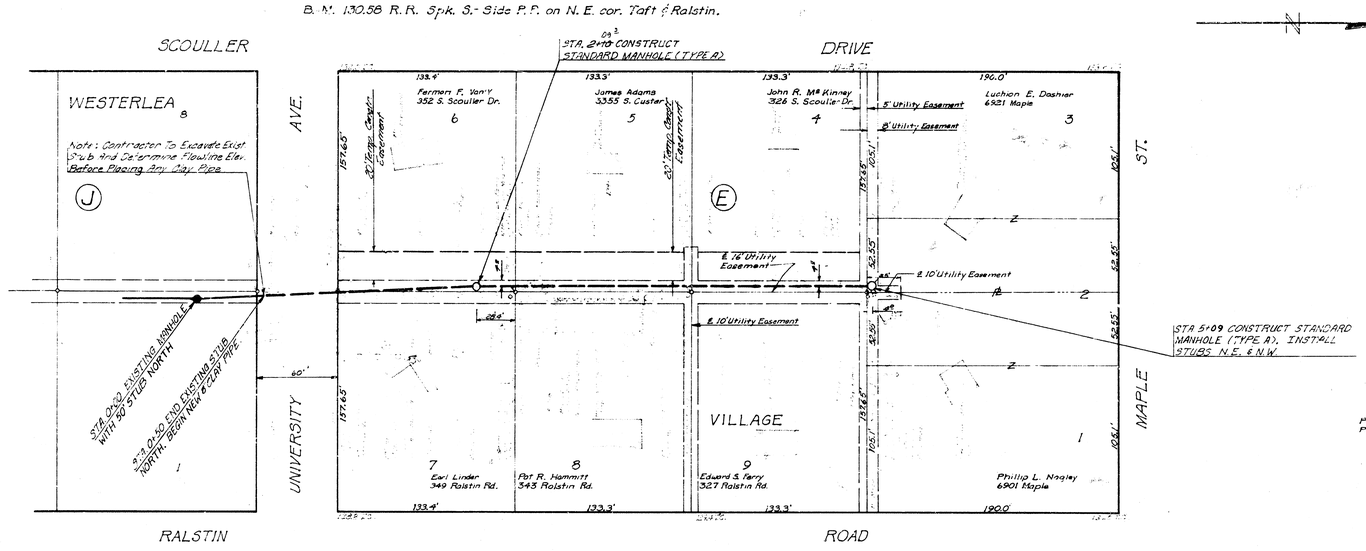

Note: All Property Irons That May Be Disturbed Shall Have Ties Taken To Them Where They May Be Replaced If Disturbed

PLAN SCALE : 1" = 40'
PROFILE SCALE : 1" = 40' HORIZ.
1" = 5' VERT.

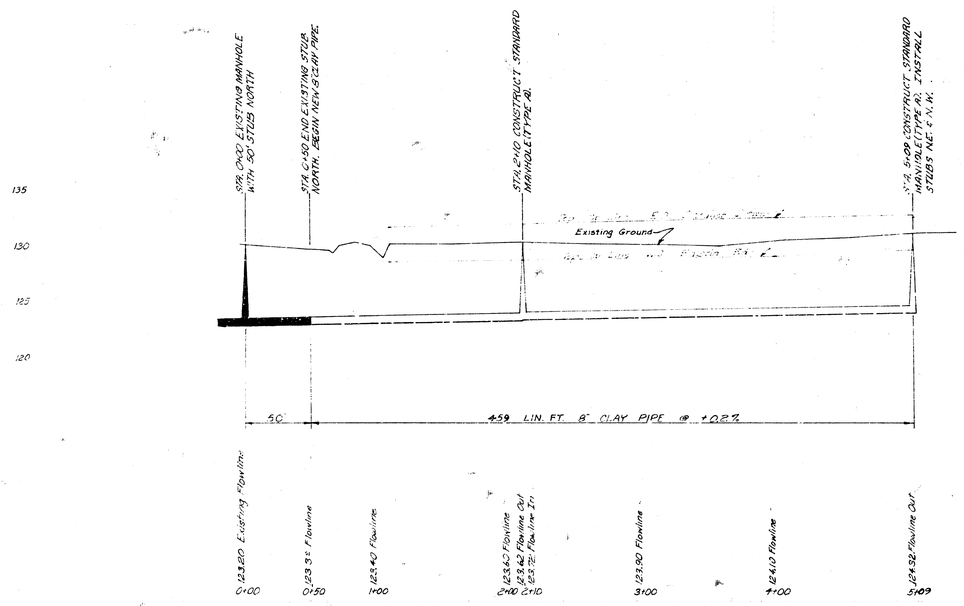

"As Built" Final Measurements 11-03

LAT. 5, MAIN 4, S.W. INTERCEPTOR SEWER
CITY OF WICHITA, KANSAS
R. W. LINN — CITY ENGINEER
SEPT. 1972 **PROJECT NO. DBKL 571028**