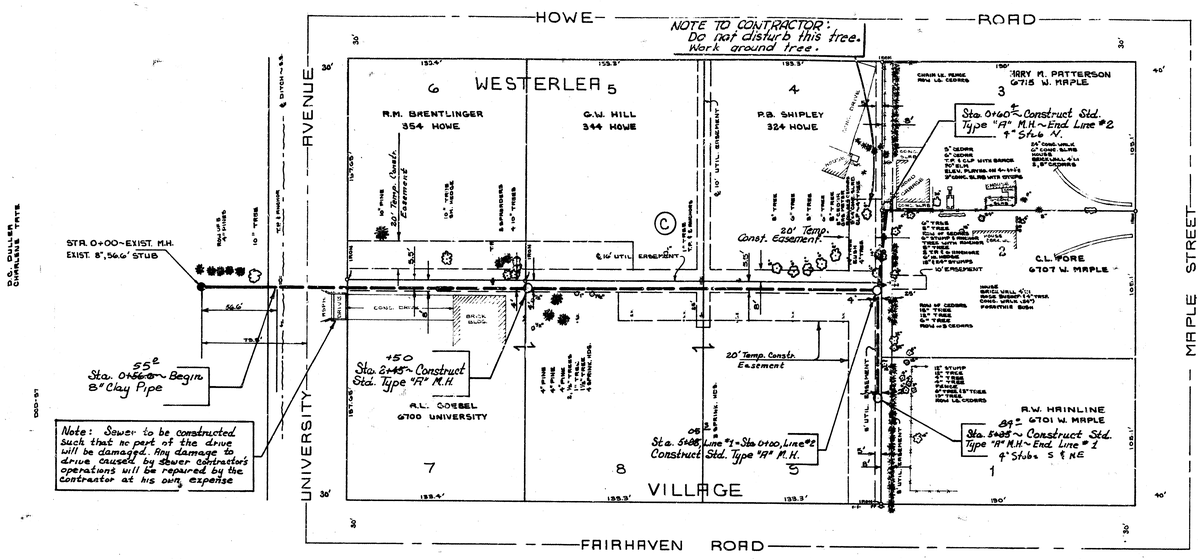

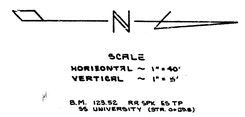

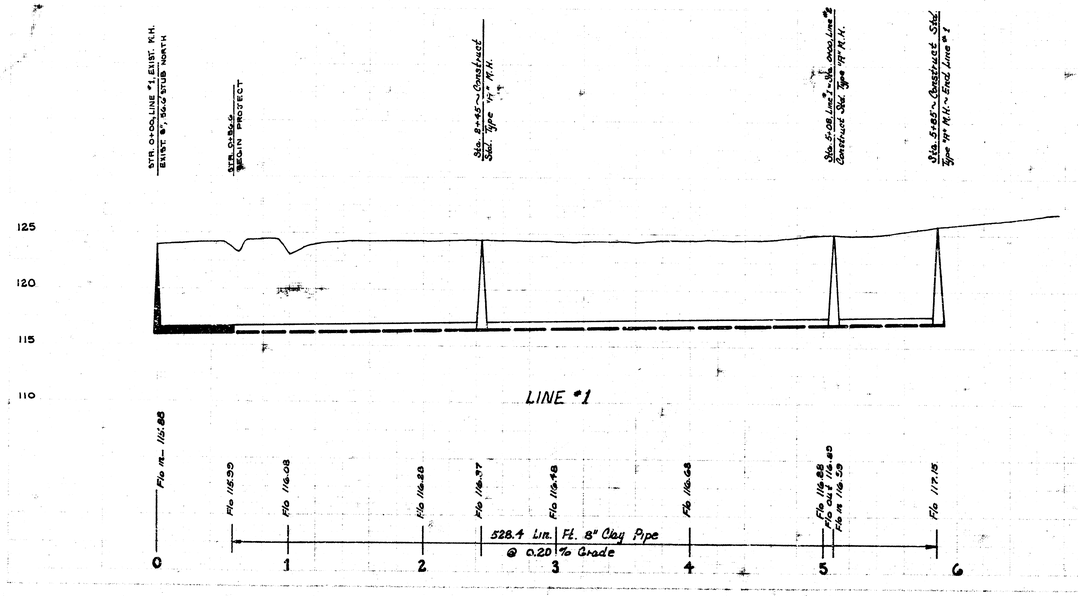

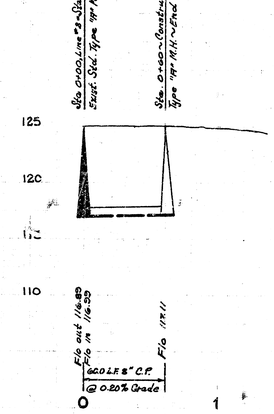

"As Built"
Final Meas. K-103

LAT. II, MAIN 4 S.W.I. SEWER
CITY OF WICHITA
R.W. LINN CITY ENGINEER
DATE Jan. 1974 PROJ. NO. DBKL 572006 1/1

14 9 5 8