
BM 121.85 City disc 33.7' W. & 3[illegible]3' S. of N.W. cor. of N.E. 1/4, Sec. 27 T27S R1W

BM 120.30 R.R. spike S.W. side Bell pole 30' S. of ℄ Maple & approx. 200' W. W.L. Arapaho


BM 119.74 R.R. spike W. side Power pole, 150' N. of N.L. Taft & 135' W. W.L. Arapaho

Plan Scale 1" = 40'
Profile Scale 1" = 40' Horz.
1" = 5' Vert.

N

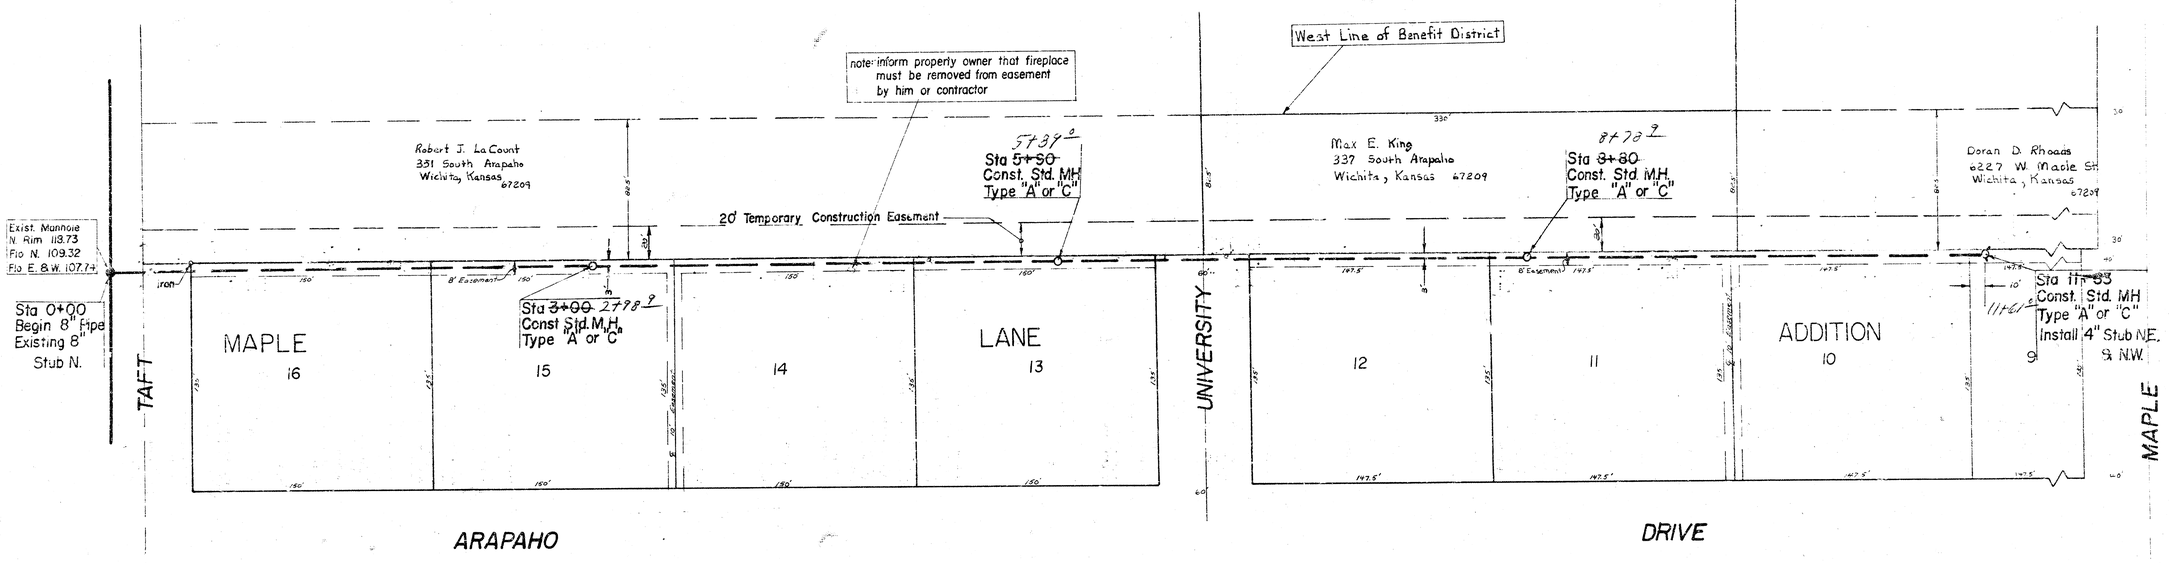

NOTE: CONTRACTOR SHALL NOT REMOVE ANY TREES WITHOUT FIRST OBTAINING APPROVAL FROM THE ENGINEER.

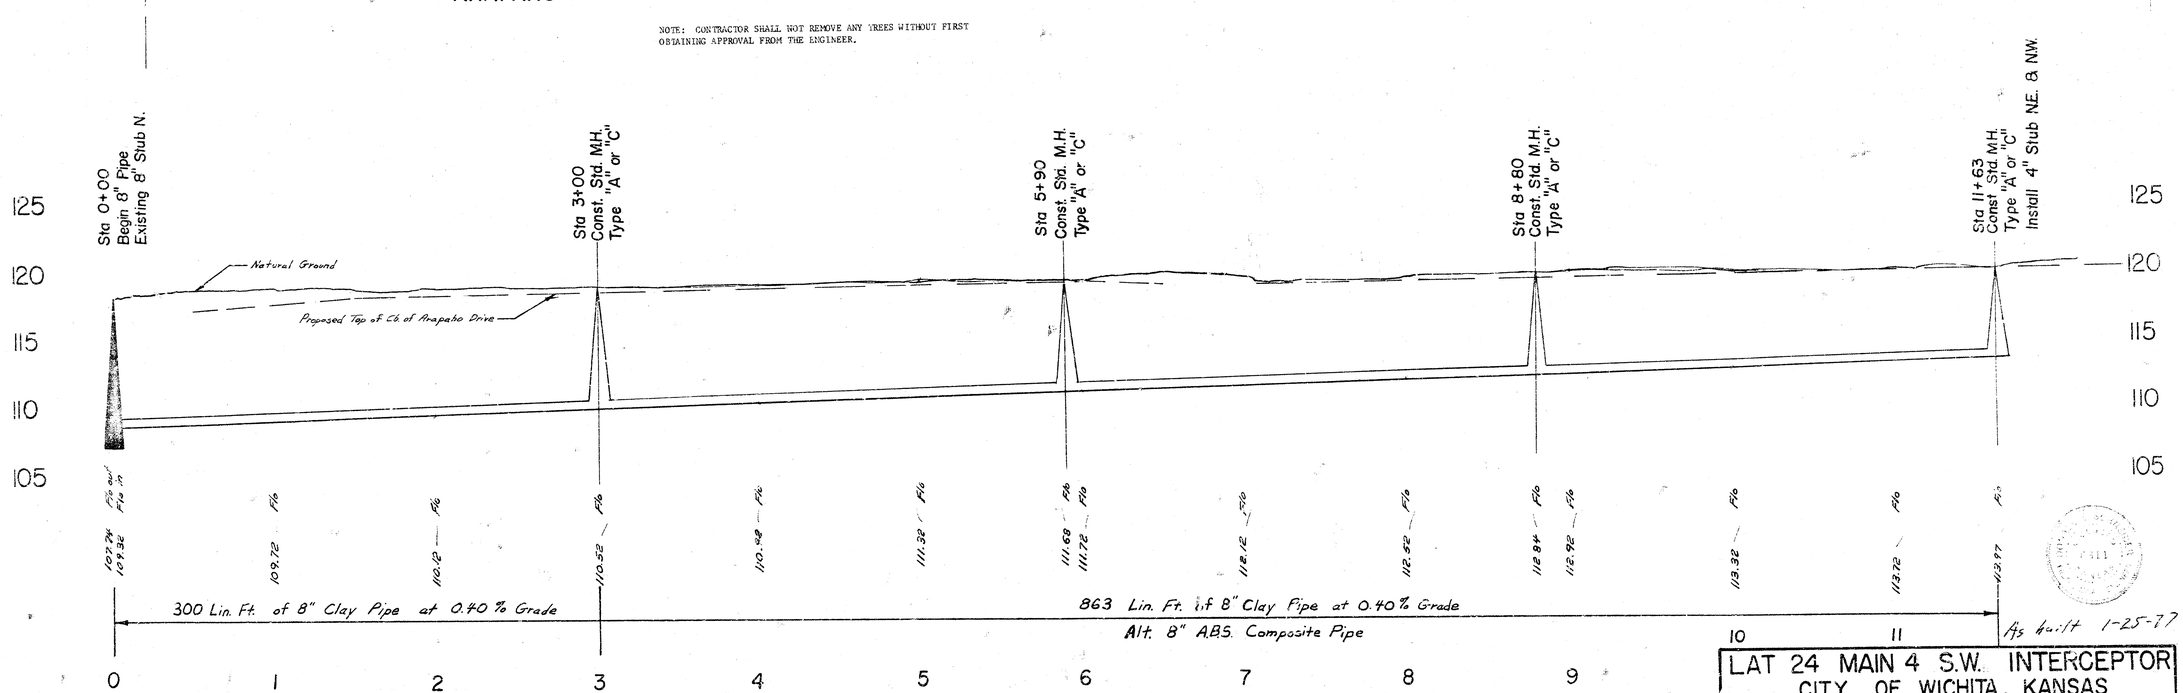

As built 1-25-77

LAT 24 MAIN 4 S.W. INTERCEPTOR
CITY OF WICHITA, KANSAS
R. W. LINN — CITY ENGINEER
Nov. 1976 Project Number DBKL576031