Lateral 34, Main 4, Southwest Interceptor


468-76-245-80856-000-000-001

CITY of WICHITA, KANSAS
DEPT. of PUBLIC WORKS—ENG. DIV.
DEAN S. SELLERS—ACTING CITY ENGINEER
DATE _____

NOTE: FIELD ENGINEER SHALL SET TOPS OF MANHOLES TO GRADE PROPOSED FINISHED [illegible] AS DETERMINED BY THE ENGINEER AND ADDITIONAL RISERS SHALL BE INSTALLED IN THIS PROJECT TO SERVE SIMILAR PURPOSES AS SHOWN ON THE PLANS AS DIRECTED BY THE ENGINEER. RISER CONSTRUCTION SHALL CONFORM TO THE REQUIREMENTS AS SHOWN ON STANDARD DETAIL [illegible] OF THE ENDS OF THE RISERS SHALL BE MARKED BY FASTENING ORANGE PLASTIC SNOW FENCE TAPE TO THE END OF EACH RISER AND TO THE GROUND SURFACE AS THE EXCAVATION IS BACKFILLED SUCH THAT THE LOCATION OF ALL RISERS MAY BE DETERMINED WHEN COMPLETED. ALL RISERS SHALL BE CONSTRUCTED USING S.L.P. 23 S.D.R. 35 P.V.C. PIPE. ELEVATIONS OF RISERS SHALL BE SUCH THAT WILL FACILITATE CONNECTION OF EXISTING SEWER LINES.

General Notes


1. Field Engineer to Take Ties to any Irons That May Be Disturbed and Replace and That are Destroyed
2. Contractor to Contact Utility Companies for Location of any Underground Lines.
3. Field Engineer to Set Tops of Manholes to Finish Grade as Determined by the Developer Unless Otherwise Noted on Plans

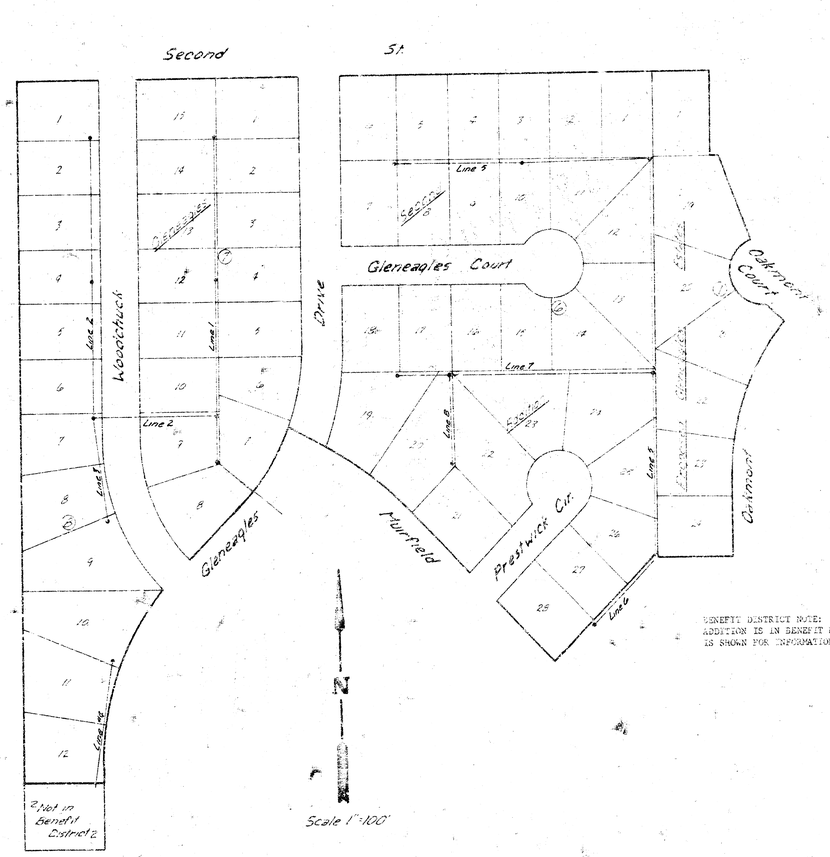

BENEFIT DISTRICT NOTE: ONLY 130' STRIP OF UNPLATTED GROUND EAST OF GLENEAGLES SECOND ADDITION IS IN BENEFIT DISTRICT FOR THIS PROJECT. PROPOSED PLAT OF GLENEAGLES ESTATES IS SHOWN FOR INFORMATION ONLY.


APPROVED
320C

1/6

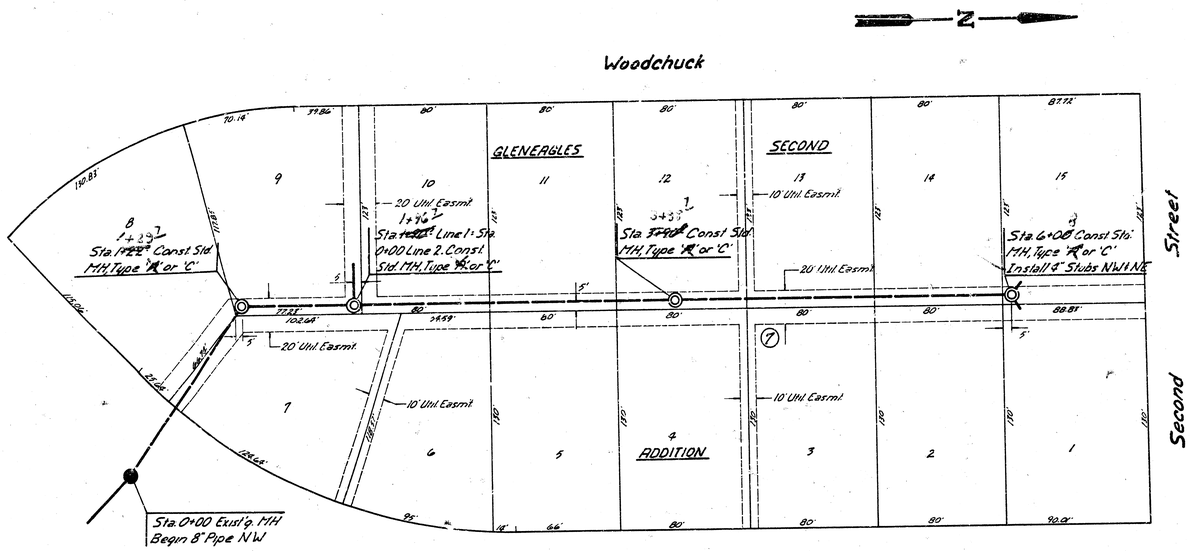


B.M. 151.58 R.R. Spk. N. Face H.P. 25' N. & 176' E. of Cl. Sec. 21, T27S, R1W (2nd & Woodchuck N.)


SCALE
Plan 1"=40'
Profile Horl. 1"=40'
Vert. 1"=5'

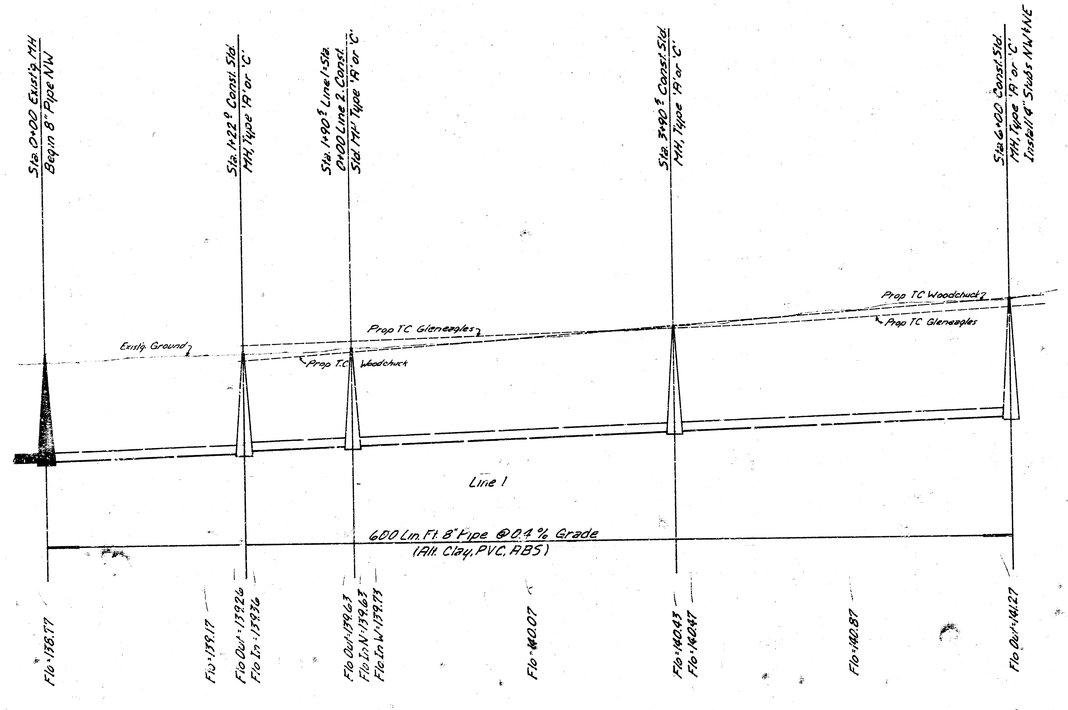

Line 1
Lateral 34, Main 4, SWI
4/6

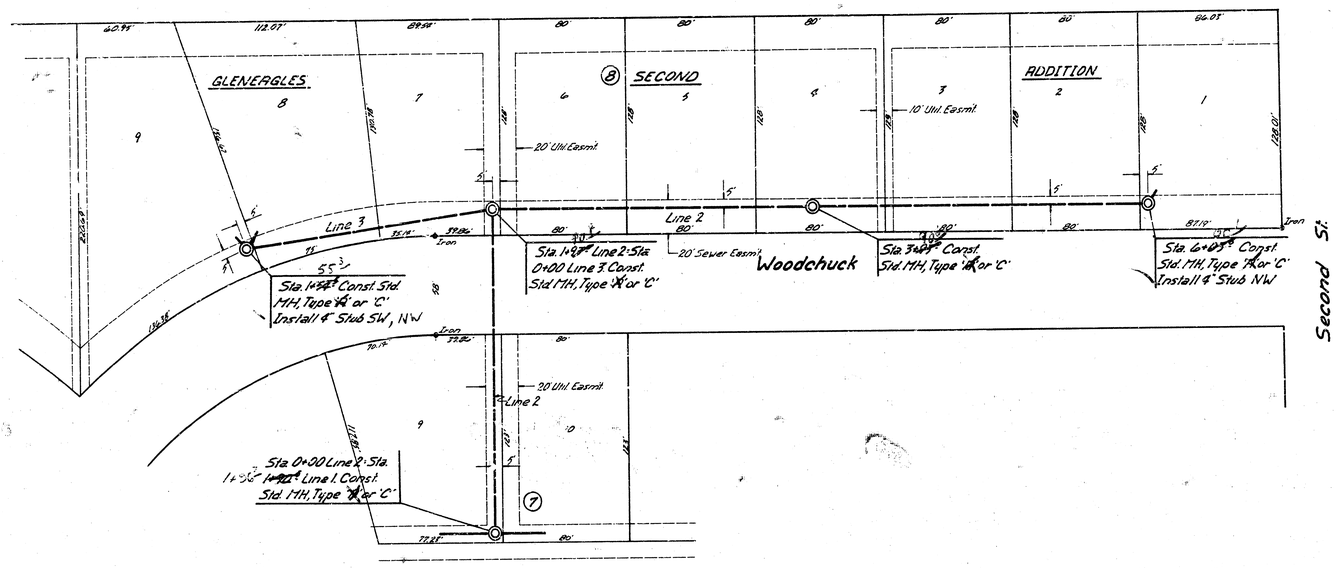



SCALE
Plan 1"=40'
Profile Hort. 1"=40'
Vert. 1"=5'

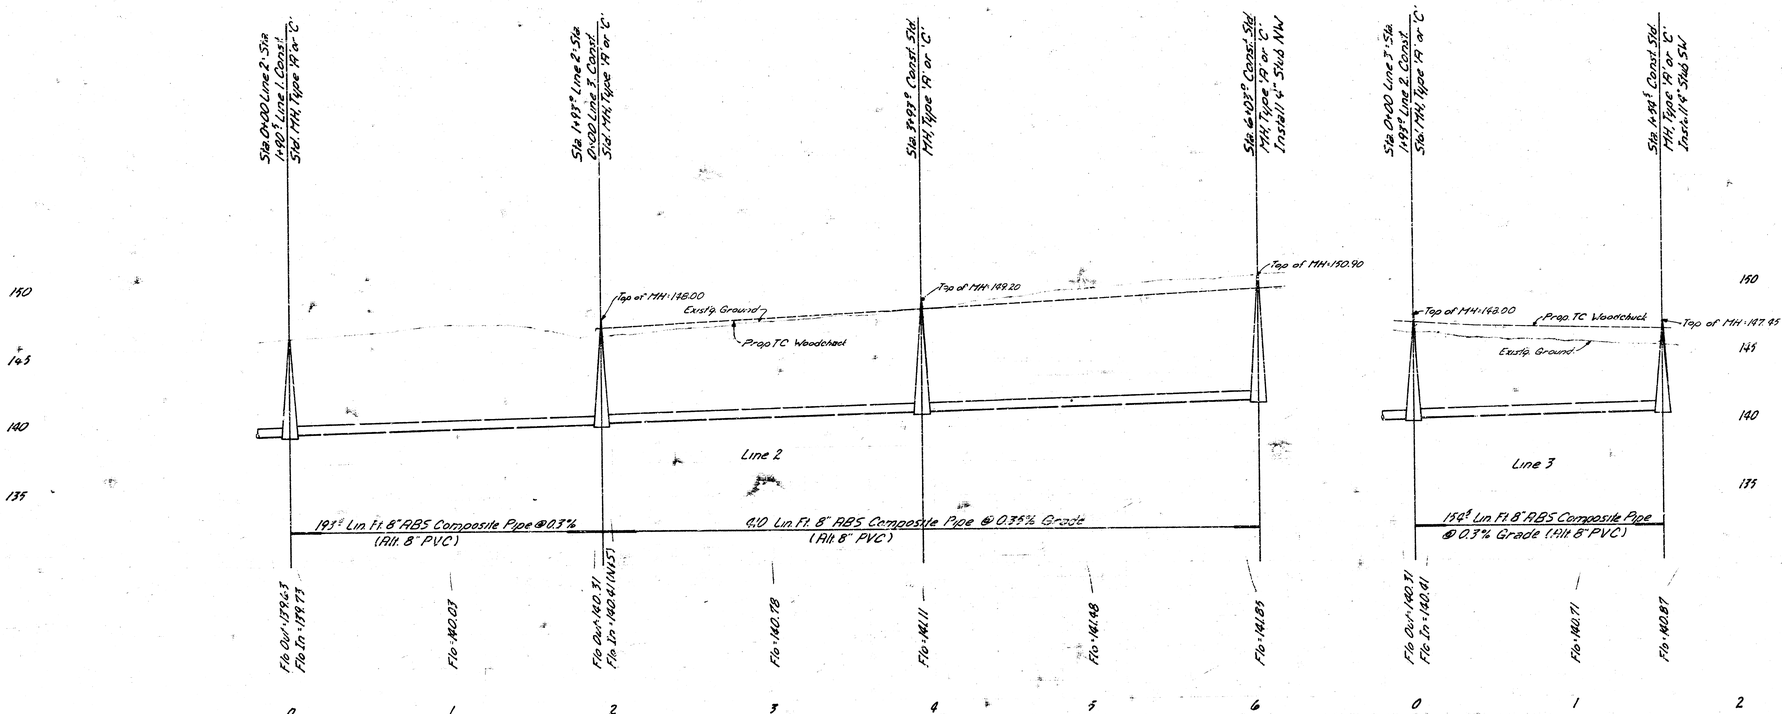

Lines 2 & 3 31/16
Lateral 39, Main 9, S.W.I.


N

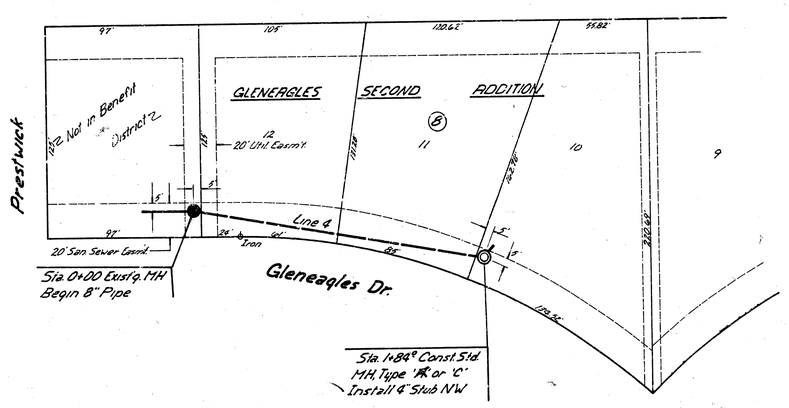


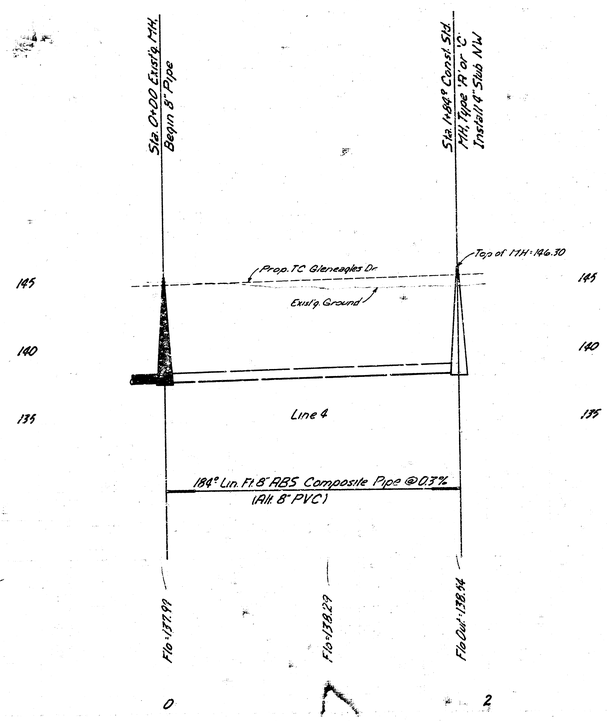



SCALE
Plan 1"=40'
Profile Hort. 1"=40'
Vert. 1"=5'

Line 4 4/6
Lateral 3A, Main 4, SWI

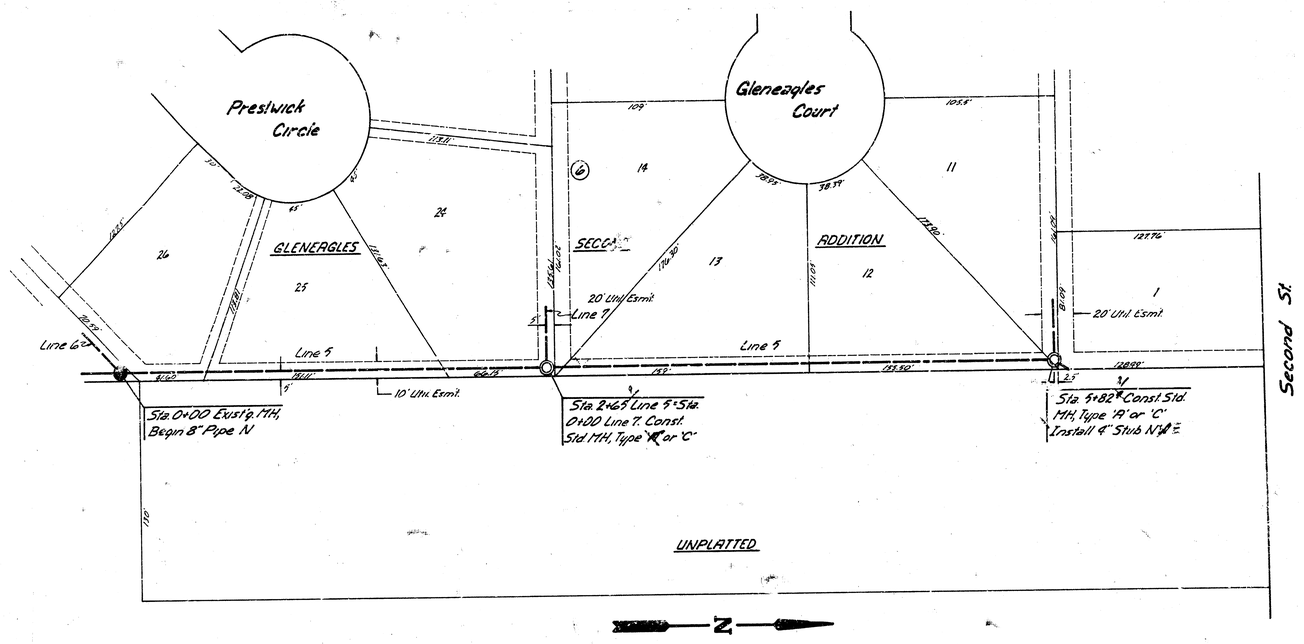

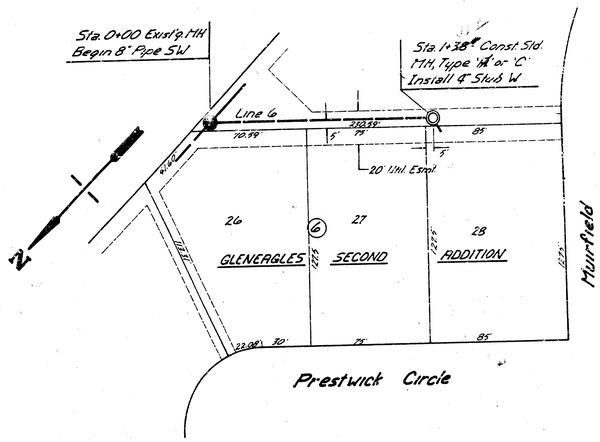

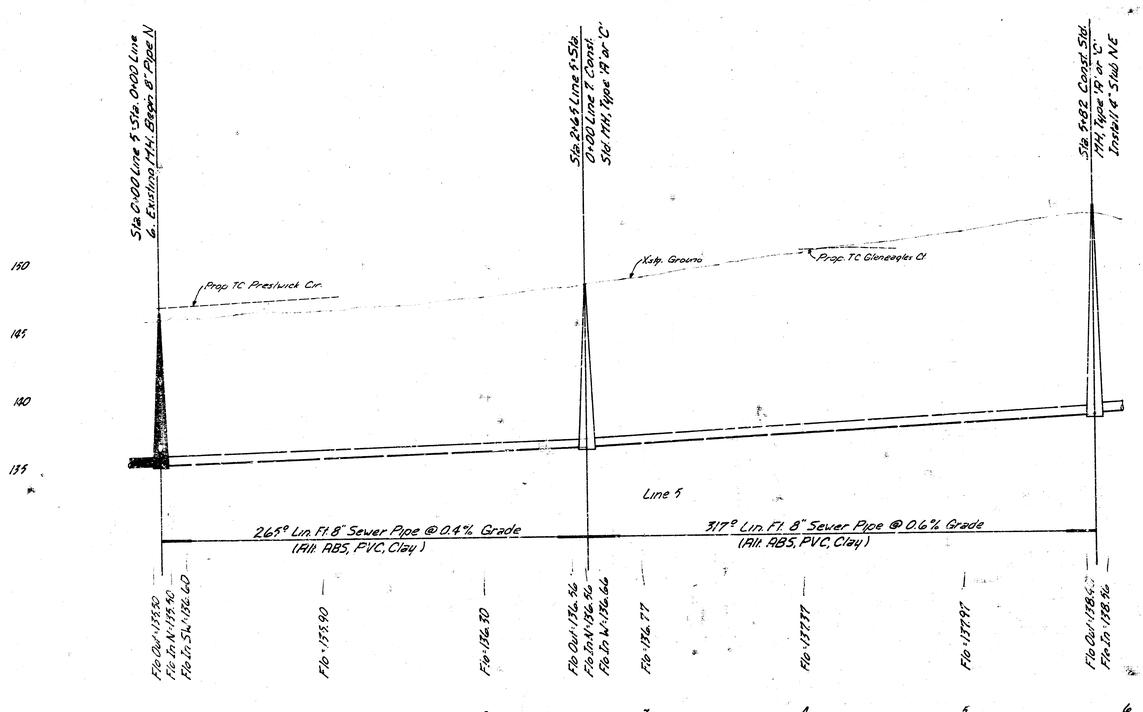

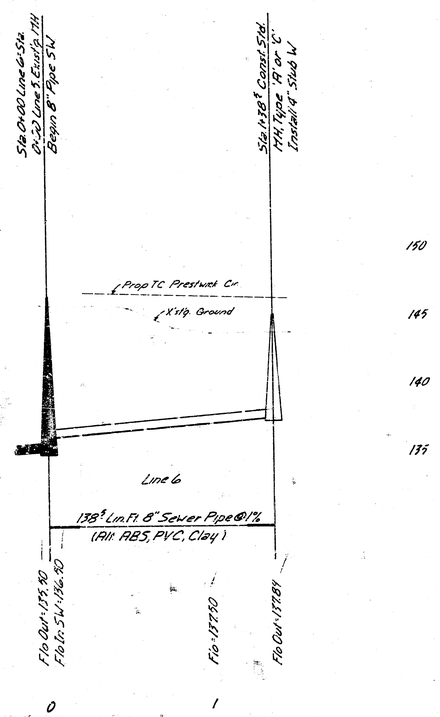



SCALE
Plan 1" = 40'
Profile Hor.: 1" = 40'
Vert. 1" = 5'

Lines 5 & 6


5/6


Lateral 34, Main 4, SWL

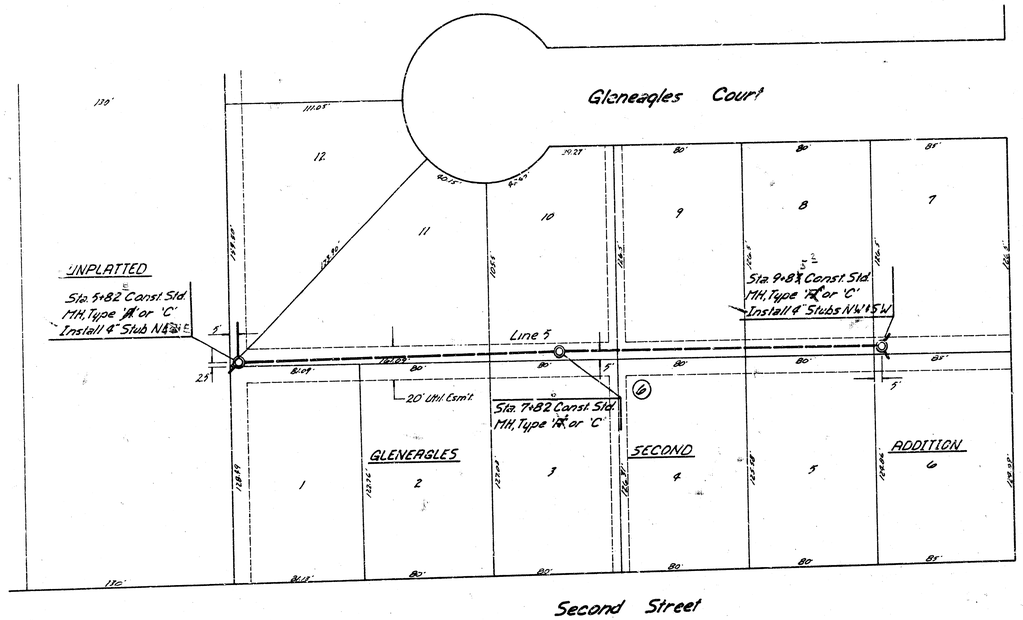

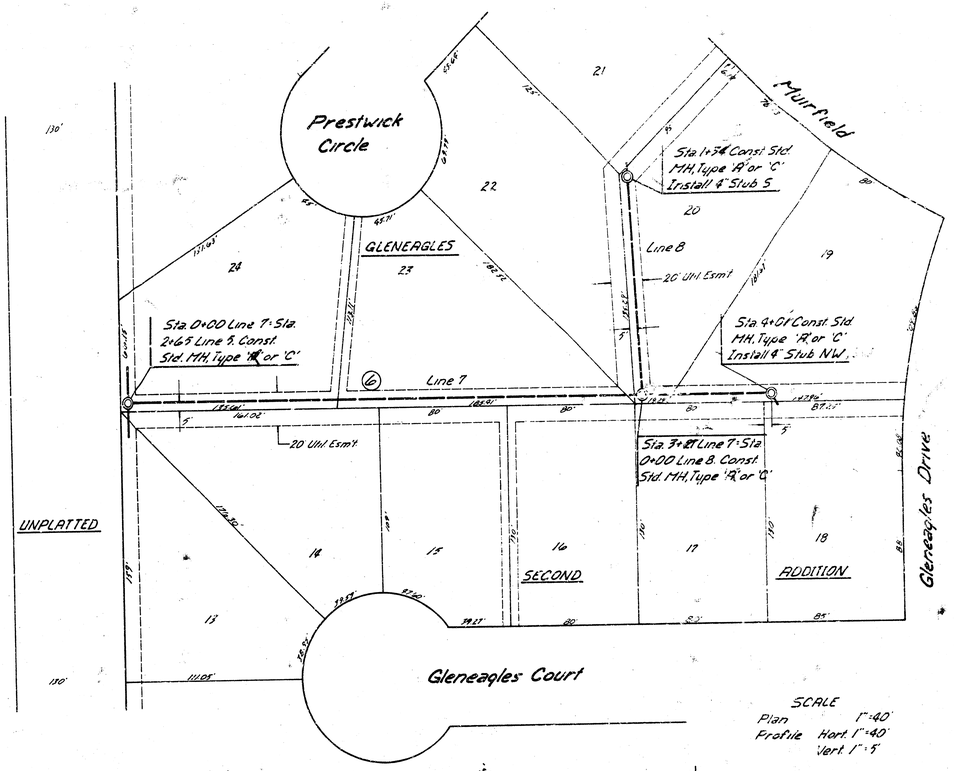

SCALE
Plan 1"=40'
Profile Hort 1"=40'
Vert 1"=5'

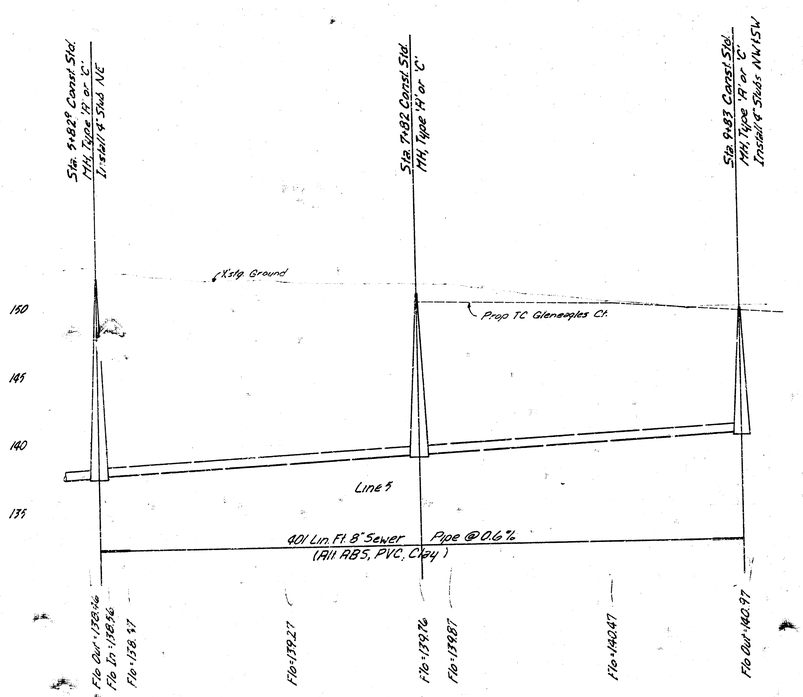

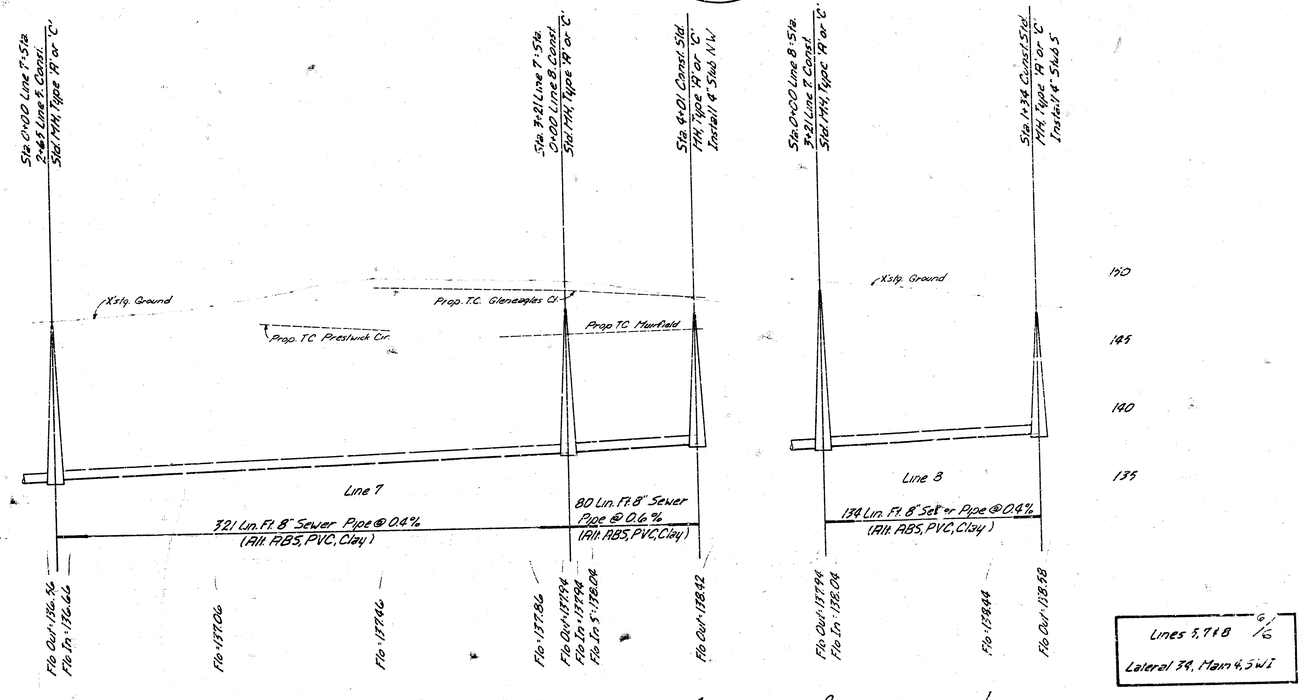

Lines 5, 7 & 8 6 / 16
Lateral 39, Main 4, Swi