LATERAL 42 MAIN 4 S.W. INTERCEPTOR

PROJECT NO. 468-76-245-81722000-000-001


CITY OF WICHITA, KANSAS

MICHAEL E. LINDEBAK, CITY ENGINEER

JANUARY, 1988

GENERAL NOTES

1. ALL BLOCK CORNERS AND CONTROL POINTS WILL BE PROTECTED. IF REMOVED DURING CONSTRUCTION, CONTRACTOR WILL HAVE THEM REPLACED BY A LICENSED ENGINEER OR LAND SURVEYOR AT HIS EXPENSE.
2. WHEN THE EXISTING FENCING THAT IS KEEPING IN HOUSEHOLD PETS IS REMOVED TO FACILITATE SEWER CONSTRUCTION, THE CONTRACTOR SHALL PROVIDE ALL NECESSARY MATERIALS AND LABOR TO INSTALL TEMPORARY 4 FT. HIGH FENCING.
3. IF THE CONSTRUCTION IS FINISHED DURING THE APPROPRIATE TIME OF YEAR TO PLANT GRASS SEED, THE CONTRACTOR SHALL PROVIDE AND PLANT GRASS SEED ACCORDING TO THE CITY OF WICHITA SPECIFICATIONS.
4. WHEN POSSIBLE CONTRACTOR SHALL PRESERVE TREES.

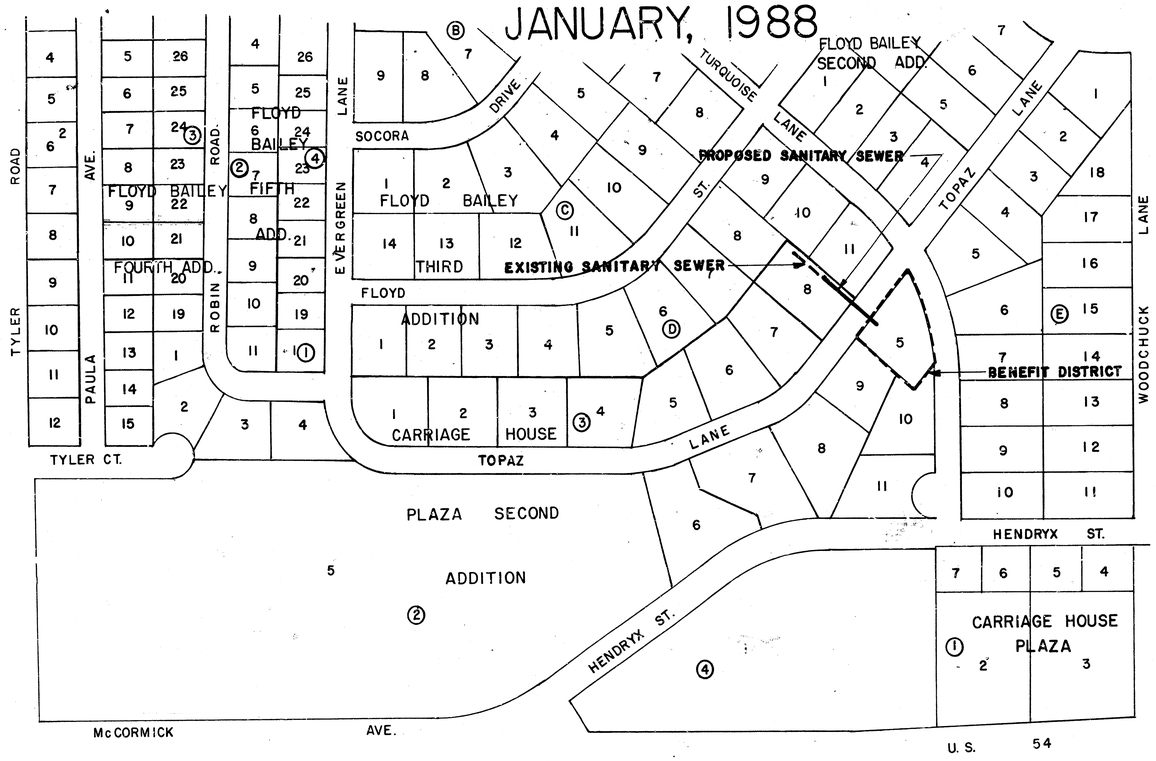

NOTE:
THE CITY OF WICHITA WILL AIR TEST AND TELEVISE THE NEW LINE PRIOR TO ACCEPTANCE.

AS BUILT from Insp. Cards 10-26-88 RPL

REV.	A	1/28/88	RMH	PER CITY OF WICHITA ENG. DEPT.


WICHITA, KANSAS
SANITARY SEWER EXTENSION

LOCATION MAP
PROJECT NO. 468-76-245-81722000-000-001
LAT 42, MAIN, S.W. INTERCEPTOR SEWER


CASTLE & ASSOCIATES ENGINEERS WICHITA, KANSAS	DSG. RMH	DWG FILE NO.	1/2
	DR. N.G.	8741-D-60052	
	CH. RMH		
DATE NOVEMBER 1987	APP.	SHEET NO. 1 OF 2	REV. A

BM1143.45 Chiseled "□" in light pole base at South R/W line of Maple St. & 68 Ft. East of East R/W line of Woodchuck.

BM1138.73 Chiseled "□" on 2'x6" Concrete Headwall at north side of drive at 517 Topaz

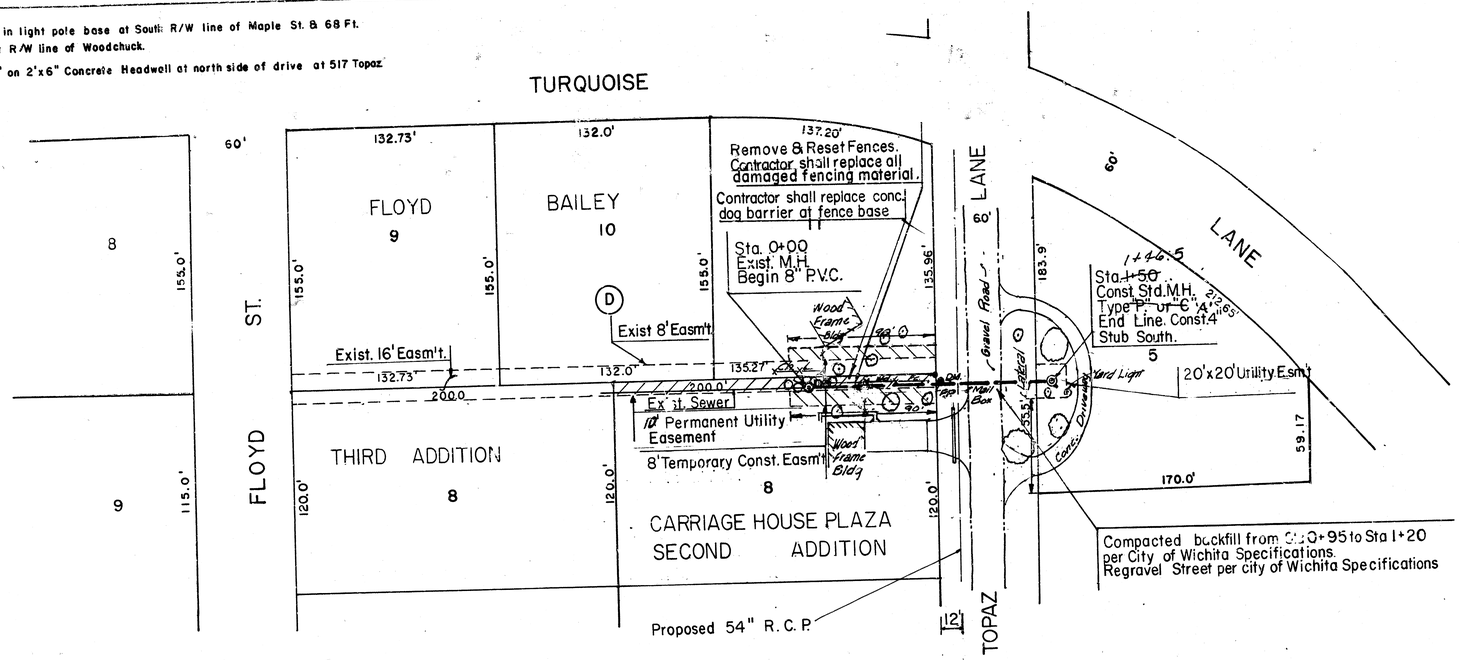

Plan Scale 1"= 40'
Profile Scale 1"= 40' Horz.
1"= 5' Vert.

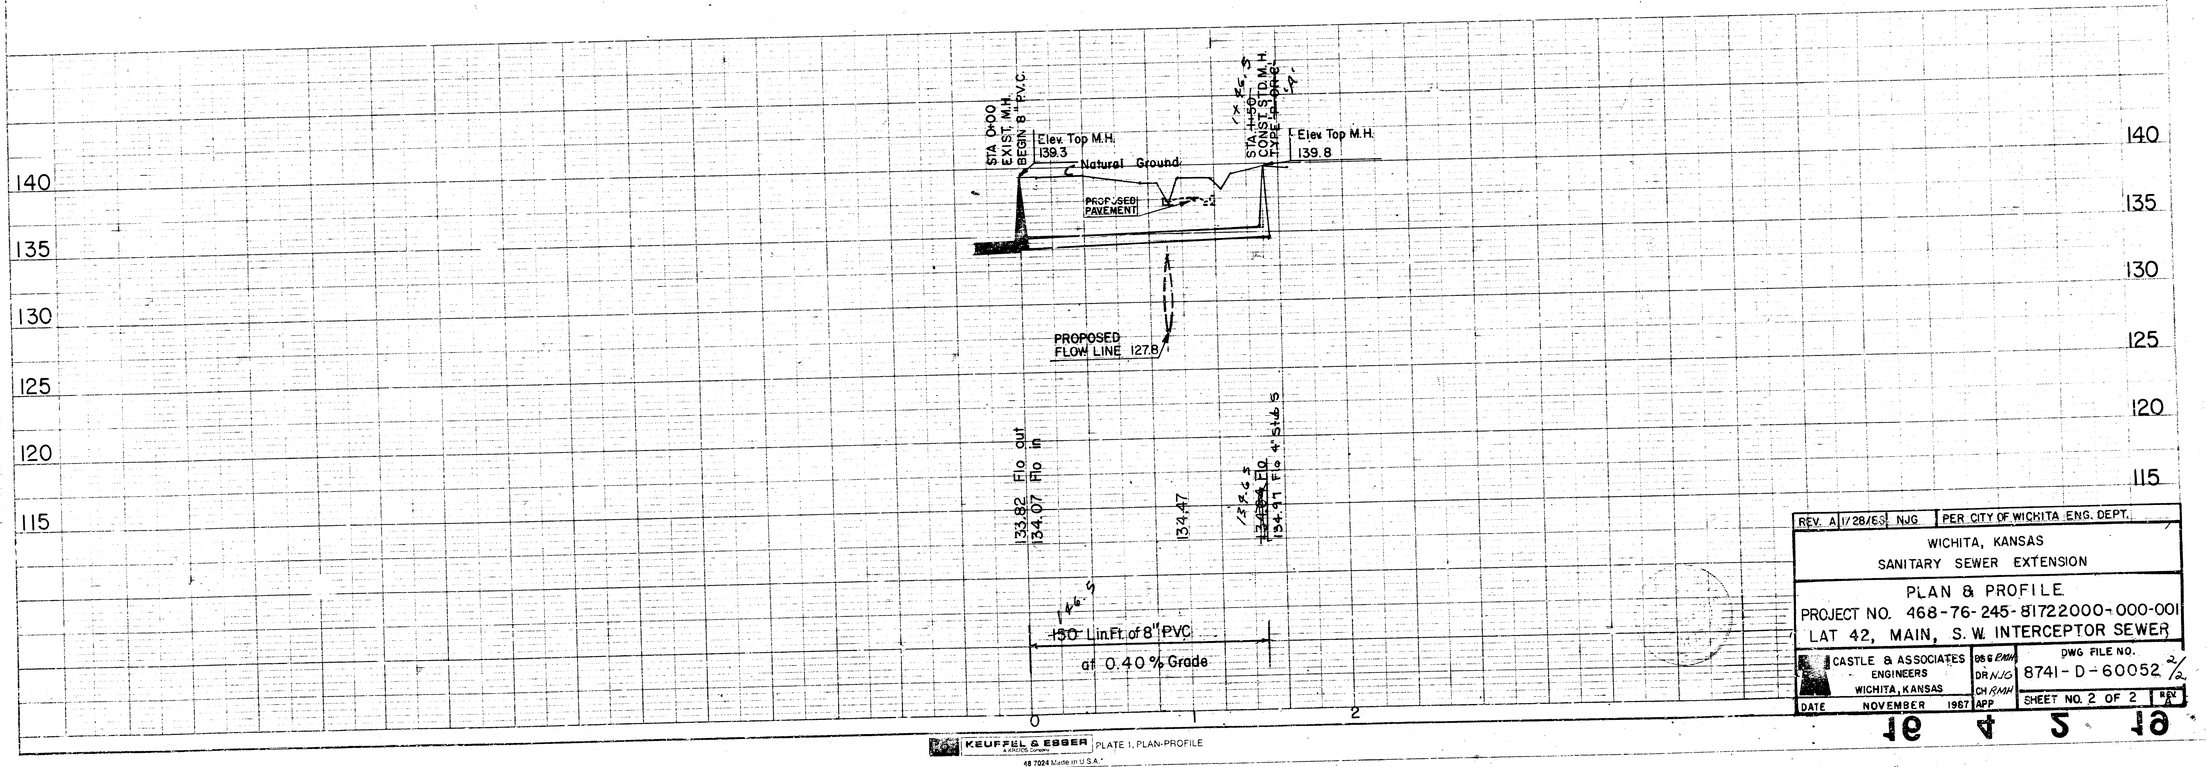

REV. A 1/28/69 NJG	PER CITY OF WICHITA ENG. DEPT.	
WICHITA, KANSAS		
SANITARY SEWER EXTENSION		
PLAN & PROFILE		
PROJECT NO. 468-76-245-81722000-000-001		
LAT 42, MAIN, S.W. INTERCEPTOR SEWER		
CASTLE & ASSOCIATES ENGINEERS WICHITA, KANSAS	DES RMH DR NJG CH RMH	DWG FILE NO. 8741-D-60052 2/2
DATE NOVEMBER 1967	APP	SHEET NO. 2 OF 2 REV. A

KEUFFEL & ESSER Co. PLATE 1, PLAN-PROFILE
48 7024 Made in U.S.A.

PLAN

PROFILE