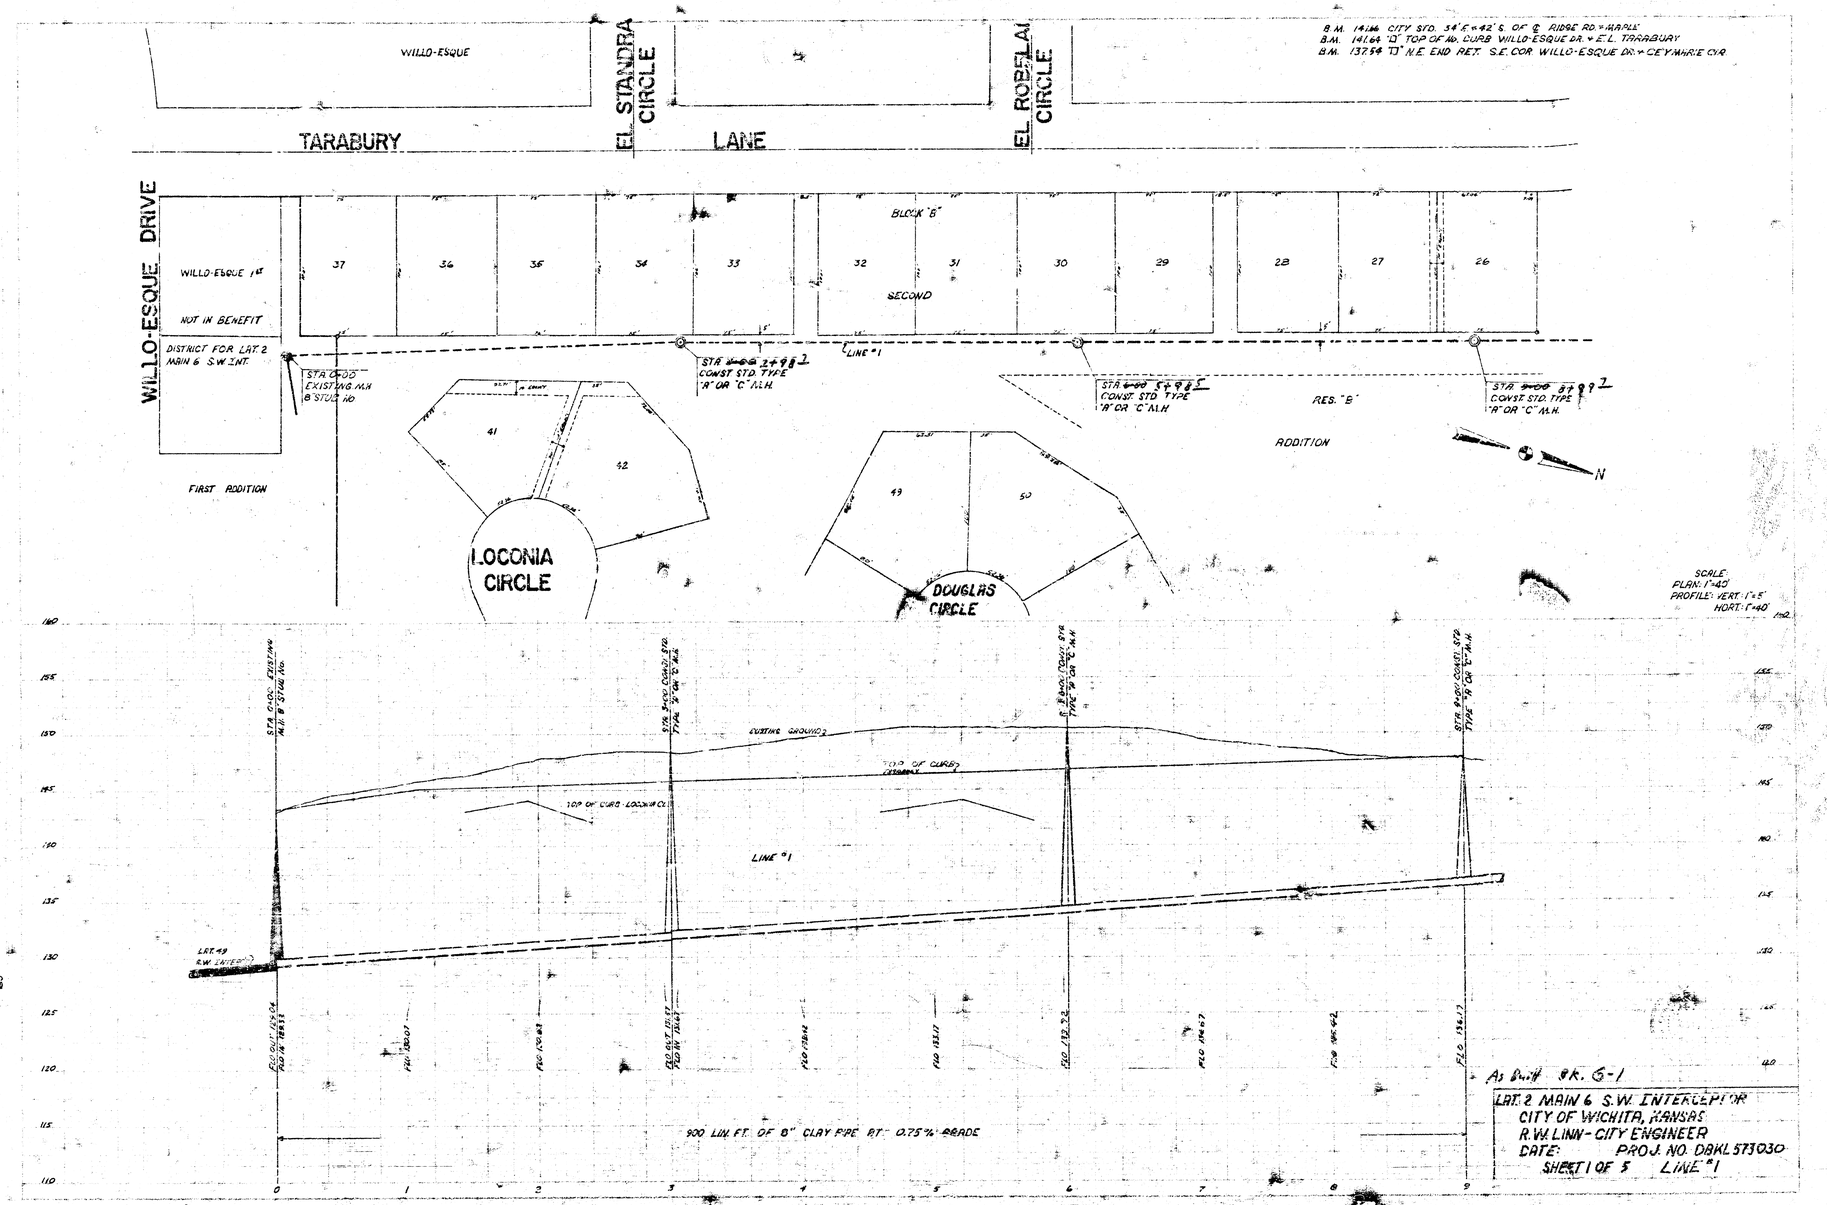
WILLO-ESQUE
EL STANDRA CIRCLE
EL ROBELLA CIRCLE
TARABURY LANE
B.M. 1414 CITY STD. 34'E x 42'S. OF ℄ RIDGE RD. x MAPLE
B.M. 1416 "D" TOP OF NO. CURB WILLO-ESQUE DR. x E.L. TARABURY
B.M. 1375 "D" N.E. END RET. S.E. COR. WILLO-ESQUE DR. x CEYMARIE CIR
WILLO-ESQUE DRIVE
WILLO-ESQUE 1st
NOT IN BENEFIT
DISTRICT FOR LAT. 2 MAIN 6 S.W. INT.
BLOCK "B"
SECOND
37
36
35
34
33
32
31
30
29
28
27
26
STA 0+00 EXISTING M.H & STUB NO
STA 2+98.2 CONST STD. TYPE "A" OR "C" M.H.
℄ LINE "1
STA 5+98.5 CONST STD TYPE "A" OR "C" M.H.
RES. "B"
STA 9+00 87 99.7 CONST STD TYPE "A" OR "C" M.H.
ADDITION
N
FIRST ADDITION
41
42
43
50
LOCONIA CIRCLE
DOUGLAS CIRCLE
SCALE
PLAN: 1"=40'
PROFILE: VERT: 1"=5'
HORT: 1"=40'
STA 0+00 EXISTING M.H & STUB NO
STA 2+98.2 CONST STD TYPE "A" OR "C" M.H.
STA 5+98.5 CONST STD TYPE "A" OR "C" M.H.
STA 9+00 87 99.7 CONST STD TYPE "A" OR "C" M.H.
EXISTING GROUND
TOP OF CURB EXISTING
TOP OF CURB LOCONIA CI.
LINE "1
LOT 49 R.W. LINE
900 LIN. FT. OF 8" CLAY PIPE AT .075% GRADE
As Built BK. 6-1
LAT. 2 MAIN 6 S.W. INTERCEPTOR
CITY OF WICHITA, KANSAS
R.W. LINN - CITY ENGINEER
DATE: PROJ. NO. DAKL 573030
SHEET 1 OF 5 LINE "1

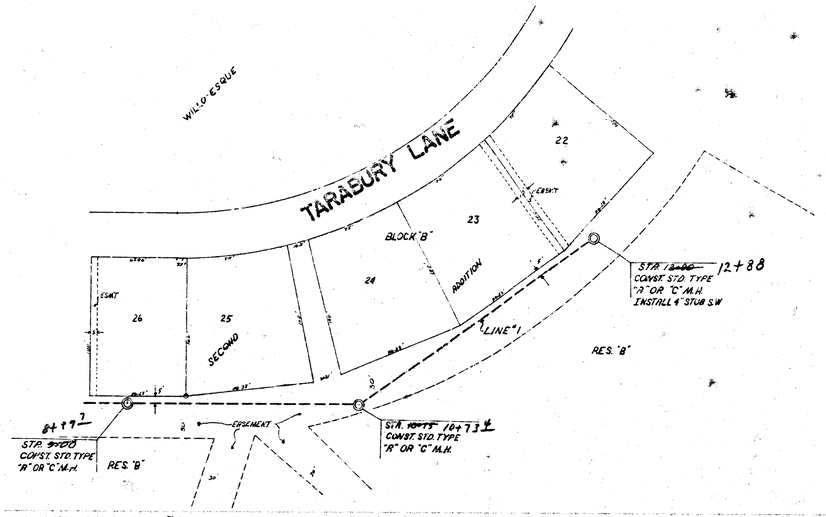

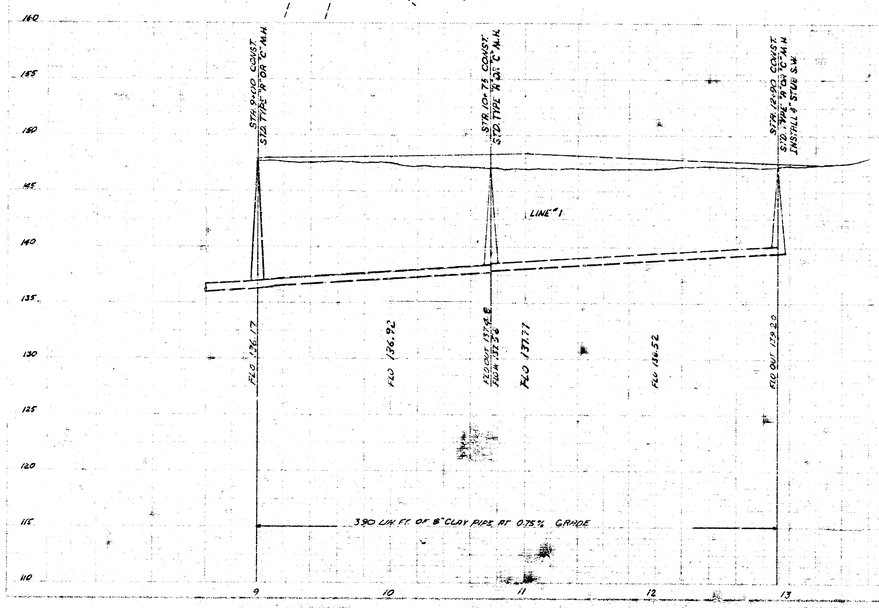

SCALES
PLAN 1"=40'
PROFILE
HORIZ. 1"=40'
VERT. 1"=5'

LAI 2 MAIN 6 S.W. INTERCEPTOR
PROJ. NO. DBKL573030
LINE NO. 1 SHEET 2 OF 5

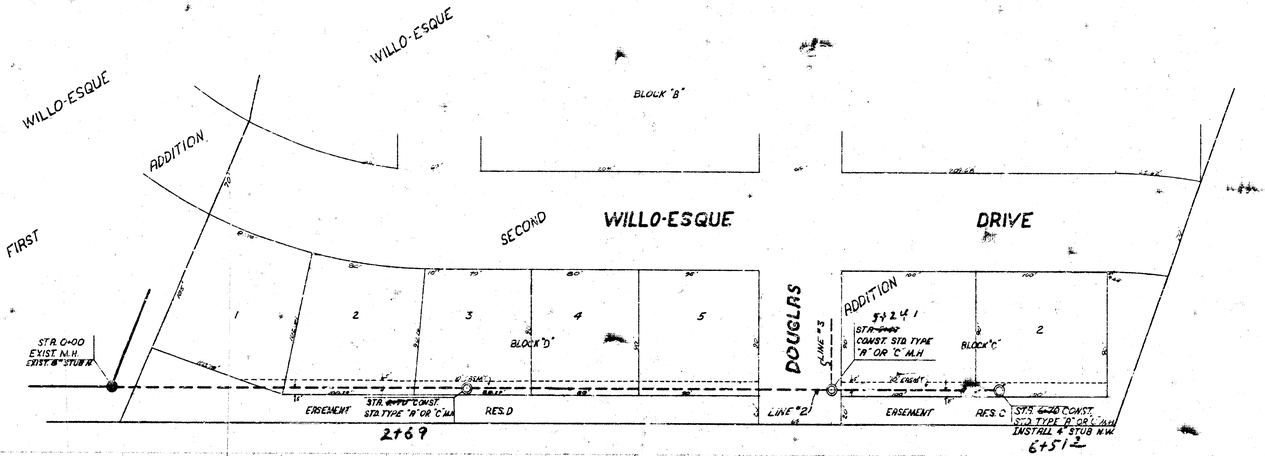

SCALE
PLAN 1"=40'
PROFILE HORT 1"=40'
VERT 1"=5'

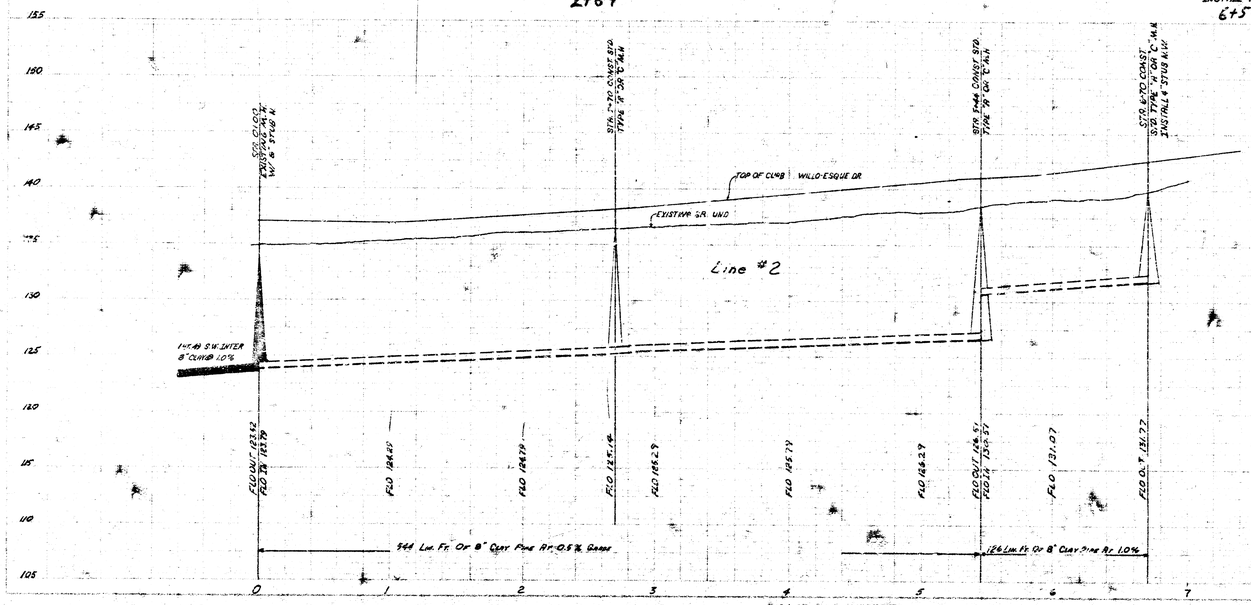

LAT. 2, MAIN 6, S.W. INTERCEPTOR
LINE #2 PROJ. NO. DBKL573030
SHEET 3 OF 5

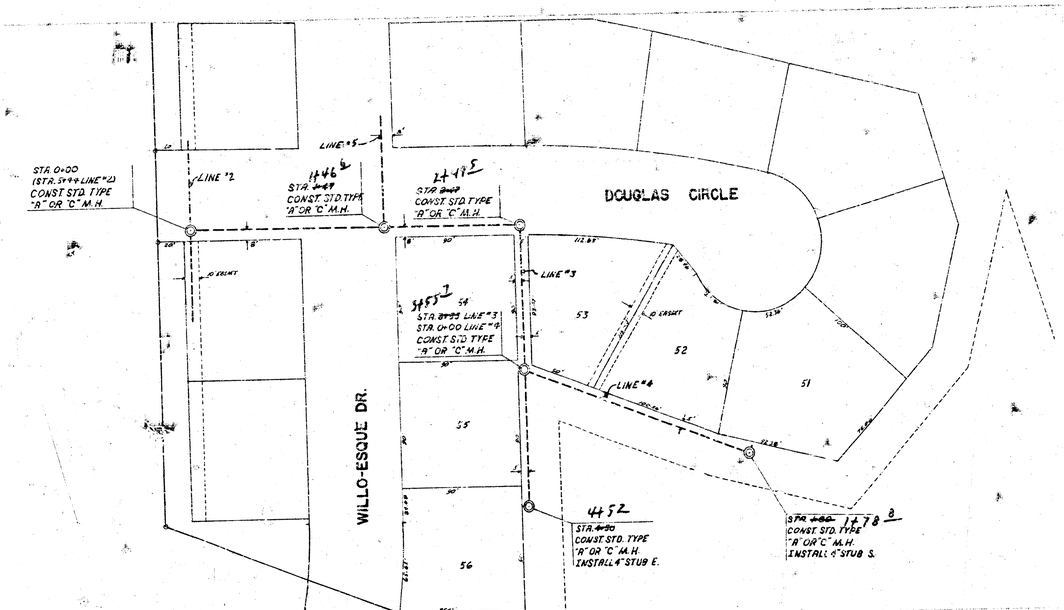

SCALE
PLAN 1"=40'
PROFILE
HOR. 1"=40'
VERT. 1"=5'

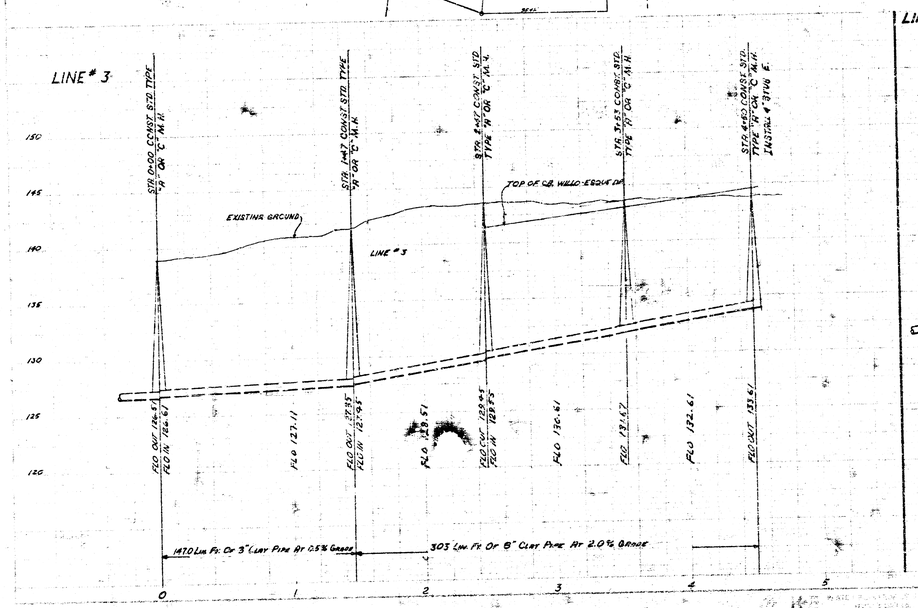

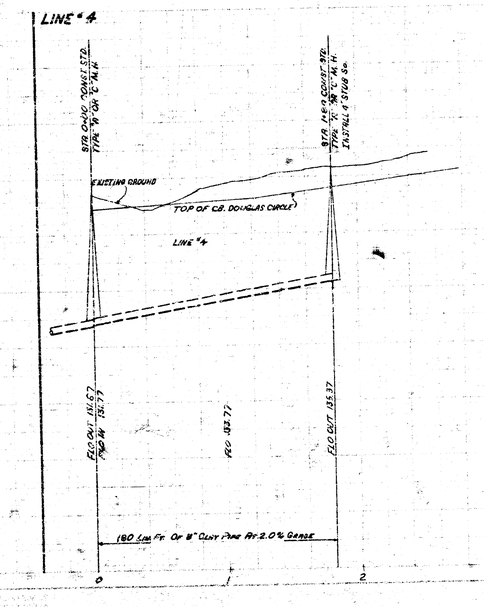

LAT. 2 MAIN 6 S.W. INTERCEPTOR
LINE'S 3+4 PROJ. NO. DBK6573030
SHEET 4 OF 5

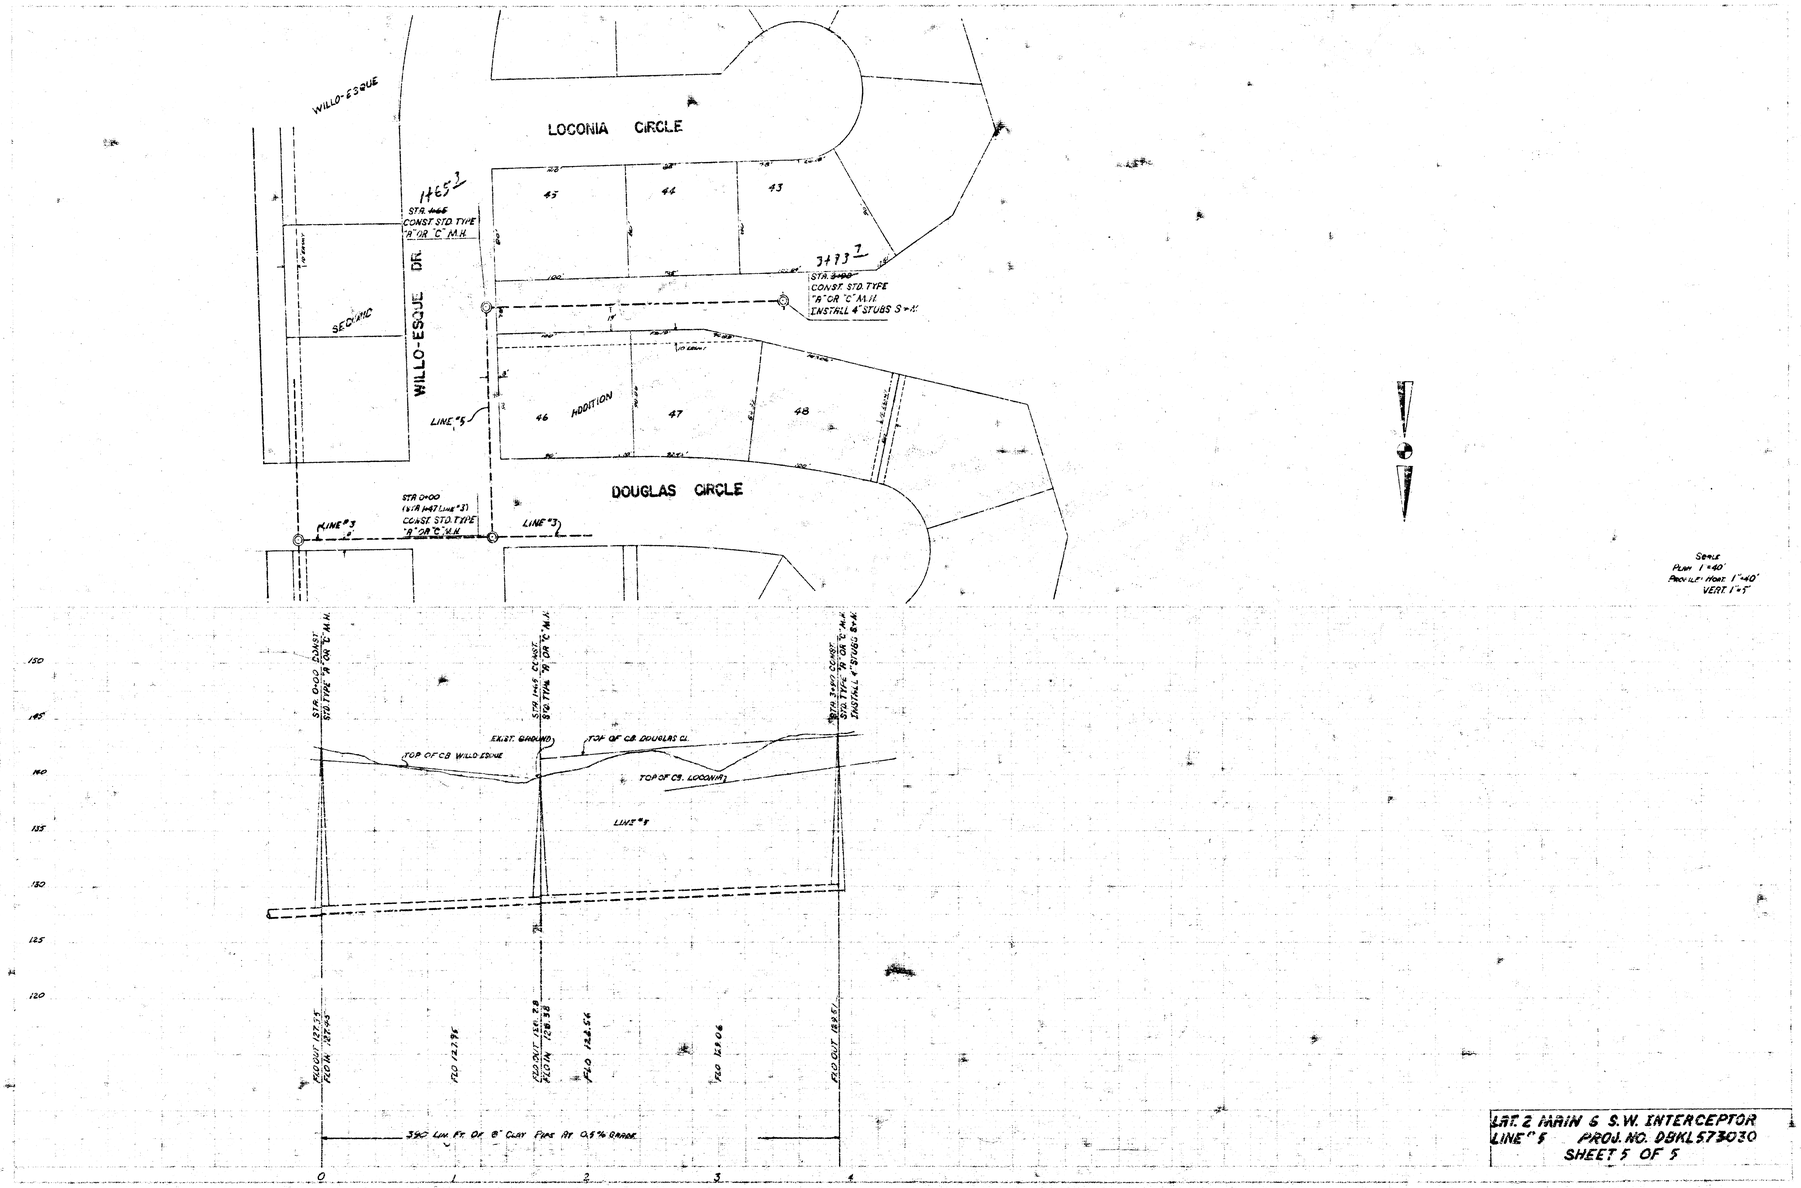

Scale
Plan 1"=40'
Profile Horz 1"=40'
Vert 1"=5'

LAT. 2 MAIN & S.W. INTERCEPTOR
LINE "5" PROJ. NO. DBKL573030
SHEET 5 OF 5

⑧ S 7 - A1