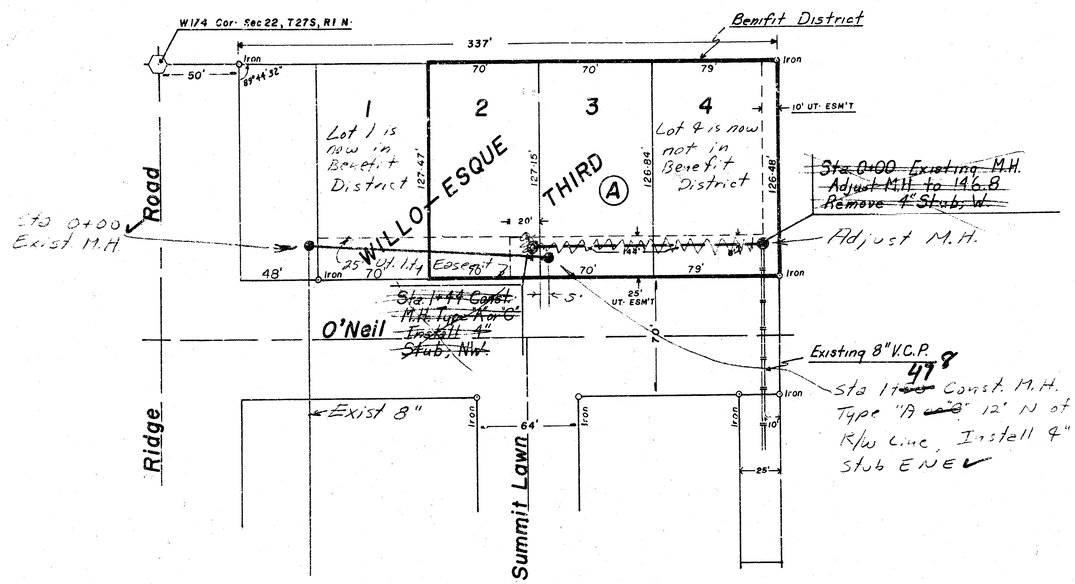

N

Scale:
1" = 40' Plan
Horz. 1" = 40' Profile
Vert. 1" = 5'

B.M.: 144.96 City Std. Disc, 39.5' N. & 48' W. of ℄ of Ridge Rd. & Second St.

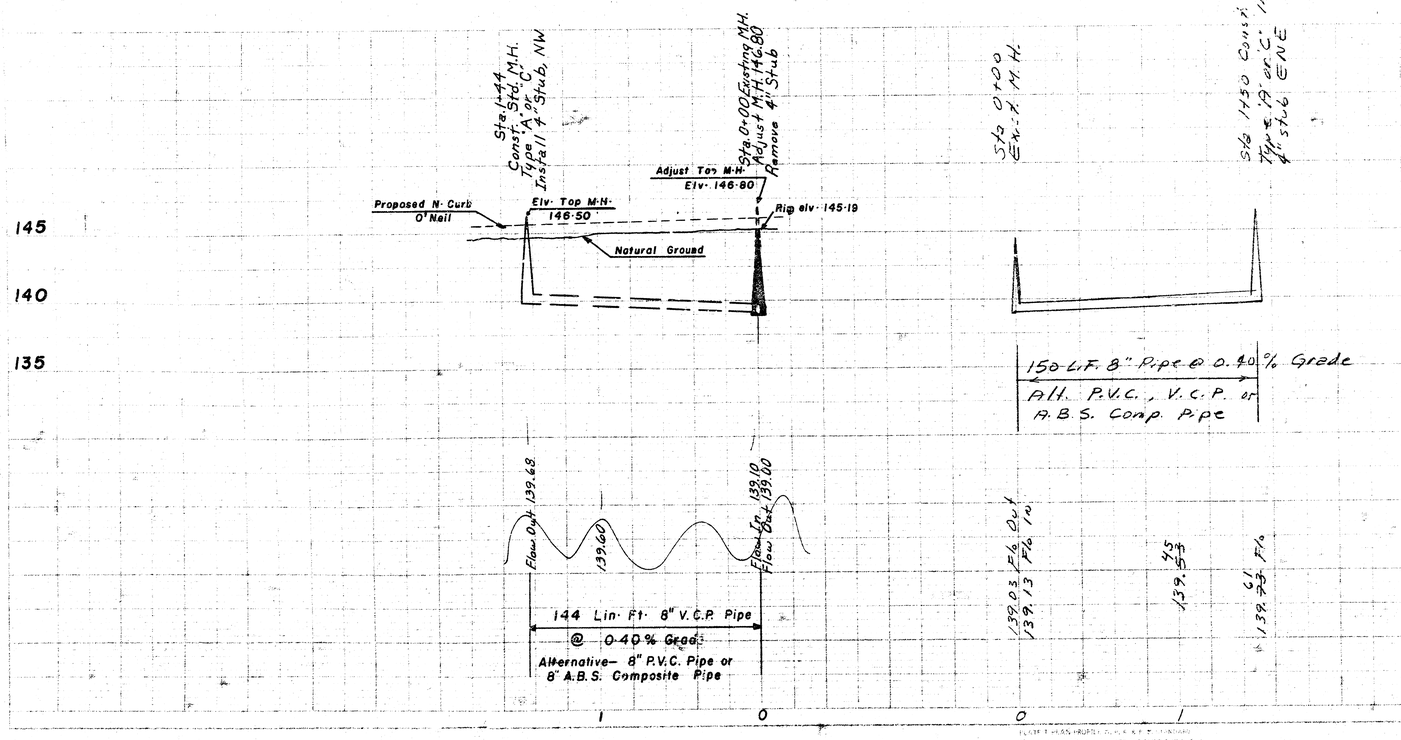

As Built
8/8
1/82

DONALD C. SCHNEIDER
LICENSED
6311
KANSAS
PROFESSIONAL ENGINEER

LAT. 4, MAIN 6, S.W.I.
CITY OF WICHITA, KANSAS
R.W. BRUGGEMAN; DIRECTOR OF ENGINEERING/CITY ENGINEER
Proj. NO. 468-76-245-80776-000-000-001
DATE: _____
1/1

14 5 3