Scale Plan 1" = 40'
Profile 1" = 40' Horz.
1" = 5' Vert.

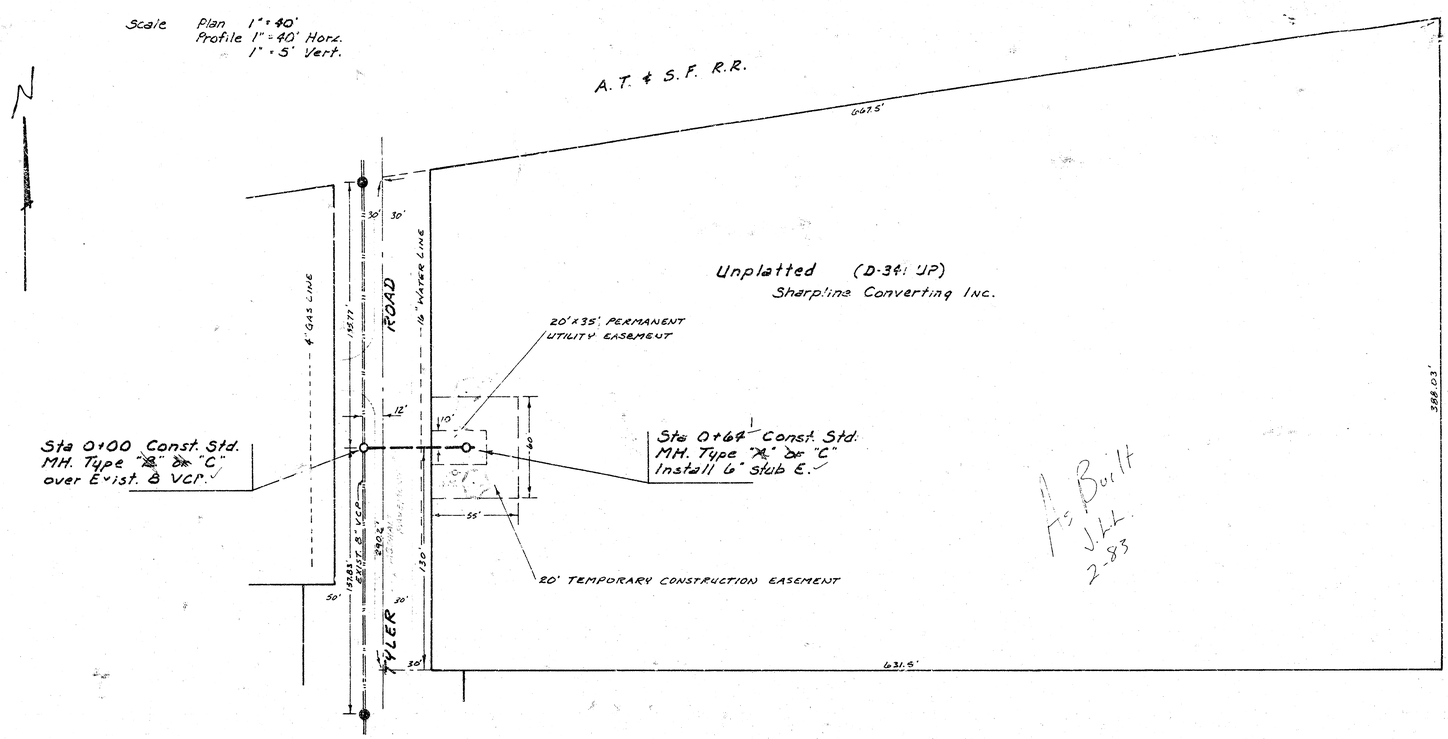

As Built
JLL
2-83

THE CONTRACTOR SHALL BE RESPONSIBLE FOR PRESERVING PROPERTY IRONS. THE CONTRACTOR SHALL BE REQUIRED TO RE-ESTABLISH ANY PROPERTY IRONS WHICH ARE DAMAGED OR DESTROYED BY HIS CONSTRUCTION OPERATIONS. SUCH IRONS SHALL BE RE-ESTABLISHED BY A LICENSED LAND SURVEYOR OR A LICENSED PROFESSIONAL ENGINEER IN ACCORDANCE WITH STATE LAWS.

TBM: Top of the SW 3"ϕ Steel Guard Post of Guard Posts around a Gas Regulater in the NW Quad of the Intersection of Harry St. and Tyler Road. Elev. 143.78

TBM: "M" in Mueller on the Top Flange of Fire Hydrant in the SE Quad of the Intersection of Kellogg (HWY 54) and Tyler Road. Elev. 142.85

Sta 0+00 Const. Std. MH. Type "B" or "C" over Exist. 8" VCP.

Sta 0+64 Const. Std. MH. Type "A" or "C" Install 6" stub E.

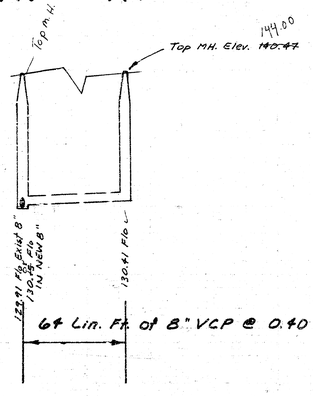

140
135
130

KANSAS LICENSED 8217 ENGINEER

PROJECT DESCRIPTION		
LAT 2, MAIN 3, SOUTHWEST INTERCEPTOR		
PROJECT NUMBER		
468-76-245-81237-000-000-001		
BOOK NO.	APPROVED BY	DATE
DRAWN BY LOO/MJS		REVISED
CITY OF WICHITA DEPARTMENT OF ENGINEERING		
DIRECTOR OF ENG./CITY ENGINEER R. W. BRUGGEMAN		SCALE

1/1