MAPLE ST.

909.8'

Western Sky Village 5 (2)

MAIZE ROAD

Sta 0+00 Existing M.H.

Sta 1+05.8 Const. Std. Outside Drop M.H. Type "B" Install 8" stubs N. & S.

Sta 4+21.8 Const. Std. M.H. Type "B" Install 8" stubs N. & S.

Sta 7+41.8 Const. Std. M.H. Type "B" Install 8" stubs N. & S.

Sta 10+00

20' Temporary Construction Easement

20' Utility Easement

40' Temporary Construction Easement

B.M. 133.20 City Std. Disc. 43.5' S. and 52.7' E. of ℄ of Maize Road and Maple St.

B.M. 134.55 Brass Plug SE. corner E. Headwall 3'x7' RCB on Maize Rd., 470'± N. of ℄ of Maple

B.M. 143.06 "A" center Headwall S. end R.C.B., S. side Maple ½ mile W. of Maize Road.

Scale Plan 1" = 40'
Profile 1" = 40' Horz.
1" = 5' Vert.

Existing Ground

105.8 L.F. of 15" A.B.S. Composite Pipe @ 0.25 % Grade
Alternate 15" P.V.C. Pipe or 15" Clay Pipe


899.2 L.F. of 10" A.B.S. Composite Pipe @ 0.30 % Grade
Alternate 10" P.V.C. Pipe or 10" Clay Pipe

Revised 12-20-79

MAIN 9, S.W. INTERCEPTOR SEWER
CITY OF WICHITA, KANSAS
DEAN SELLERS — CITY ENGINEER
PROJ. NO. 468-76245-80703-000-000001

Sheet 1 of 5

Scale Plan 1" = 40'
Profile 1" = 40' Horz
1" = 5' Vert.

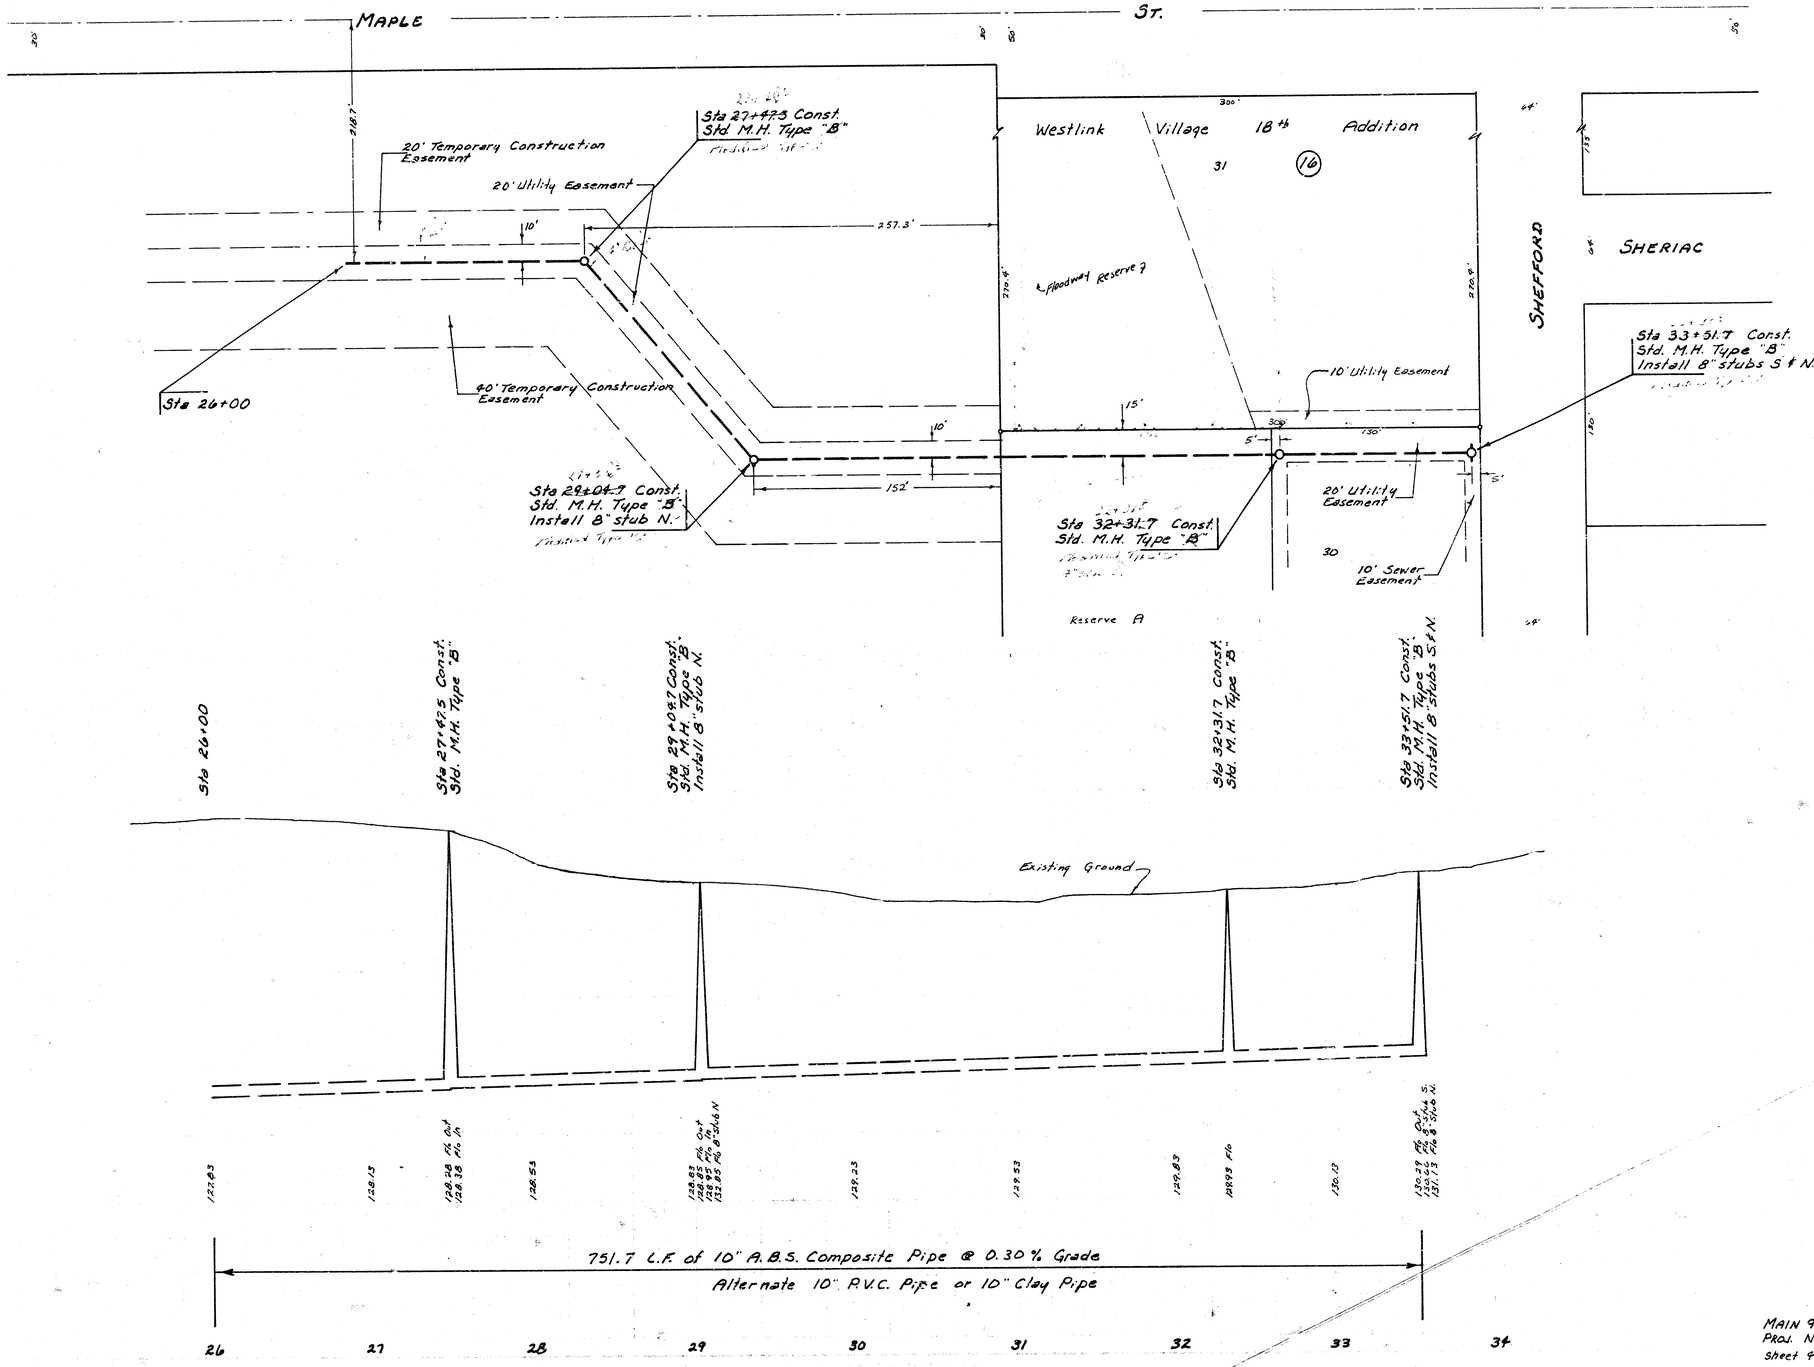

MAIN 9, SOUTHWEST INTERCEPTOR
Proj. No. 468-76285-80703-000-000-001
Sheet 4 of 5

4/4