LATERAL 10, MAIN 9
SOUTHWEST INTERCEPTOR
SEWER

CITY OF WICHITA, KANSAS

M.E. LINDEBAK CITY ENGINEER

As Built 9-85 JF

PROJECT NO. 468-76-245-81463-000-000-001

DATE: JUNE 1985






THE CONTRACTOR SHALL BE RESPONSIBLE FOR PRESERVING PROPERTY IRONS. THE CONTRACTOR SHALL BE REQUIRED TO ESTABLISH ANY PROPERTY IRONS WHICH ARE DAMAGED OR DESTROYED BY HIS CONSTRUCTION OPERATIONS. SUCH IRONS SHALL BE RE-ESTABLISHED BY A LICENSED LAND SURVEYOR OR A LICENSED PROFESSIONAL ENGINEER IN ACCORDANCE WITH STATE LAWS.

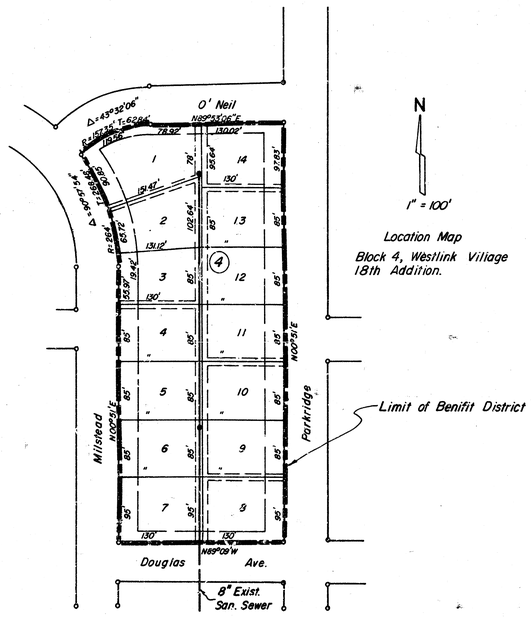

1" = 100'

Location Map
Block 4, Westlink Village 18th Addition.


Limit of Benifit District


MOEHRING & ASSOCIATES
CONSULTING ENGINEERS
WICHITA

DON C. MOEHRING II LICENSED 3463 KANSAS PROFESSIONAL ENGINEER

1/3

FILMED FROM THE BEST AVAILABLE COPY

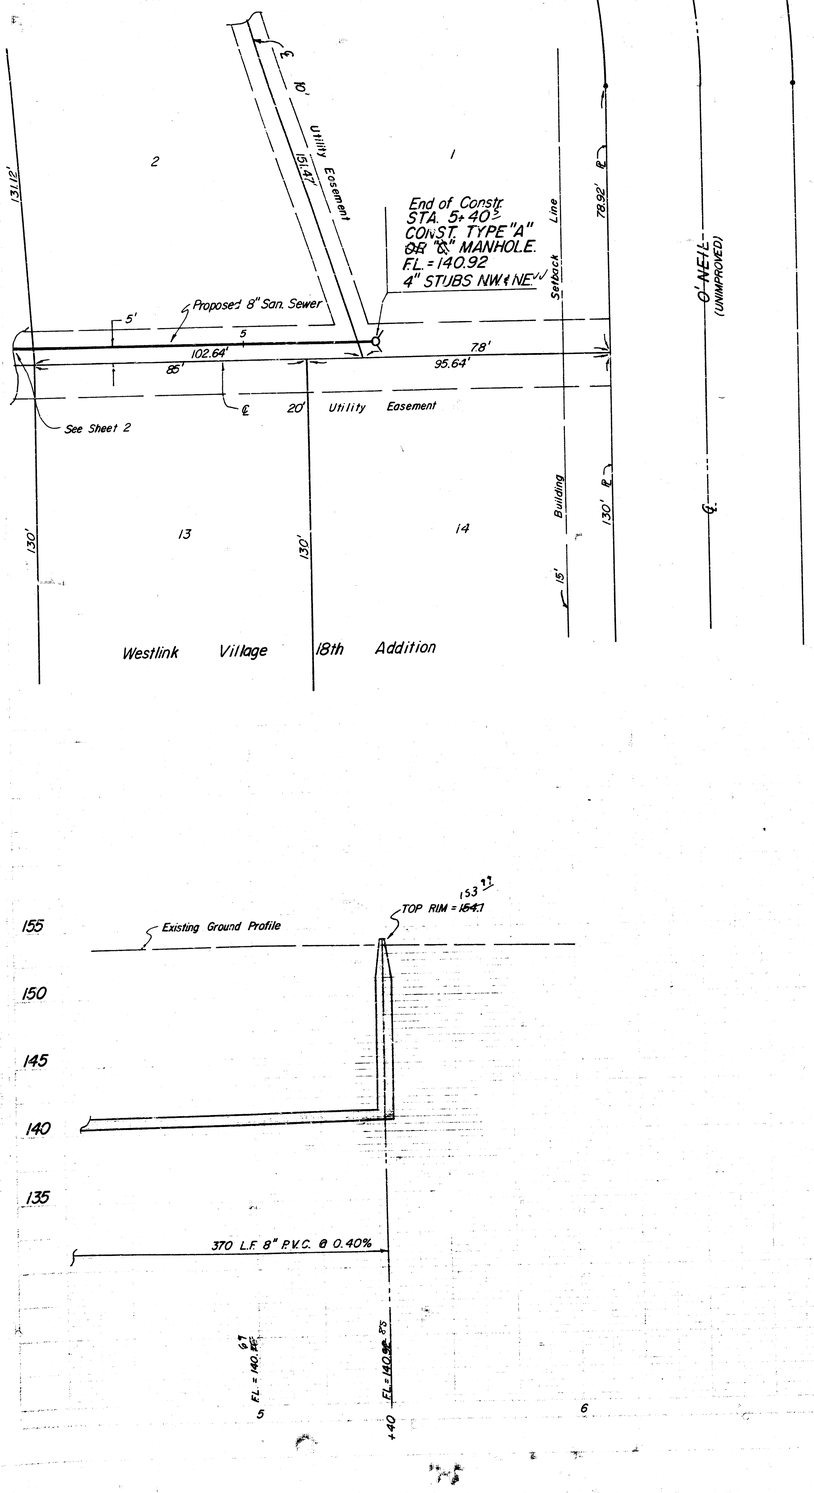

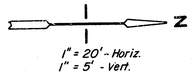

As Built
9-85

DON C. MOEHRING II
LICENSED
3463
KANSAS
PROFESSIONAL ENGINEER

Lateral 10, Main 9, Southwest Interceptor Sewer serving Lots 1 through 14, Block 4, Westlink Village 18th Addition, to Wichita, Sedgwick County, Kansas.


City Project No. 468-76-245-81463-000-000-00

MOEHRING & ASSOCIATES
CONSULTING ENGINEERS
WICHITA

85-058-P

1985 Sheet 3/3

FILMED FROM THE BEST AVAILABLE COPY

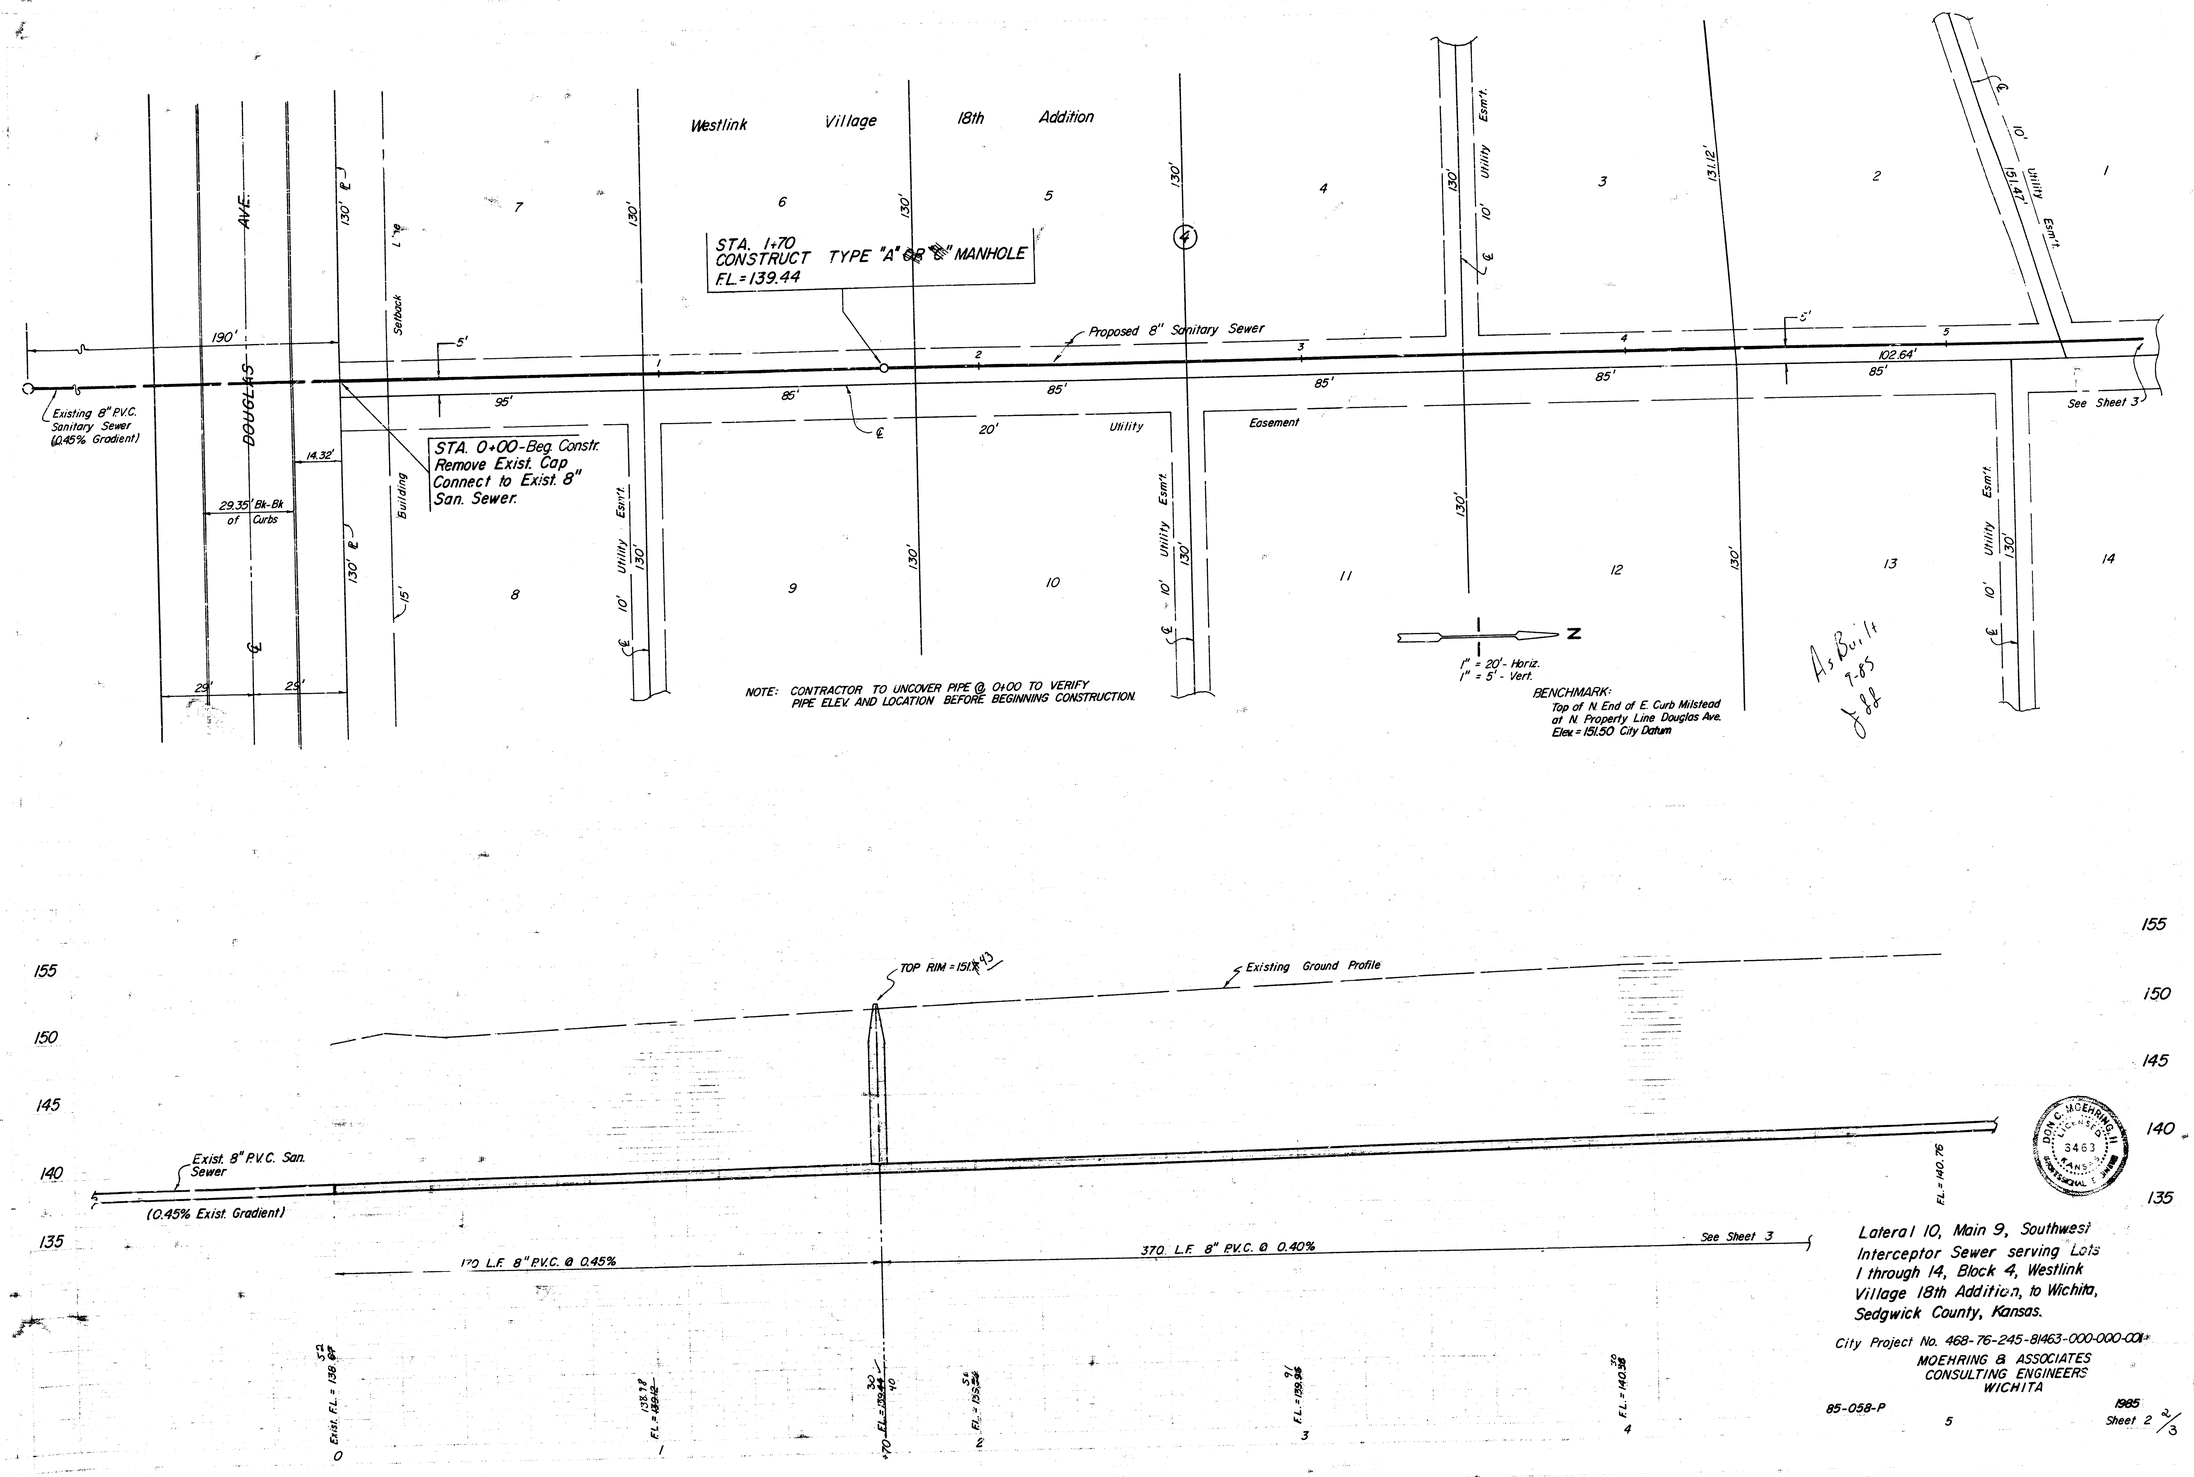

Lateral 10, Main 9, Southwest Interceptor Sewer serving Lots 1 through 14, Block 4, Westlink Village 18th Addition, to Wichita, Sedgwick County, Kansas.

City Project No. 468-76-245-81463-000-000-001

MOEHRING & ASSOCIATES
CONSULTING ENGINEERS
WICHITA

85-058-P

1985

Sheet 2 2/3

FILMED FROM THE BEST AVAILABLE COPY