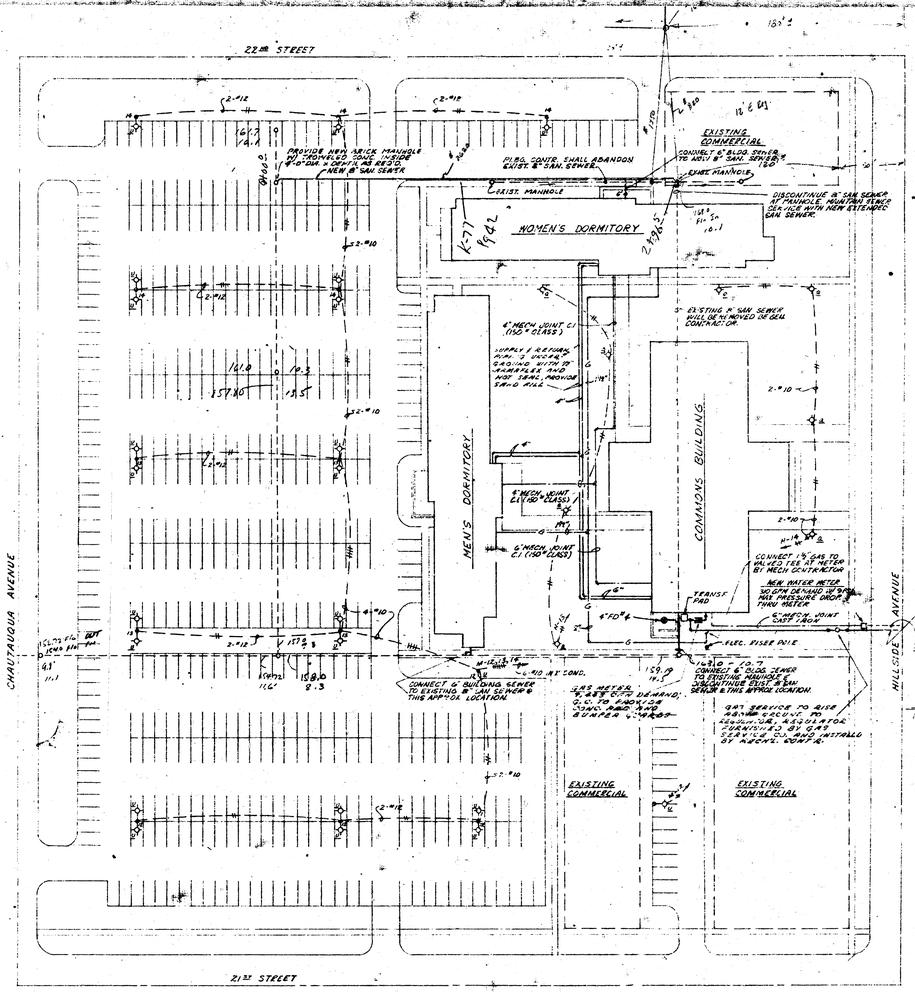


SITE PLAN

SCALE 1" = 40'-0"

NORTH

Booker
Gr-17d
Bk K-77

Relocation of a part of
Lot 3, Dist 13 & 12

DORMITORY COMPLEX FOR WICHITA STATE UNIVERSITY	McGEHEE & NICHOLSON ARCHITECTS 2600 POPLAR AVE. MEMPHIS, TENN.	SITE PLAN	MPE