


B.M. 117.15 STANDARD HYDRAULIC & 19TH.
B.M. 120.23 NO. RIM. ON So. T WIMPLE 17TH & HYDRAULIC.

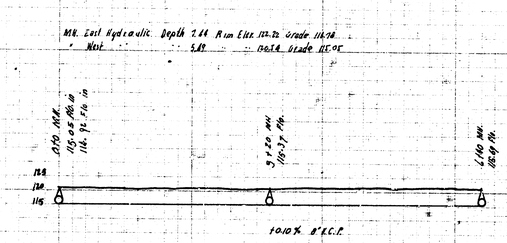

LAKE DISTRICT MAINS
BETWEEN
HYDRAULIC & KANSAS
STREETS IN 1978
CITY OF WICHITA KS.
L.K. WHITE CITY ENG.
Date 8-8-78

e 11 2 3