



B.M. 117.25 Std. N. E. Cor. 17TH & Hydraulic.

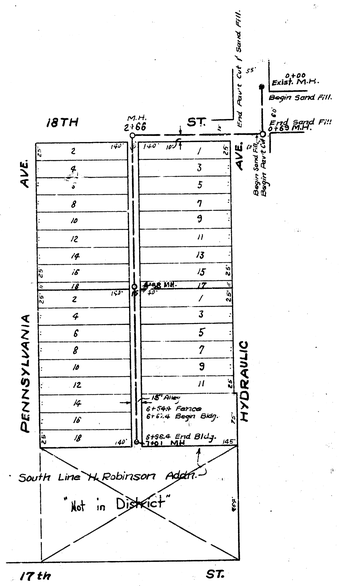


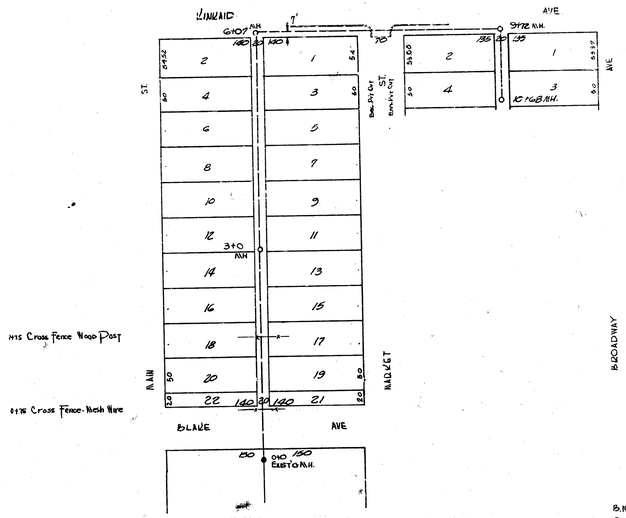




B.M. 1060 Iron Nail Linwood & Main
So. Dist. Nail 96.29

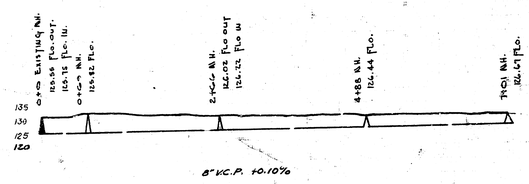

Lat. 16, Dist. T, SS# 12

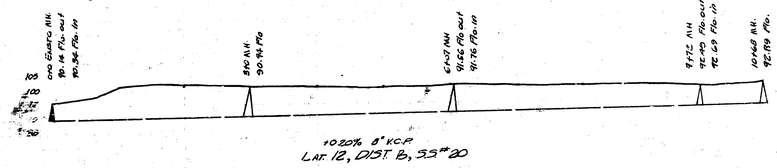

Lat. 12, Dist. B, SS# 20

Lat. 12, Dist. B, SS# 20
Lat. 16, Dist. T, SS# 12

CITY OF WICHITA, KANSAS
L. K. WHITE CITY ENGINEER
1949