



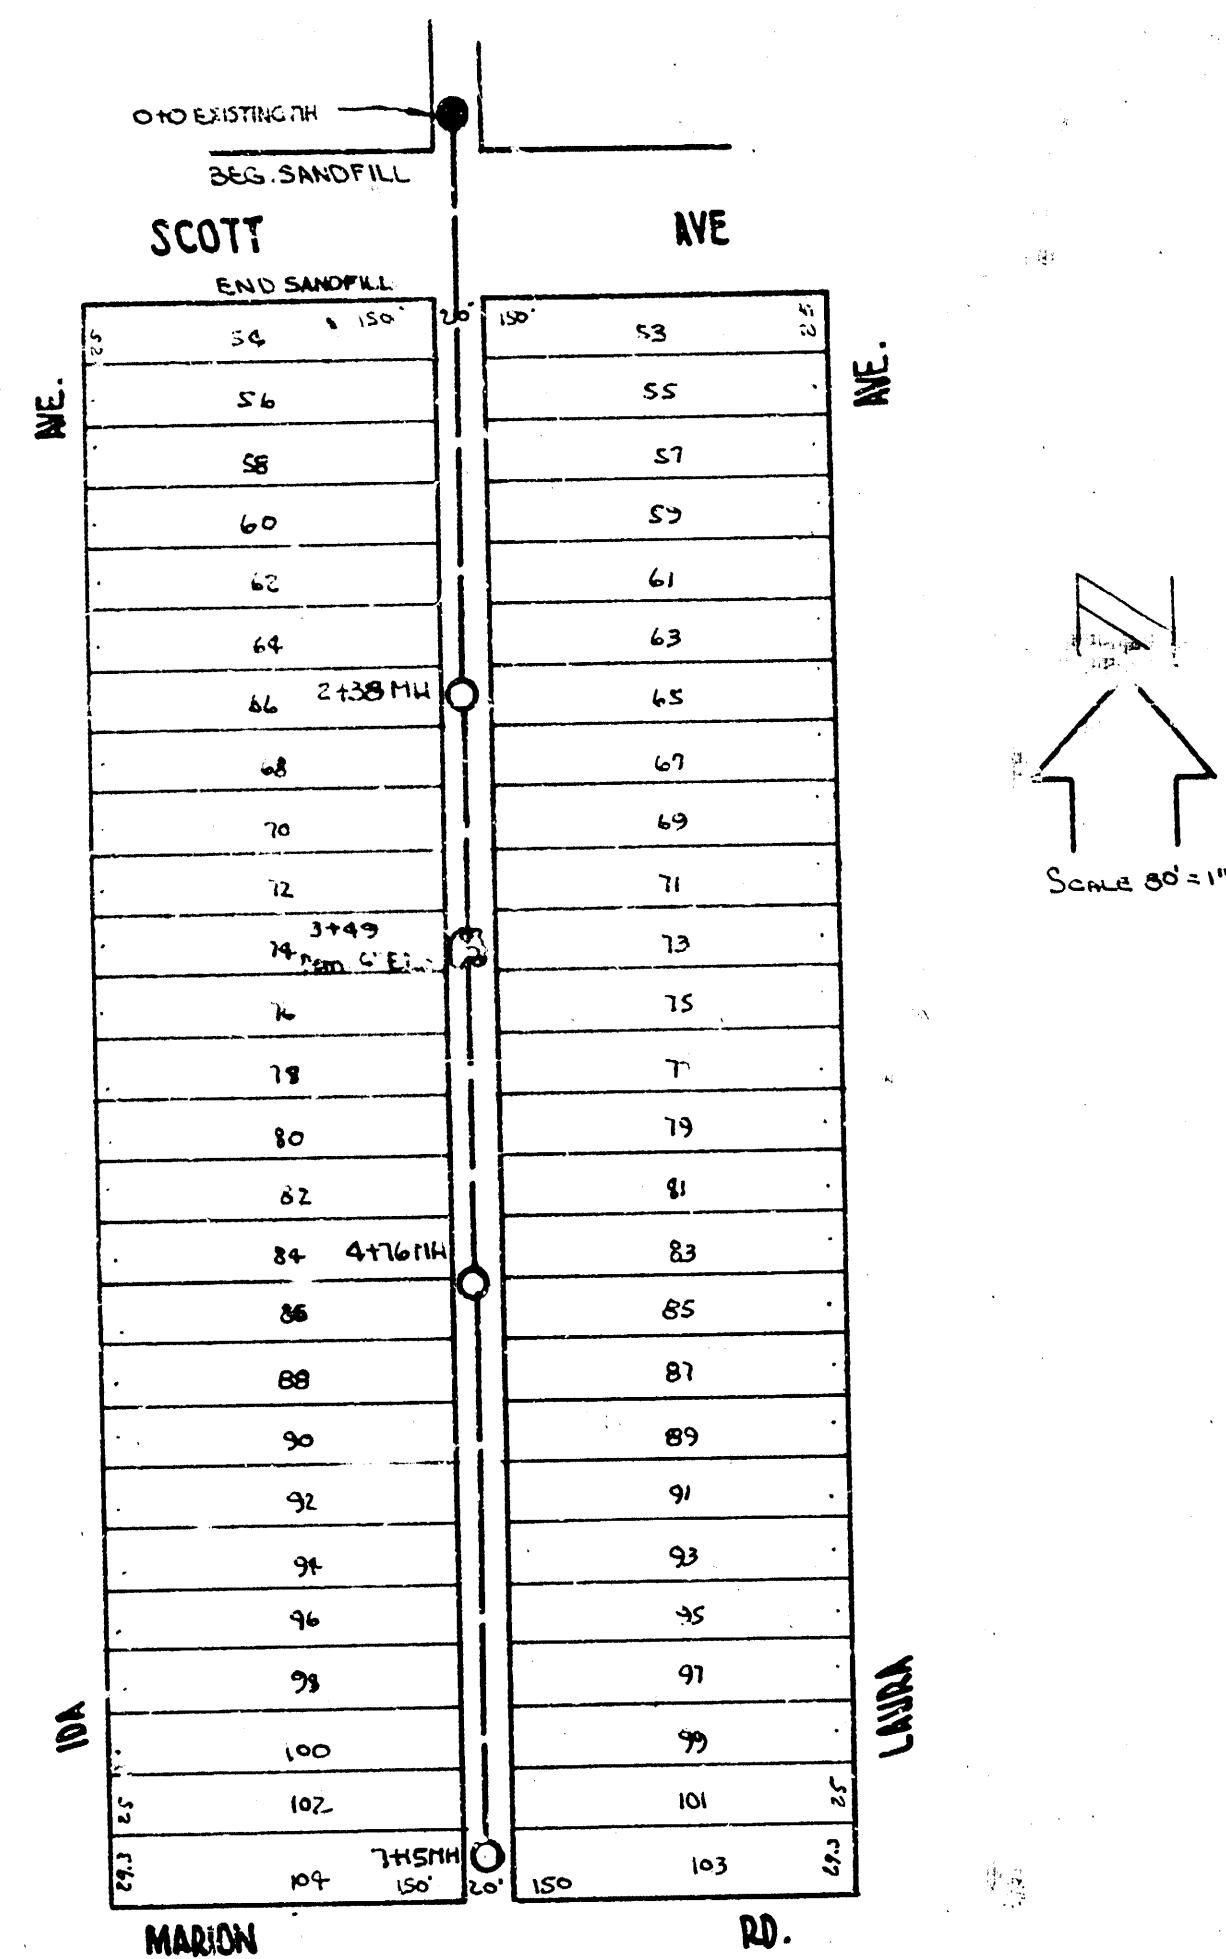


LAT. 14, DIST. R, SS*20

BH. 76.56 E. Side Road So. Side Scott (Sphinx in Base of Rd)

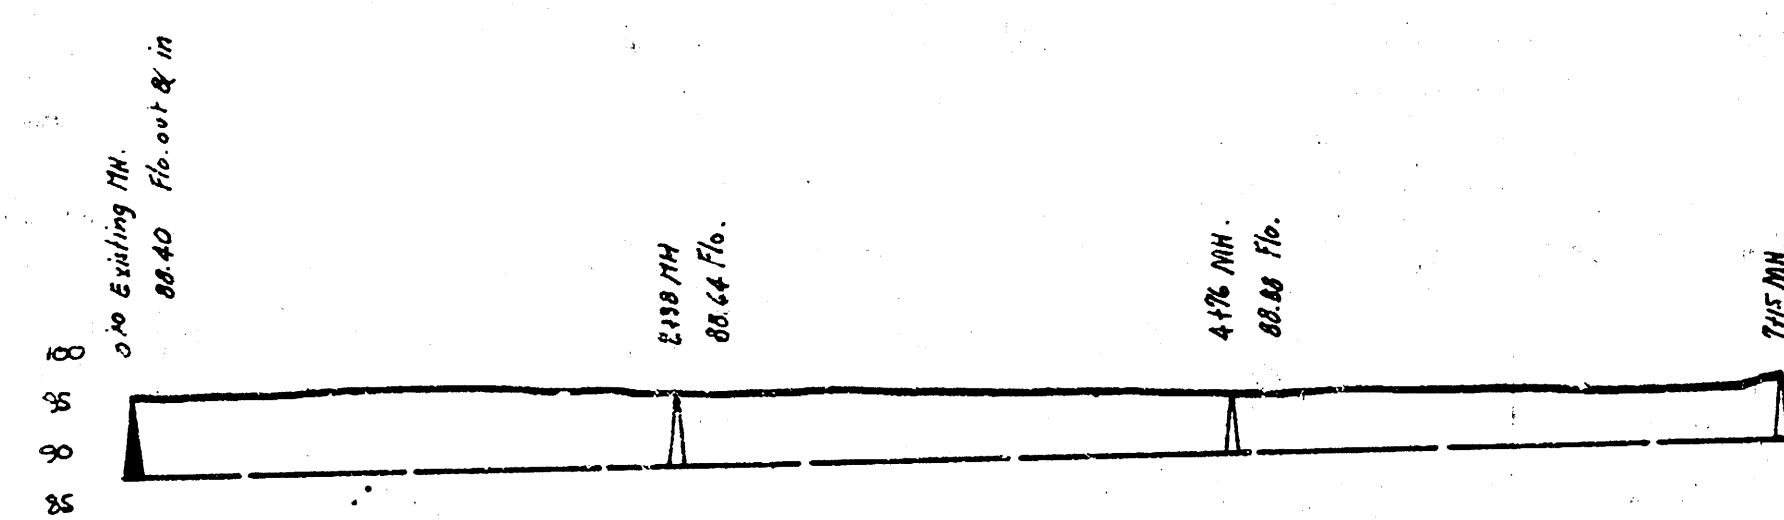


LAT. 14, DIST. R, SS*20

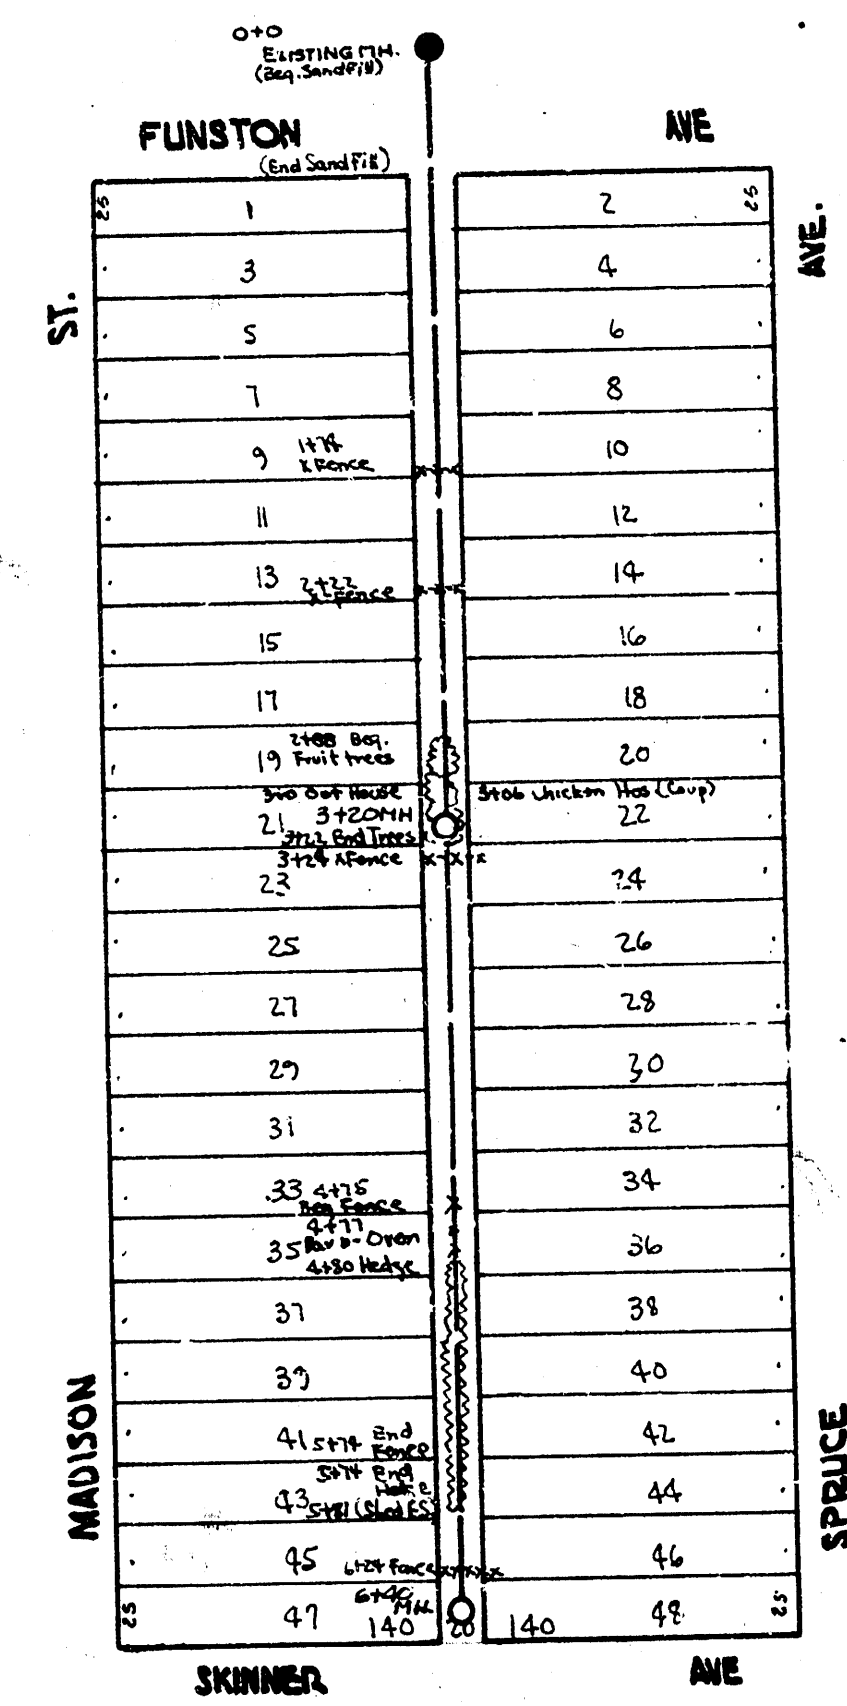


LAT. 10, DIST. AS, SS*12

BH. 79.25 "G" in Gauge So. End N. 46 Spruce & Funston

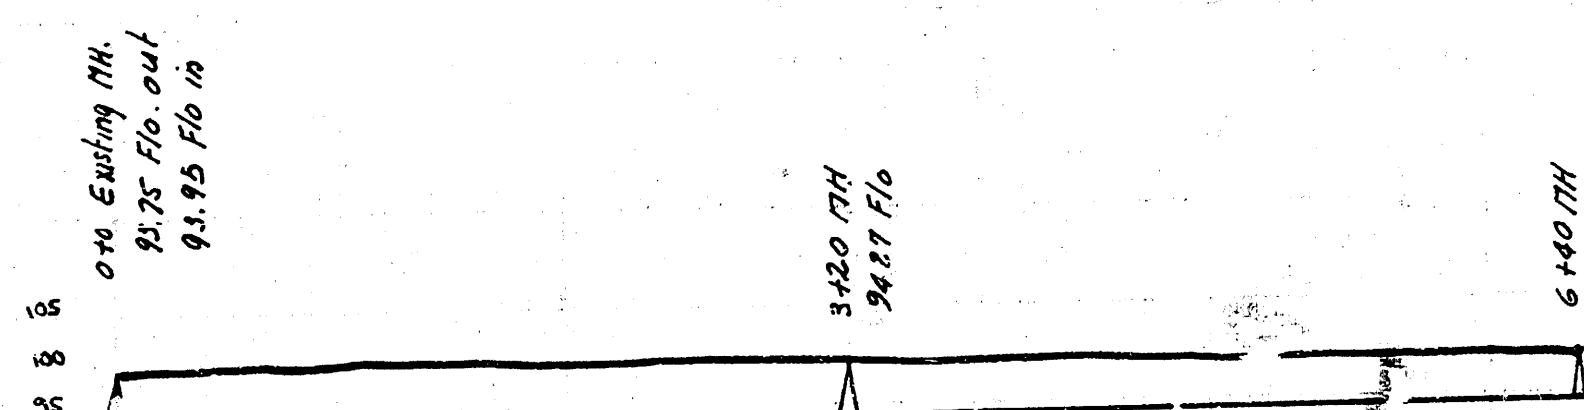


LAT. 10, DIST. AS, SS*12

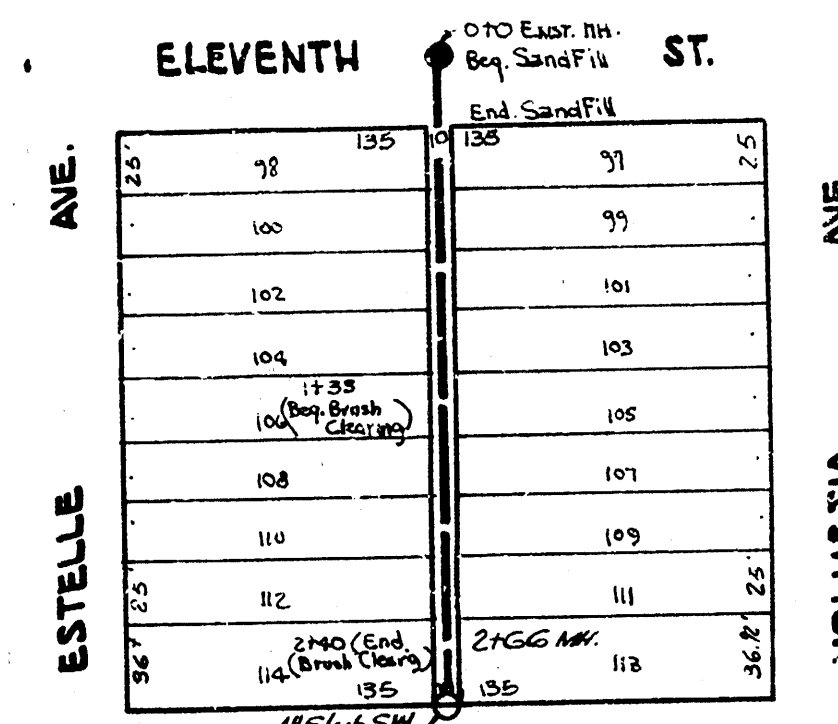


LAT. 12, DIST. E, SS*12


BH. 123.11 No. 21m MH in Eleventh Street.

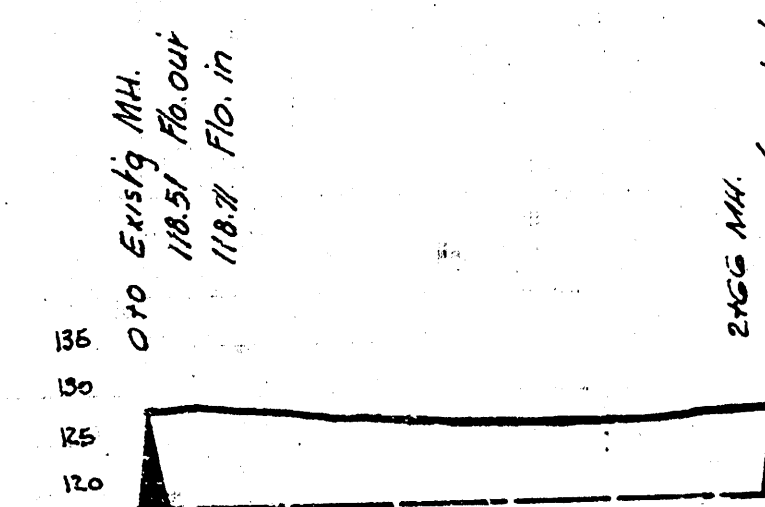

LAT. 12, DIST. E, SS*12

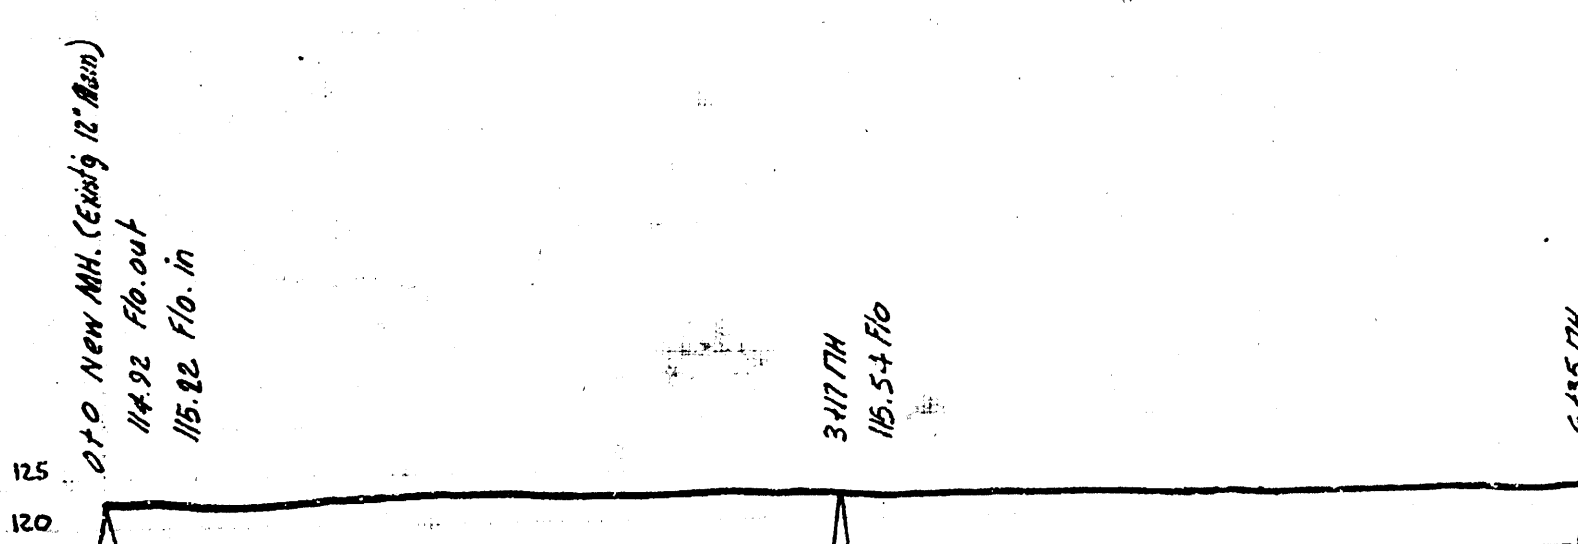

LAT. 17, DIST. T, SS*12

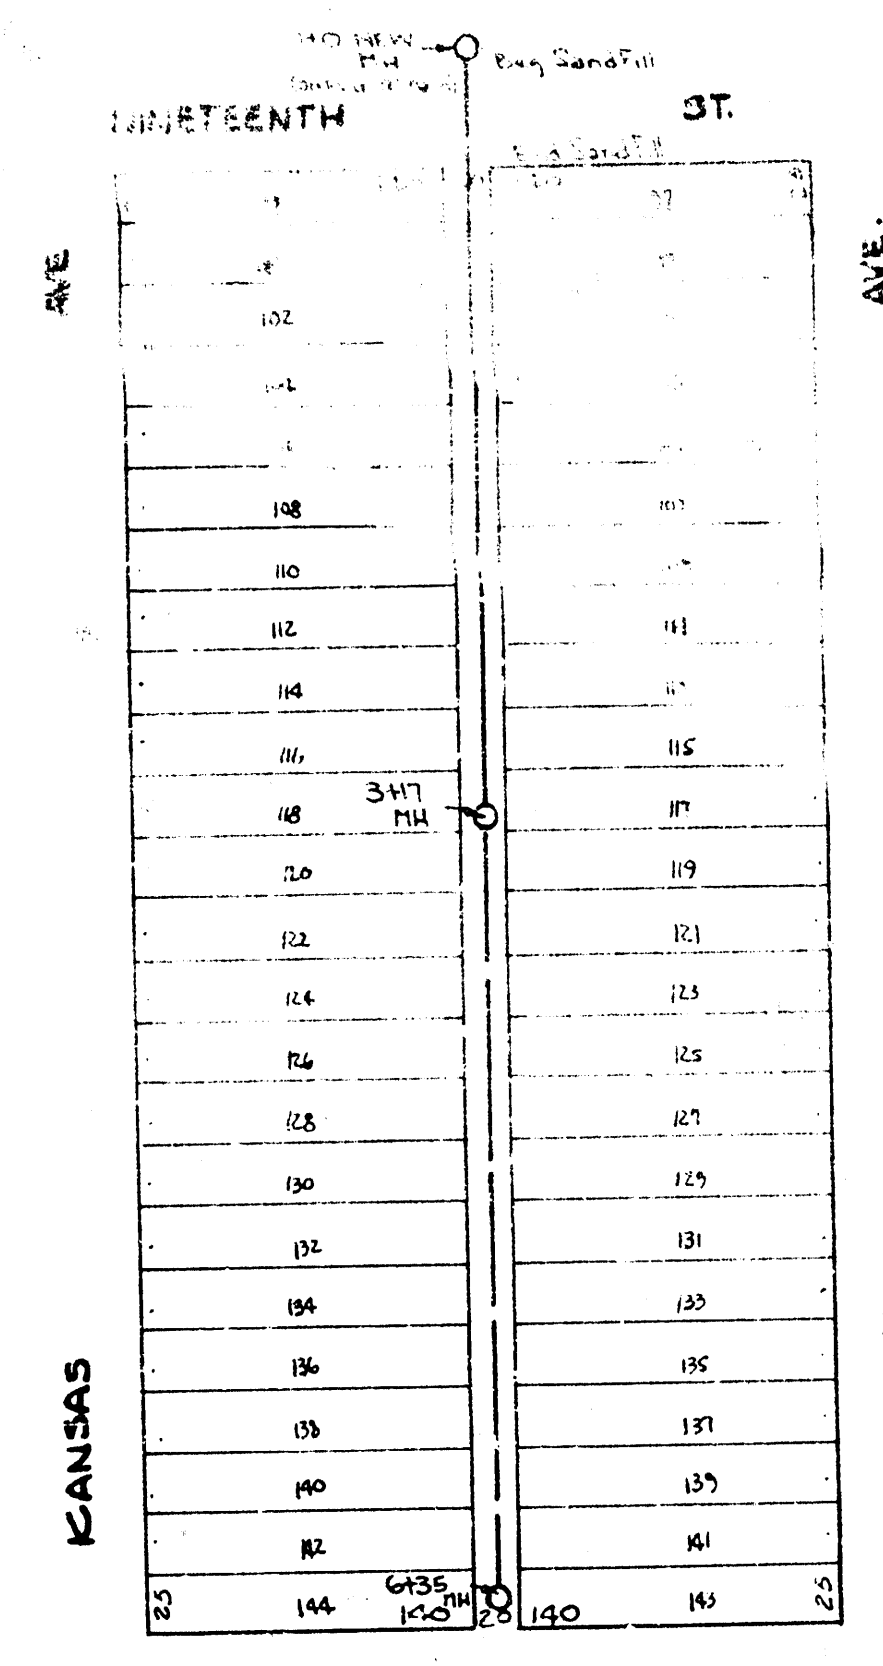

LAT. 17, DIST. T, SS*12

BH. 120.23 No. 21m of So. Spruce 1914 Hydraulic

LAT. 14, DIST. A, SS*20 — LAT. 10, DIST. AS, SS*12

LAT. 12, DIST. E, SS*12 — LAT. 17, DIST. T, SS*12

CITY OF WICHITA, KANSAS

L.C. WHITE - CITY ENGINEER

1949