

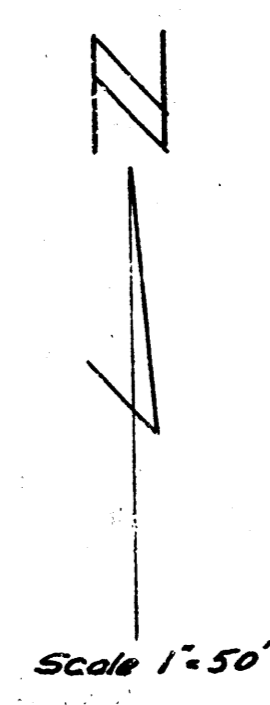
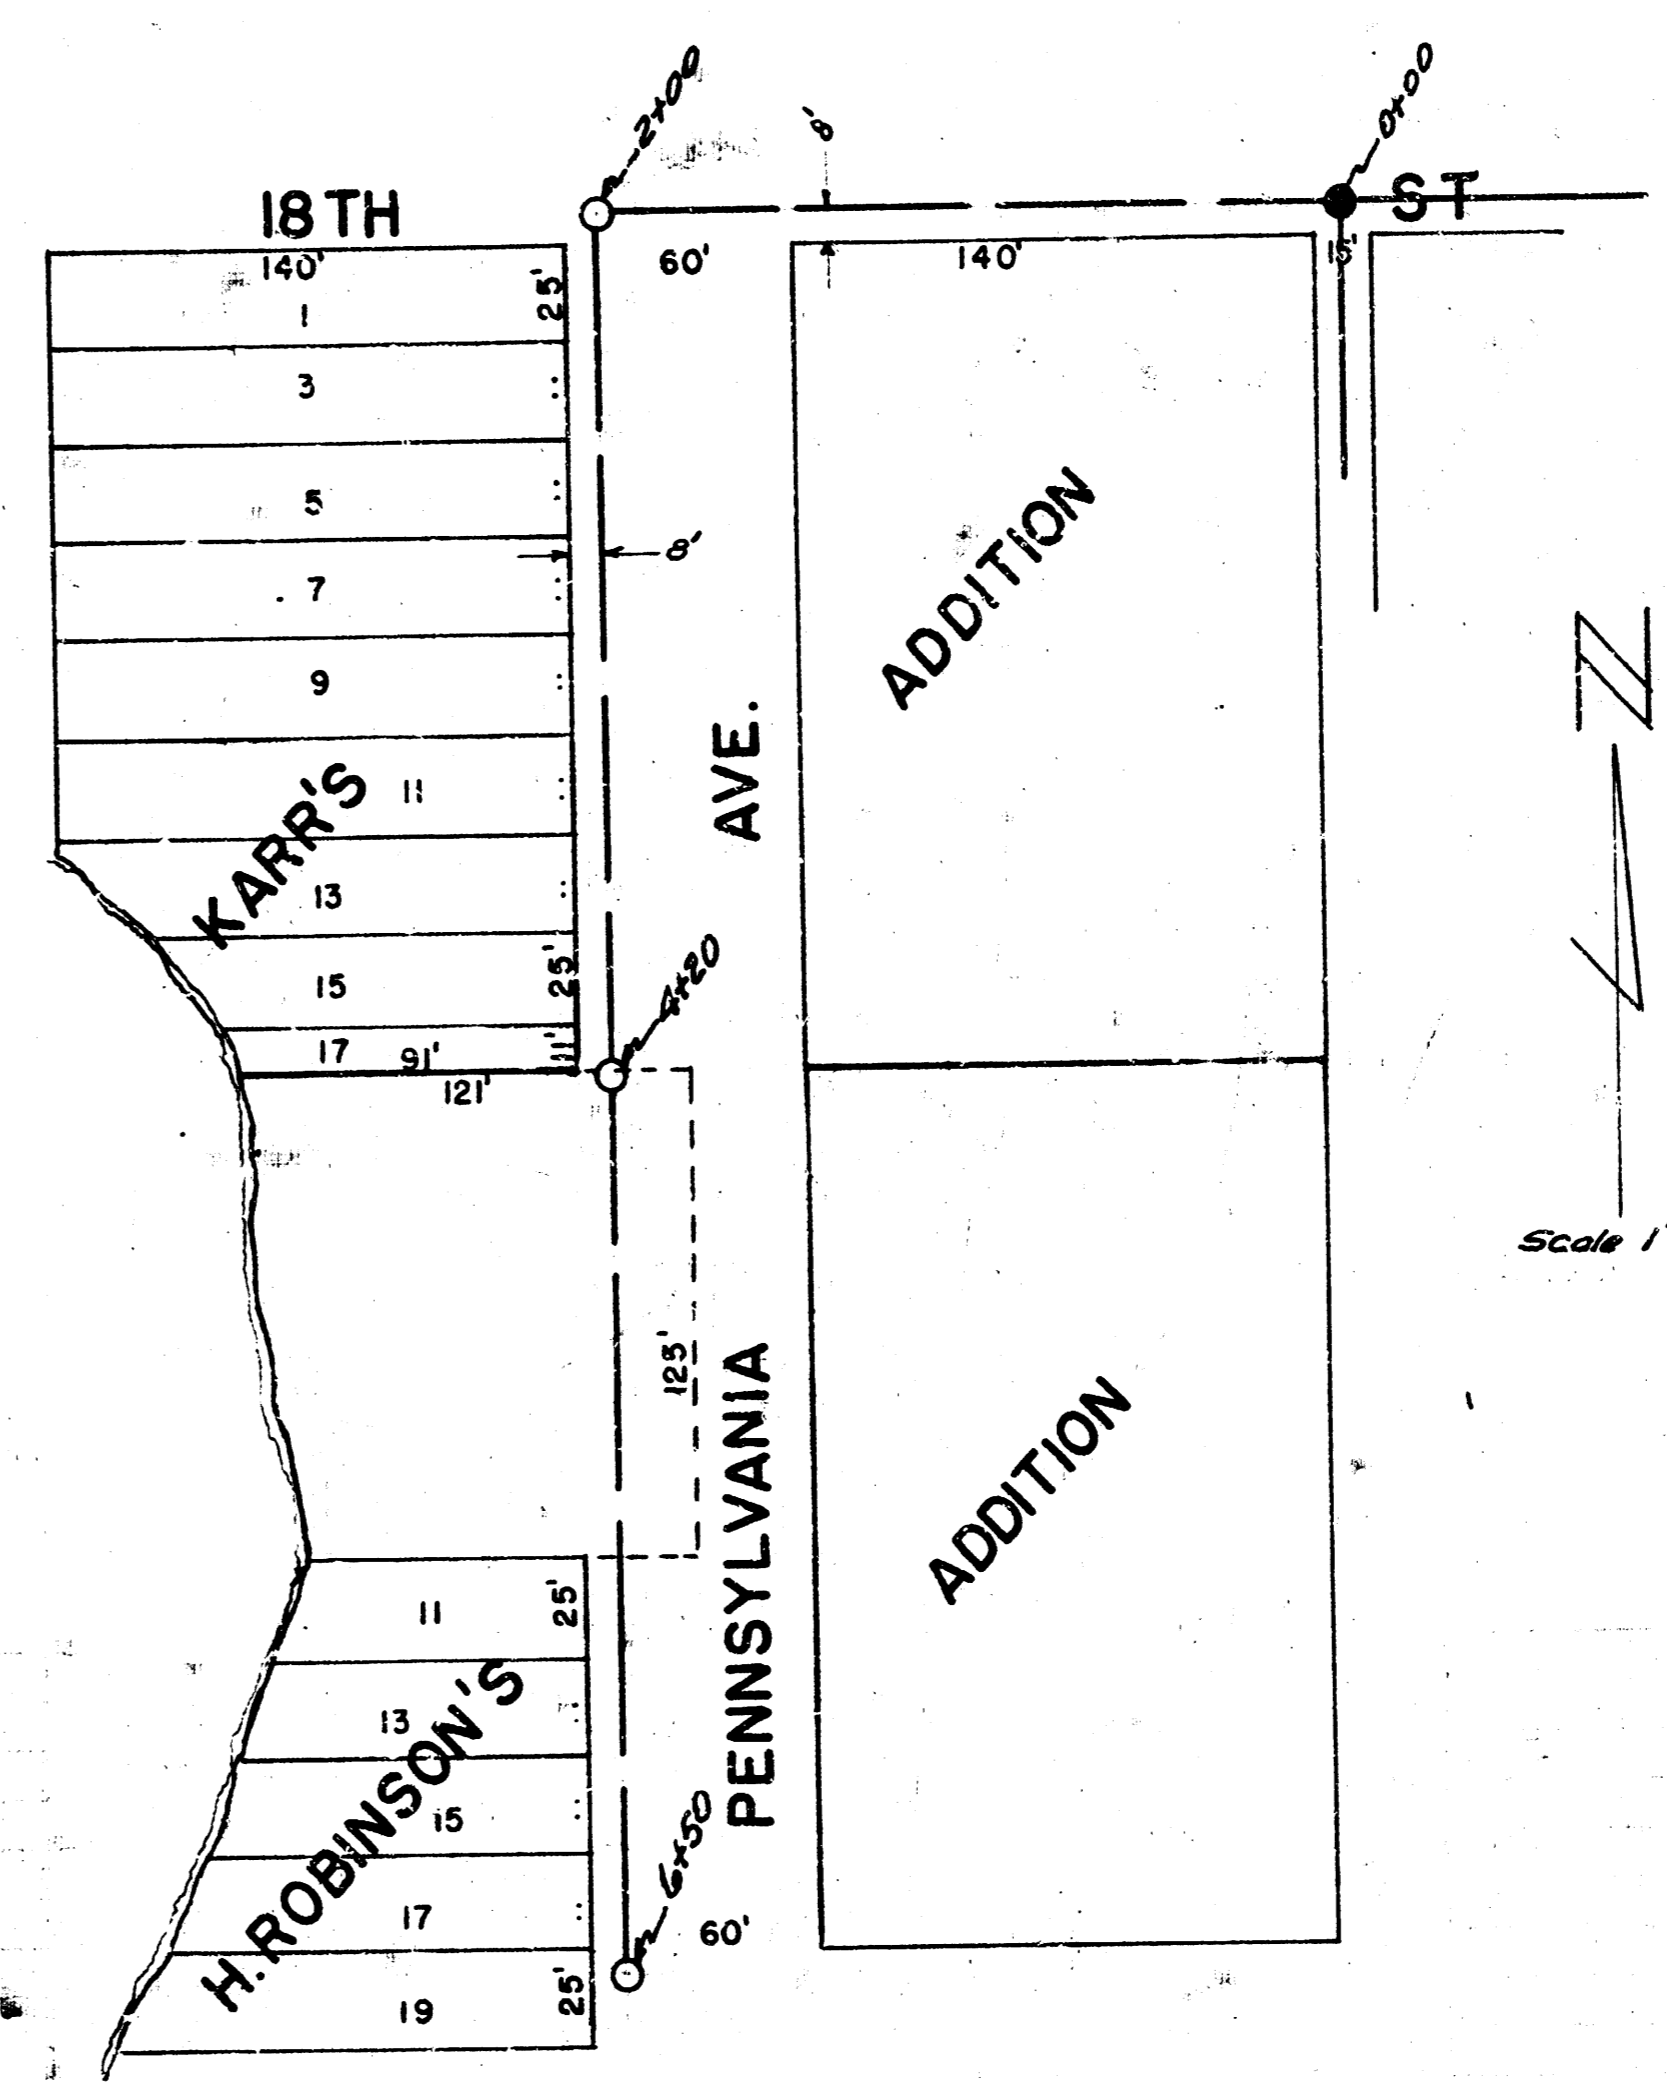
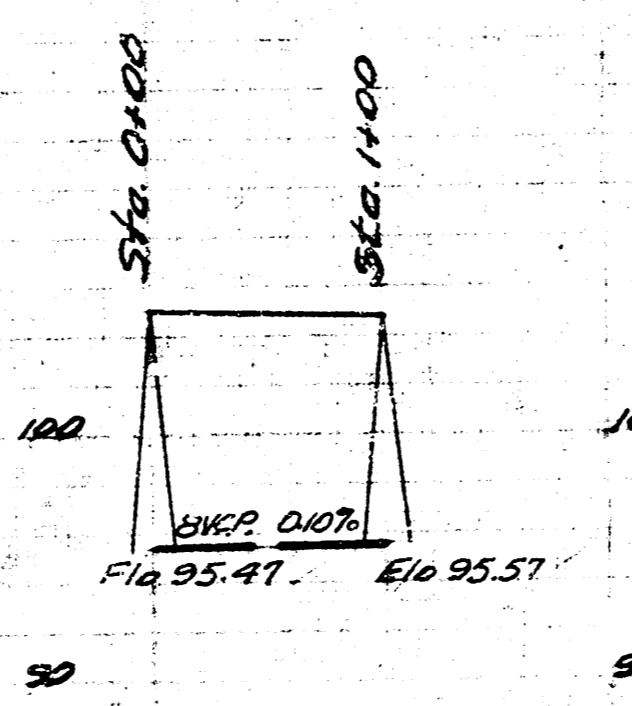
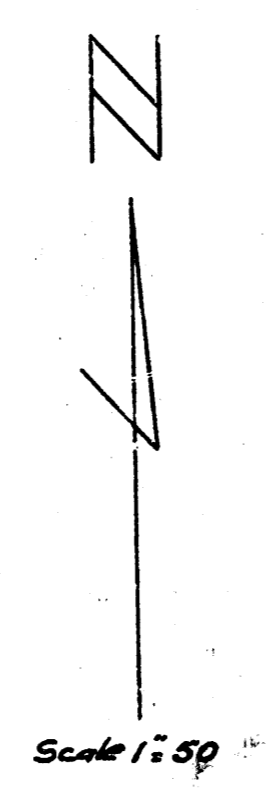
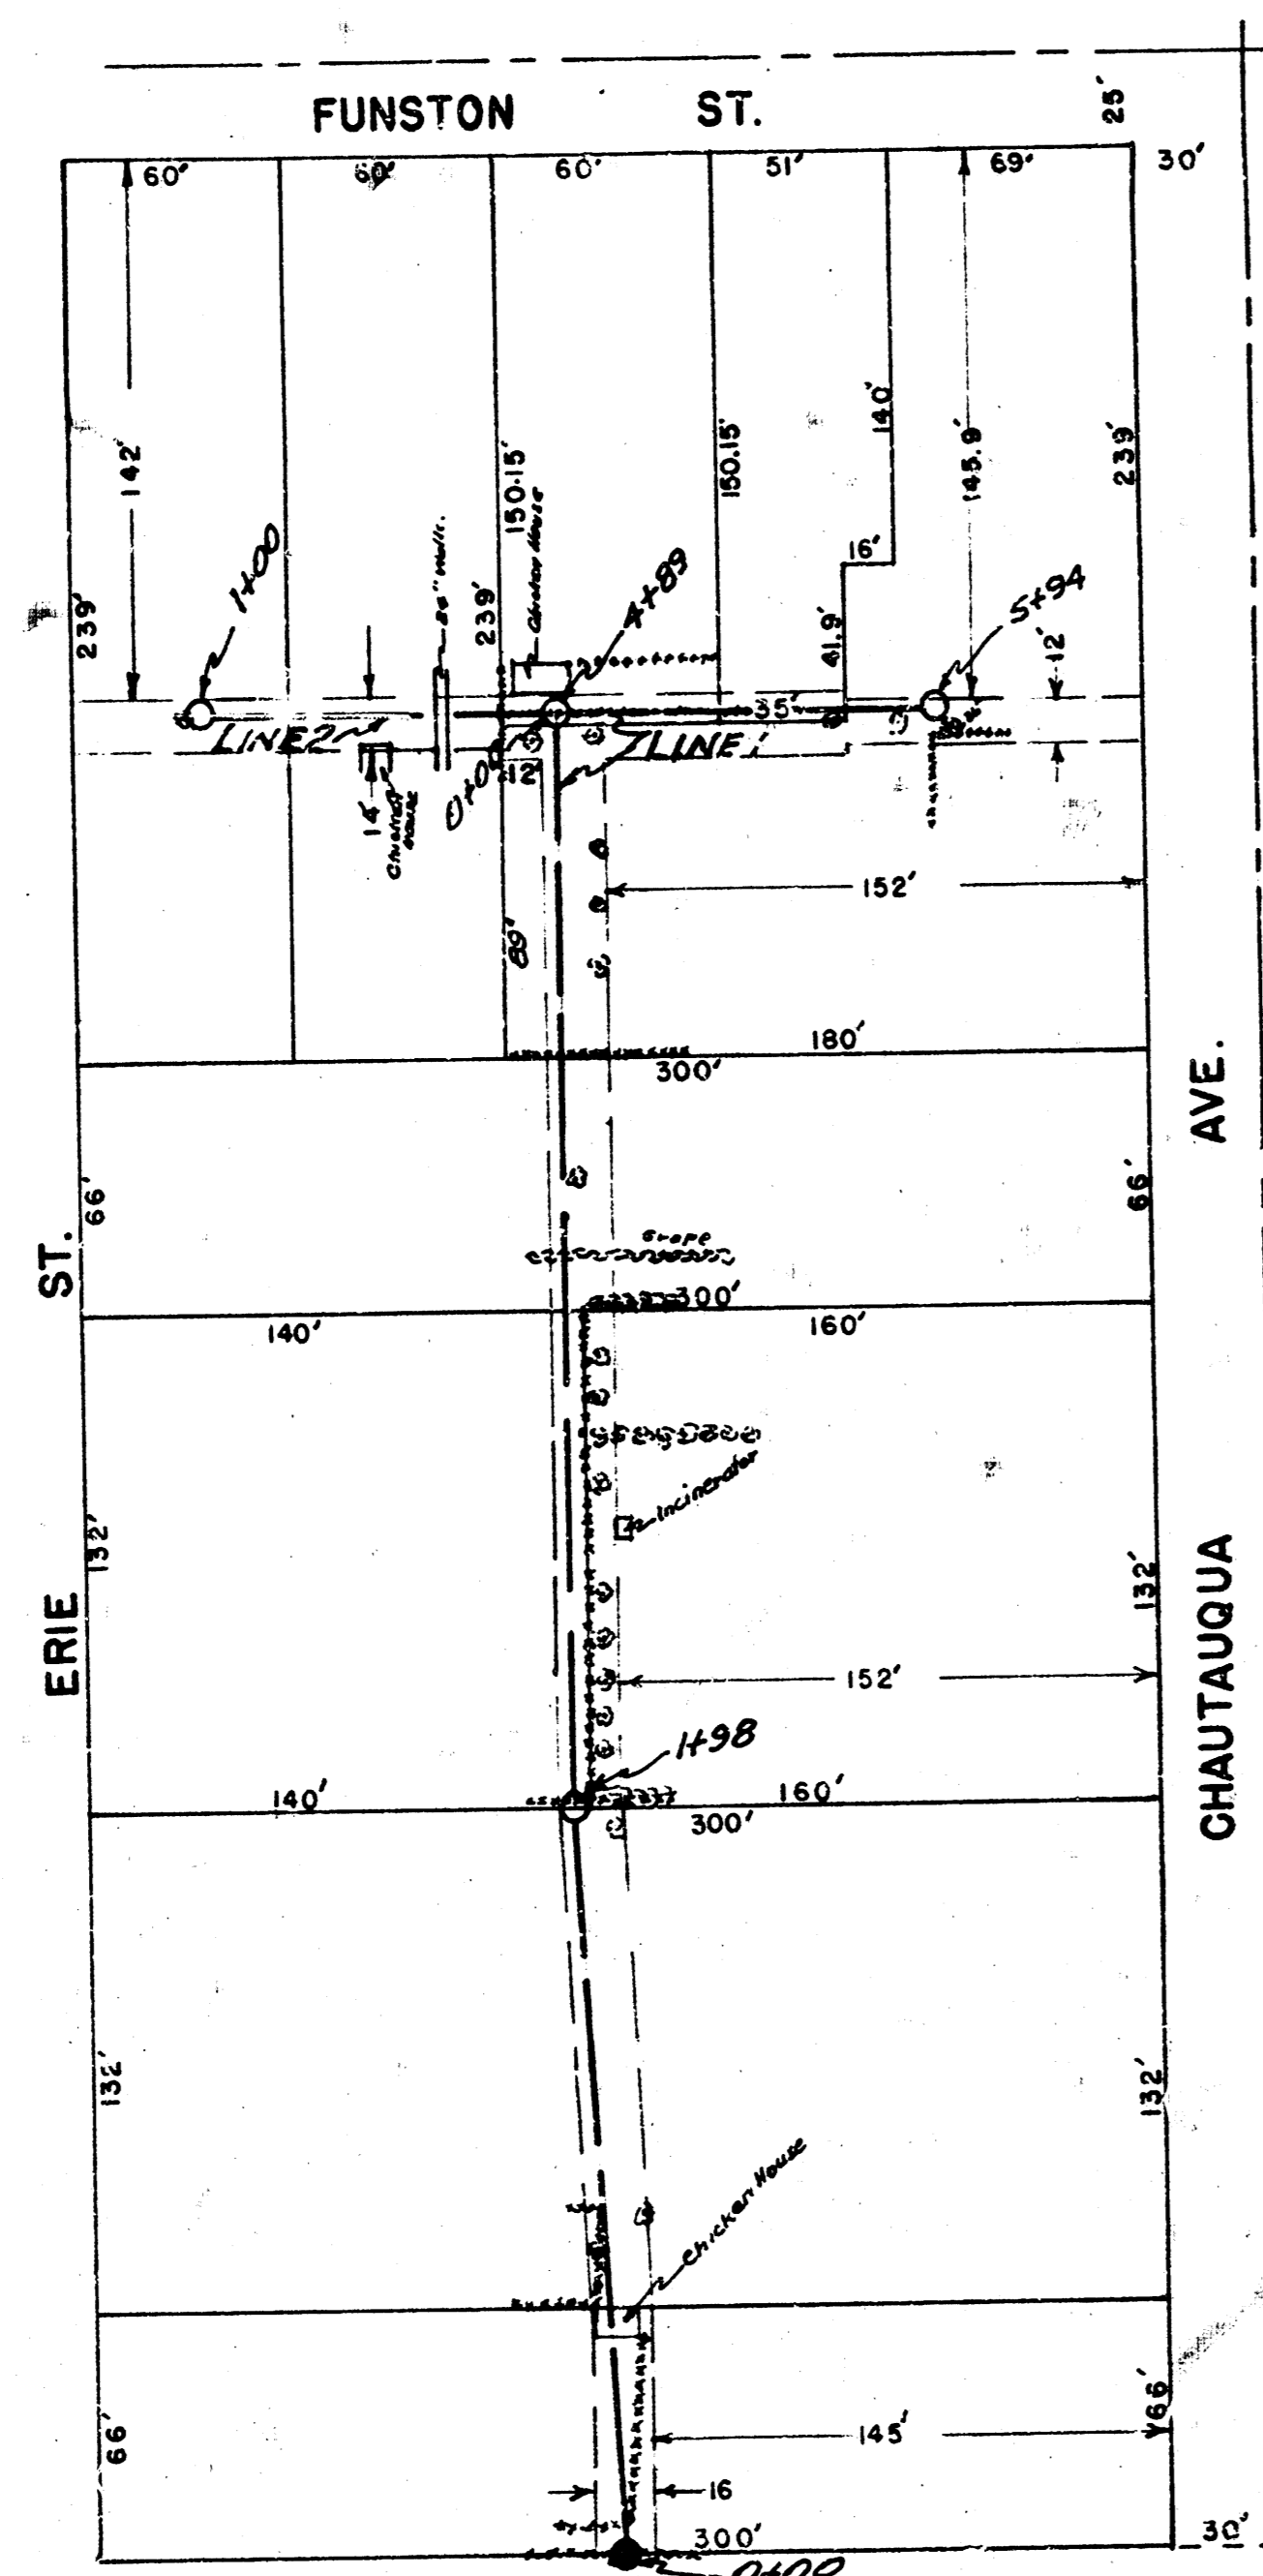


Date  
7-18-52  
Drawn by  
L. McClain  
Checked by  
Book No. 46-24

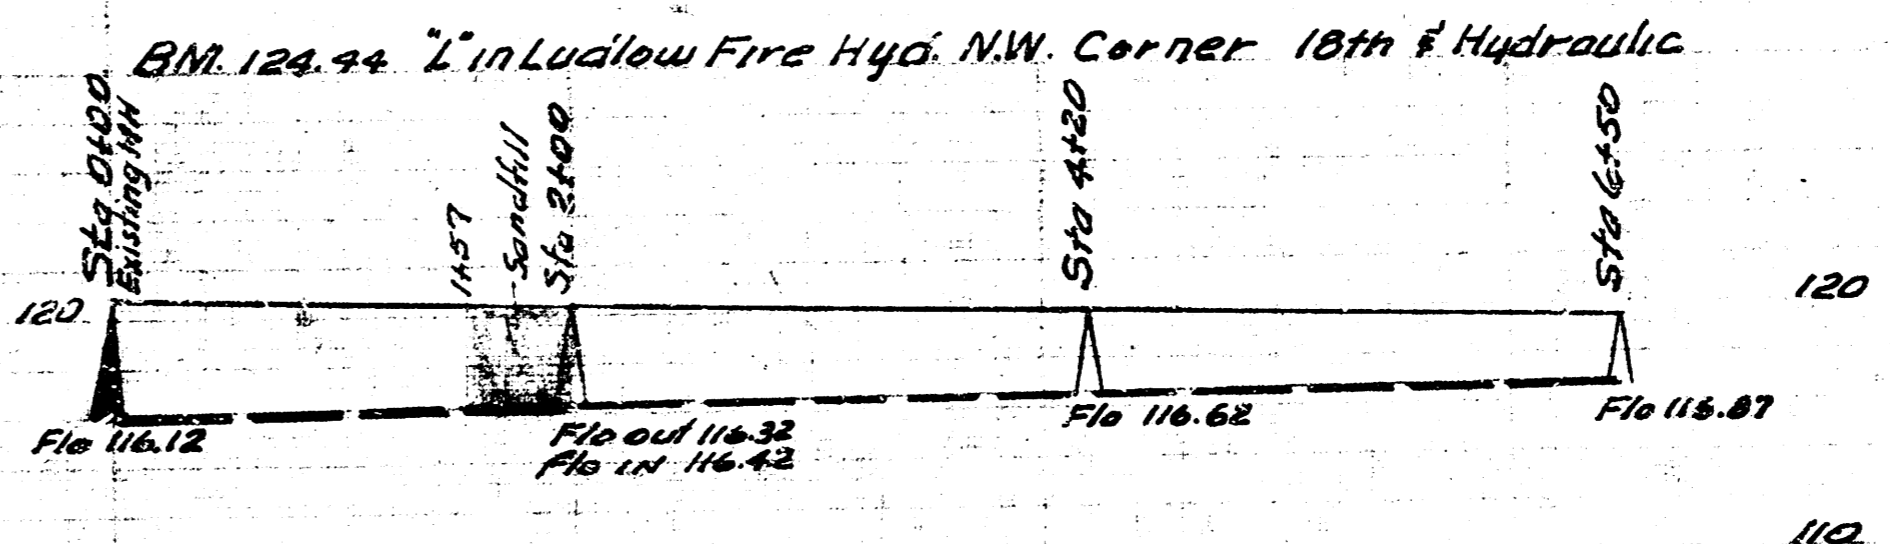

Date  
7-29-52  
Drawn by  
L. McClain  
Checked by  
Book No. 66-1

BM 100.72 Head #60 spike SW side Tel. pole #3000  
NE Corner Chautauqua & Levy

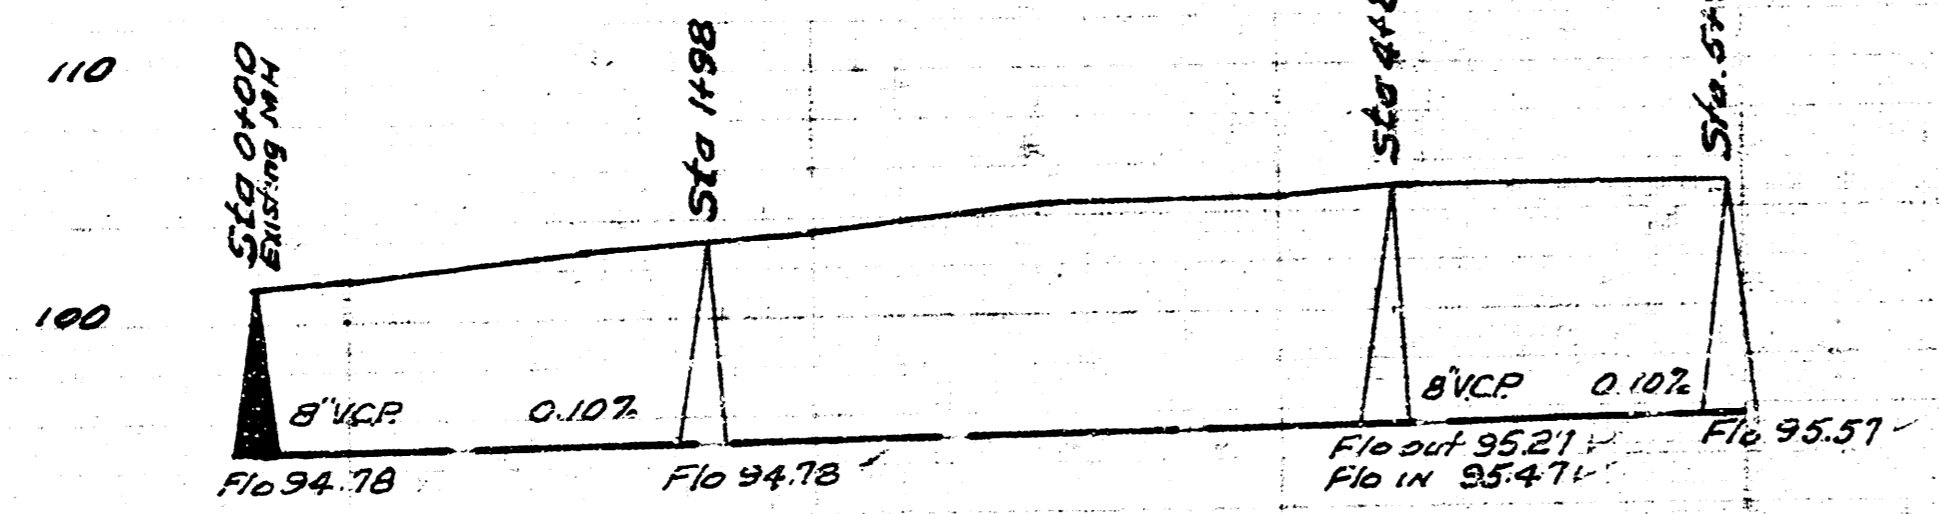

LAT. 21 DCS2 5512  
CITY OF WICHITA KANSAS  
L. WHITE CITY ENGINEER  
Proj No. C-22-44



LAT. 23 DIST. T. 5512  
CITY OF WICHITA KANSAS  
L. WHITE CITY ENGINEER  
Proj No. C-20-32