
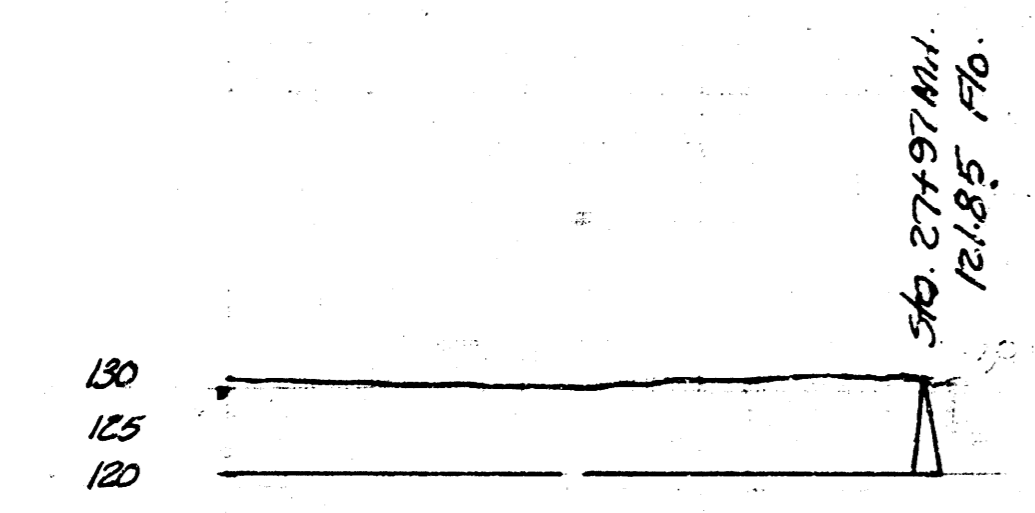
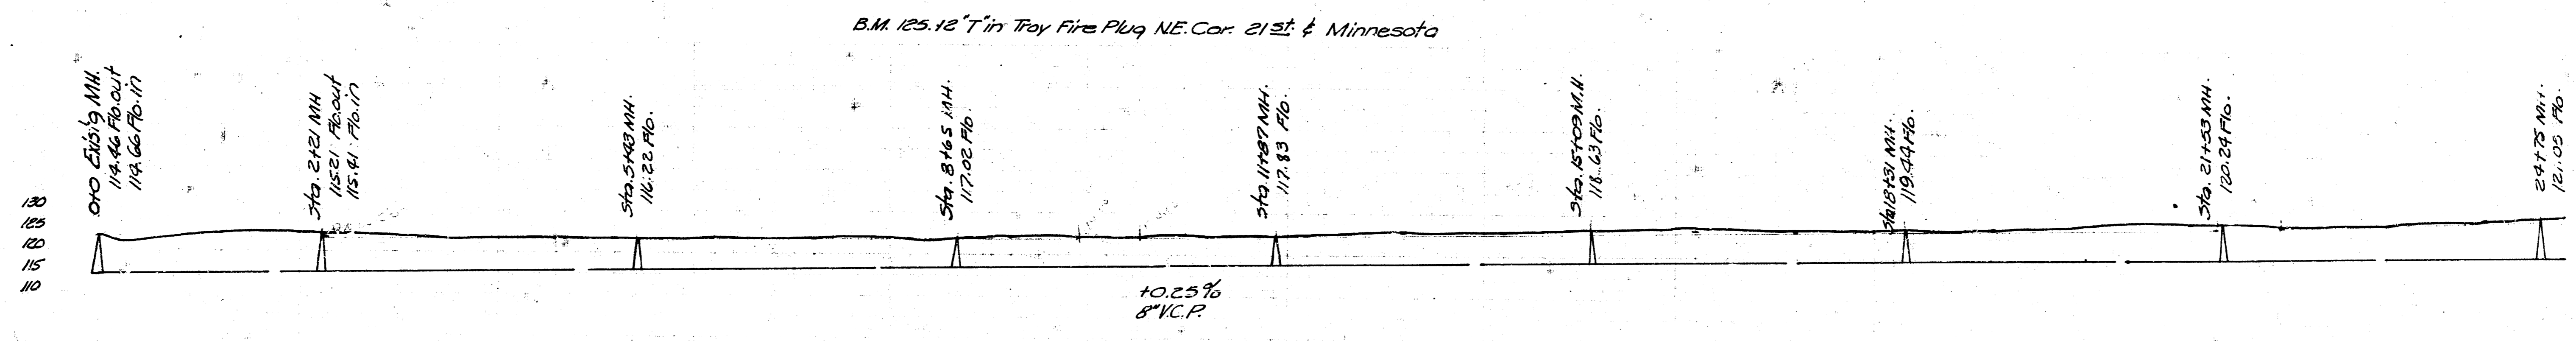


Sta 0123 P.P. 24 on 8
 Sta 0126 Sign Post on 8

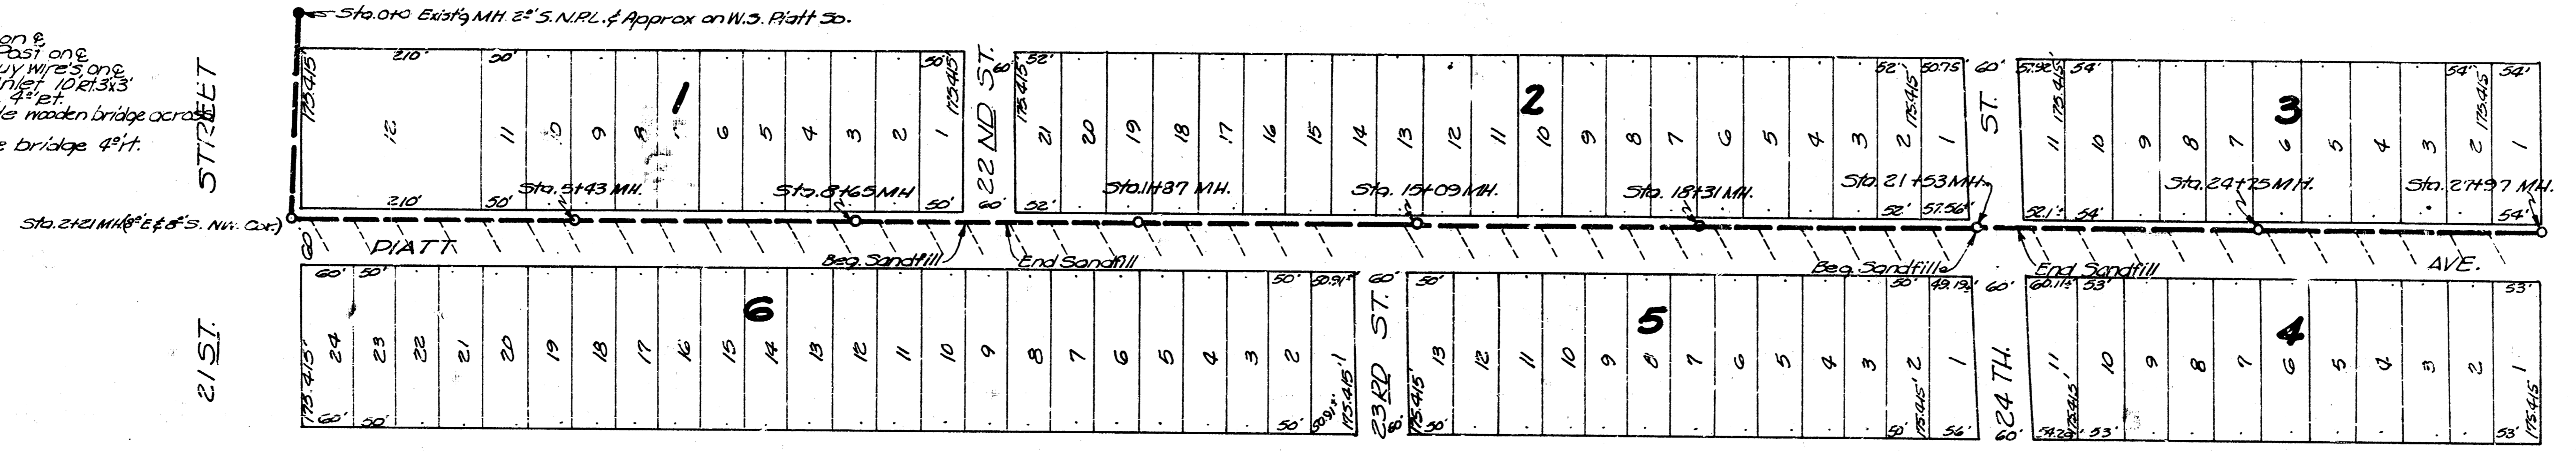

LAT. 26, DIST. T, SS. 12
 CITY OF WICHITA, K.S.
 L.K. WHITE - CITY ENGINEER
 Date 9-23-50 PROJ. NO. C20-60