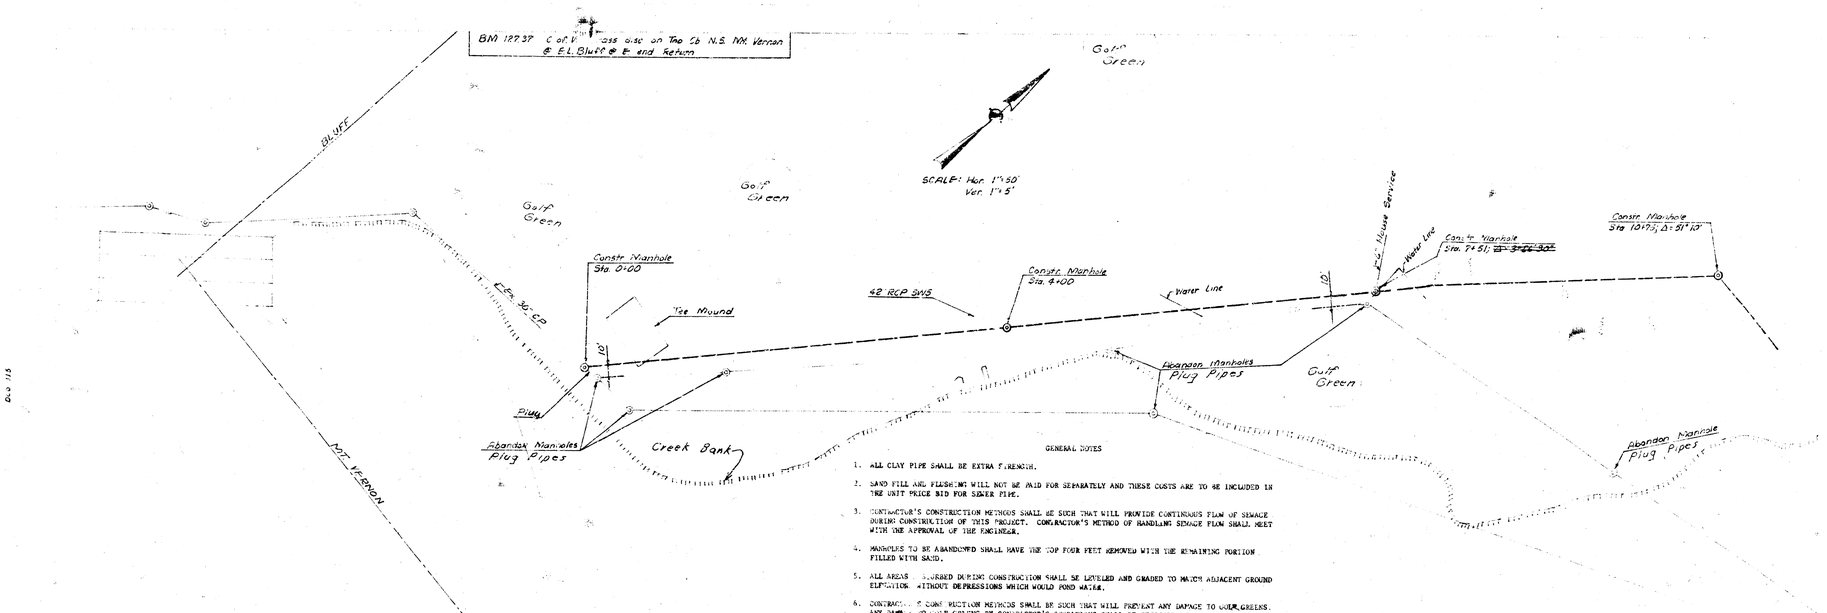

GENERAL NOTES

1. ALL CLAY PIPE SHALL BE EXTRA STRENGTH.
2. SAND FILL AND FLUSHING WILL NOT BE PAID FOR SEPARATELY AND THESE COSTS ARE TO BE INCLUDED IN THE UNIT PRICE BID FOR SEWER PIPE.
3. CONTRACTOR'S CONSTRUCTION METHODS SHALL BE SUCH THAT WILL PROVIDE CONTINUOUS FLOW OF SEWAGE DURING CONSTRUCTION OF THIS PROJECT. CONTRACTOR'S METHOD OF HANDLING SEWAGE FLOW SHALL MEET WITH THE APPROVAL OF THE ENGINEER.
4. MANHOLES TO BE ABANDONED SHALL HAVE THE TOP FOUR FEET REMOVED WITH THE REMAINING PORTION FILLED WITH SAND.
5. ALL AREAS DISTURBED DURING CONSTRUCTION SHALL BE LEVELED AND GRADED TO MATCH ADJACENT GROUND ELEVATIONS. WITHOUT DEPRESSIONS WHICH WOULD POND WATER.
6. CONTRACTOR'S CONSTRUCTION METHODS SHALL BE SUCH THAT WILL PREVENT ANY DAMAGE TO GOLF GREENS, CREEKS. ANY DAMAGE TO GOLF GREENS BY CONTRACTOR'S OPERATIONS SHALL BE REPAIRED BY THE CONTRACTOR TO THE SATISFACTION OF THE PARK DEPARTMENT WITHOUT ANY ADDITIONAL COMPENSATION.

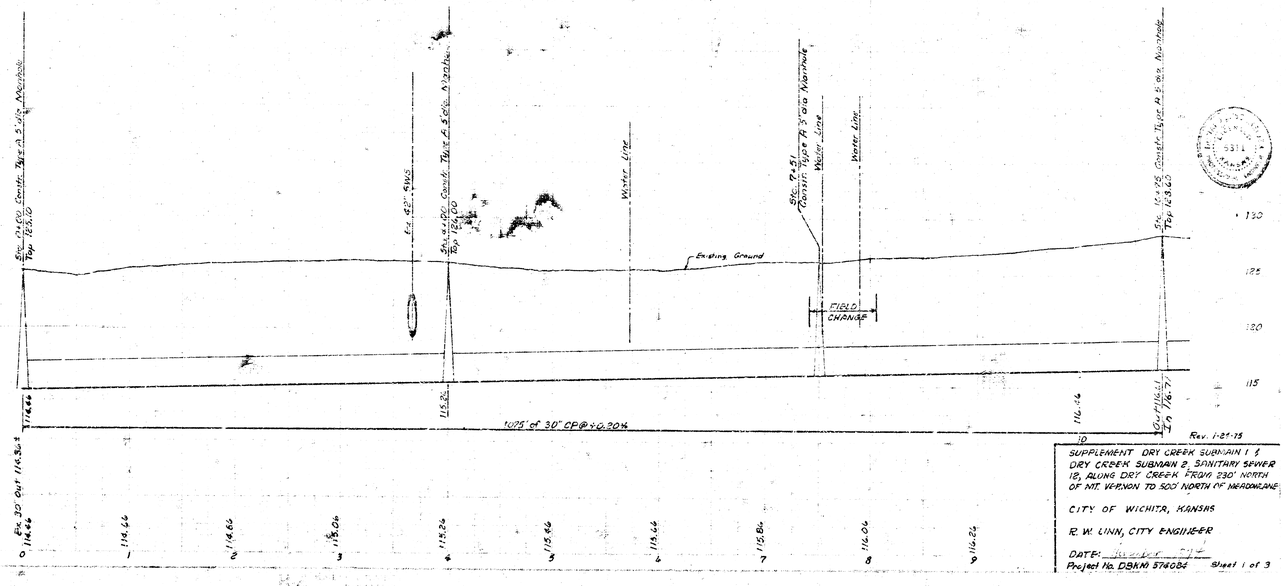

SUPPLEMENT DRY CREEK SUBMAIN 1 & DRY CREEK SUBMAIN 2, SANITARY SEWER 12, ALONG DRY CREEK FROM 230' NORTH OF MT. VERNON TO 500' NORTH OF MEADOWLANE

CITY OF WICHITA, KANSAS

R. W. LINN, CITY ENGINEER

DATE: [illegible]

Project No. DSKN 574084

Sheet 1 of 3

Constr. Manhole
Sta. 10+79.5, Δ=31°10'

Constr. Manhole (Outs.dr. Drop)
Sta. 14+81.05; ~~Δ=18°00'~~

Install 8" Outside Drop

Plug

Abandon Manholes
Plug Pipes

Creek Bank

Golf Green

Constr. Manhole

MANHOLE LAYOUT STA. 19+63.80

Plug Pipes Phase 2

Constr. Manhole
Sta. 24+57.15, Δ=3°03'30"

Sta. 24+65. End Const. Only 10" Pipe.

Golf Green

SCALE: Hor. 1"=50'
Ver. 1"=5'

Creek Bank

Constr. Manhole
Sta. 20+63.80, Δ=24°18'

Golf Green

Sta. 10+79 Taper A S'dia. Manhole
Top 126.40

Sta. 14+81.05 Type A S'dia. Manhole
Rim 125.10

Water Line

Sta. 19+63.80 Type A S'dia. Manhole
Top 130.25

Water Line

Existing Ground

Sta. 20+43.80
30 S'dia. Manhole
Top 137.74

Sta. 24+57.15
Type A Conc. MH Waste
Top 137.20

Sta. 24+65. End Const. Only 10" Pipe.

FIELD CHANGE

Out 116.46
In 116.11

Out 117.04
In 112.53
Ex. 8" 123.76

30" Out 117.79
30" In 118.09
New 21" In 118.63
Ex. 21" In 118.42

Out 118.89
In 118.59

Out 119.77
In 119.47

1390' of 30" CP @ +0.20%

140
135
130
125
120
115

116.76 11
116.96 12
117.16 13
117.36 14
117.46 15
117.86 16
118.16 17
118.36 18
118.56 19
118.76 20
117.06 21
119.26 22
119.46 23
119.66 24
119.97 +65

Rev. 1-24-75

Sheet 2 of 3

SUBDIVISION DRY CREEK SUB. I & E, 55th IR, Project No. USAM 5742B8

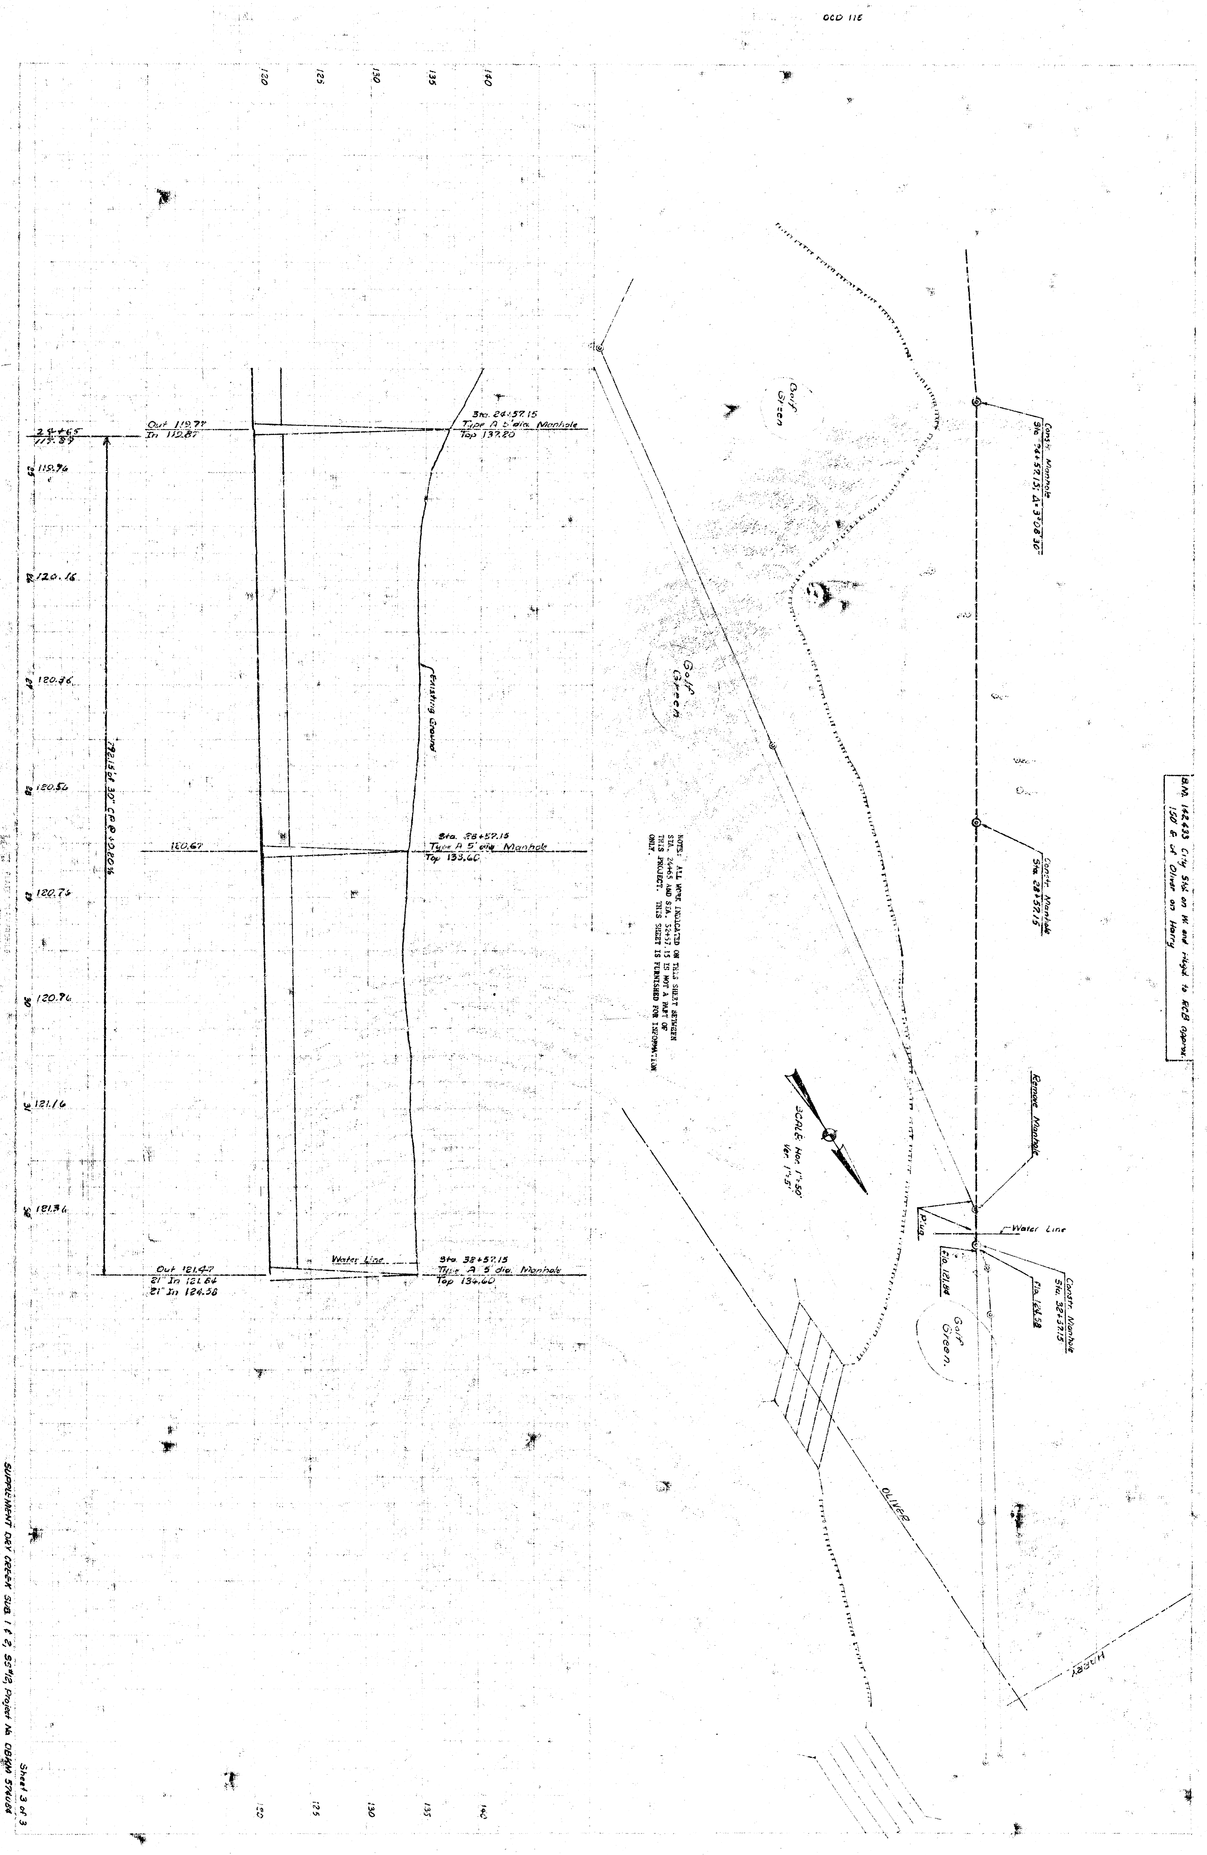

Out 119.77
In 119.87
Sta. 24+57.15
Type A 5' dia. Manhole
Top 137.20
Existing Ground
Sta. 28+57.15
Type A 5' dia. Manhole
Top 135.60
Out 121.47
21" In 121.64
21" In 124.58
Water Line
Sta. 32+57.15
Type A 5' dia. Manhole
Top 134.60
Golf Green
Constr. Manhole
Sta. 24+57.15; Δ=3°08'30"
Constr. Manhole
Sta. 28+57.15
Remove Manhole
Water Line
Constr. Manhole
Sta. 32+57.15
Golf Green
OLIVER
HARRY
B.M. 142.433 City Stk on W. end Hdgd. to RCB approx. 150' ± of Oliver on Harry
NOTE: ALL WORK INDICATED ON THIS SHEET BETWEEN STA. 24+65 AND STA. 32+57.15 IS NOT A PART OF THIS PROJECT. THIS SHEET IS FURNISHED FOR INFORMATION ONLY.
SCALE: Hor. 1"=50' Ver. 1"=5'
SUPPLEMENT DRY CREEK SUB. 1 & 2, 55#12, Project No. DBKM 574U04
Sheet 3 of 3