



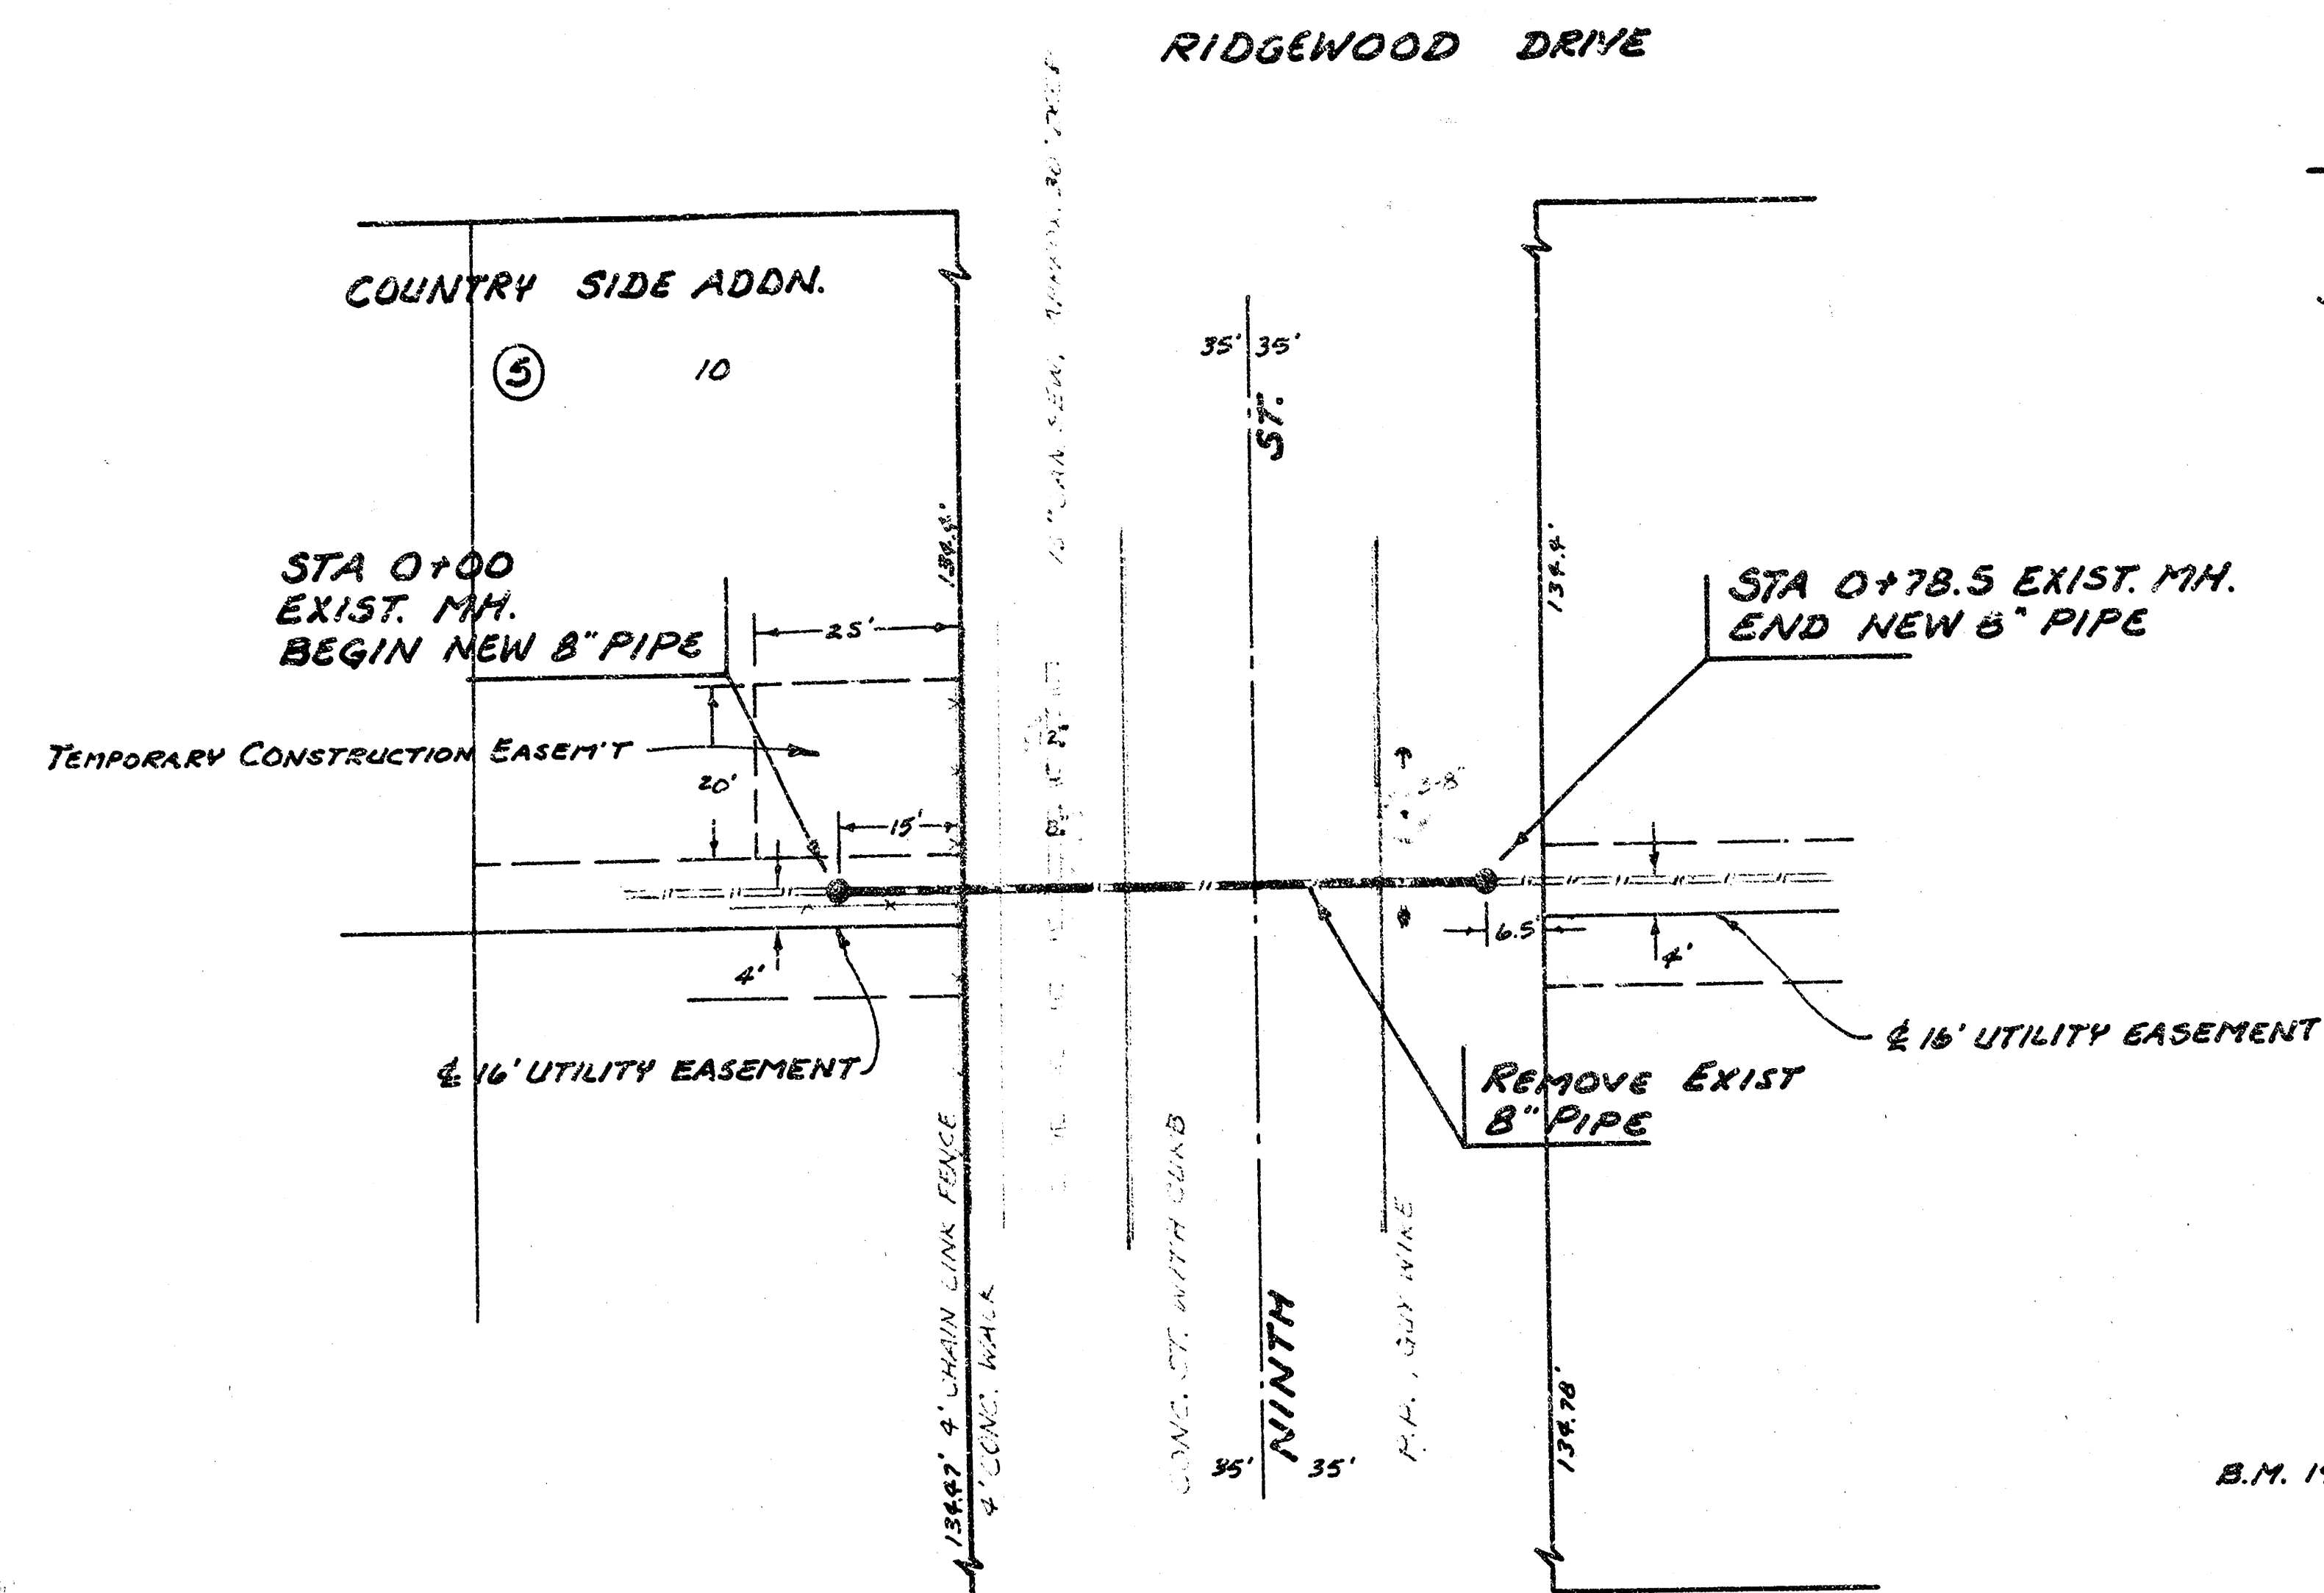

SCALE PLAN 1" = 20'
PROFILE 1" = 20' HORIZ.
1" = 5' VERT.

THE CONTRACTOR SHALL BE RESPONSIBLE FOR PRESERVING PROPERTY IRONS. THE CONTRACTOR SHALL BE REQUIRED TO RE-ESTABLISH ANY PROPERTY IRONS WHICH ARE DAMAGED OR DESTROYED BY HIS CONSTRUCTION OPERATIONS. SUCH IRONS SHALL BE RE-ESTABLISHED BY A LICENSED LAND SURVEYOR OR A LICENSED PROFESSIONAL ENGINEER IN ACCORDANCE WITH STATE LAWS.

As Buil
J.L.L.
9-82

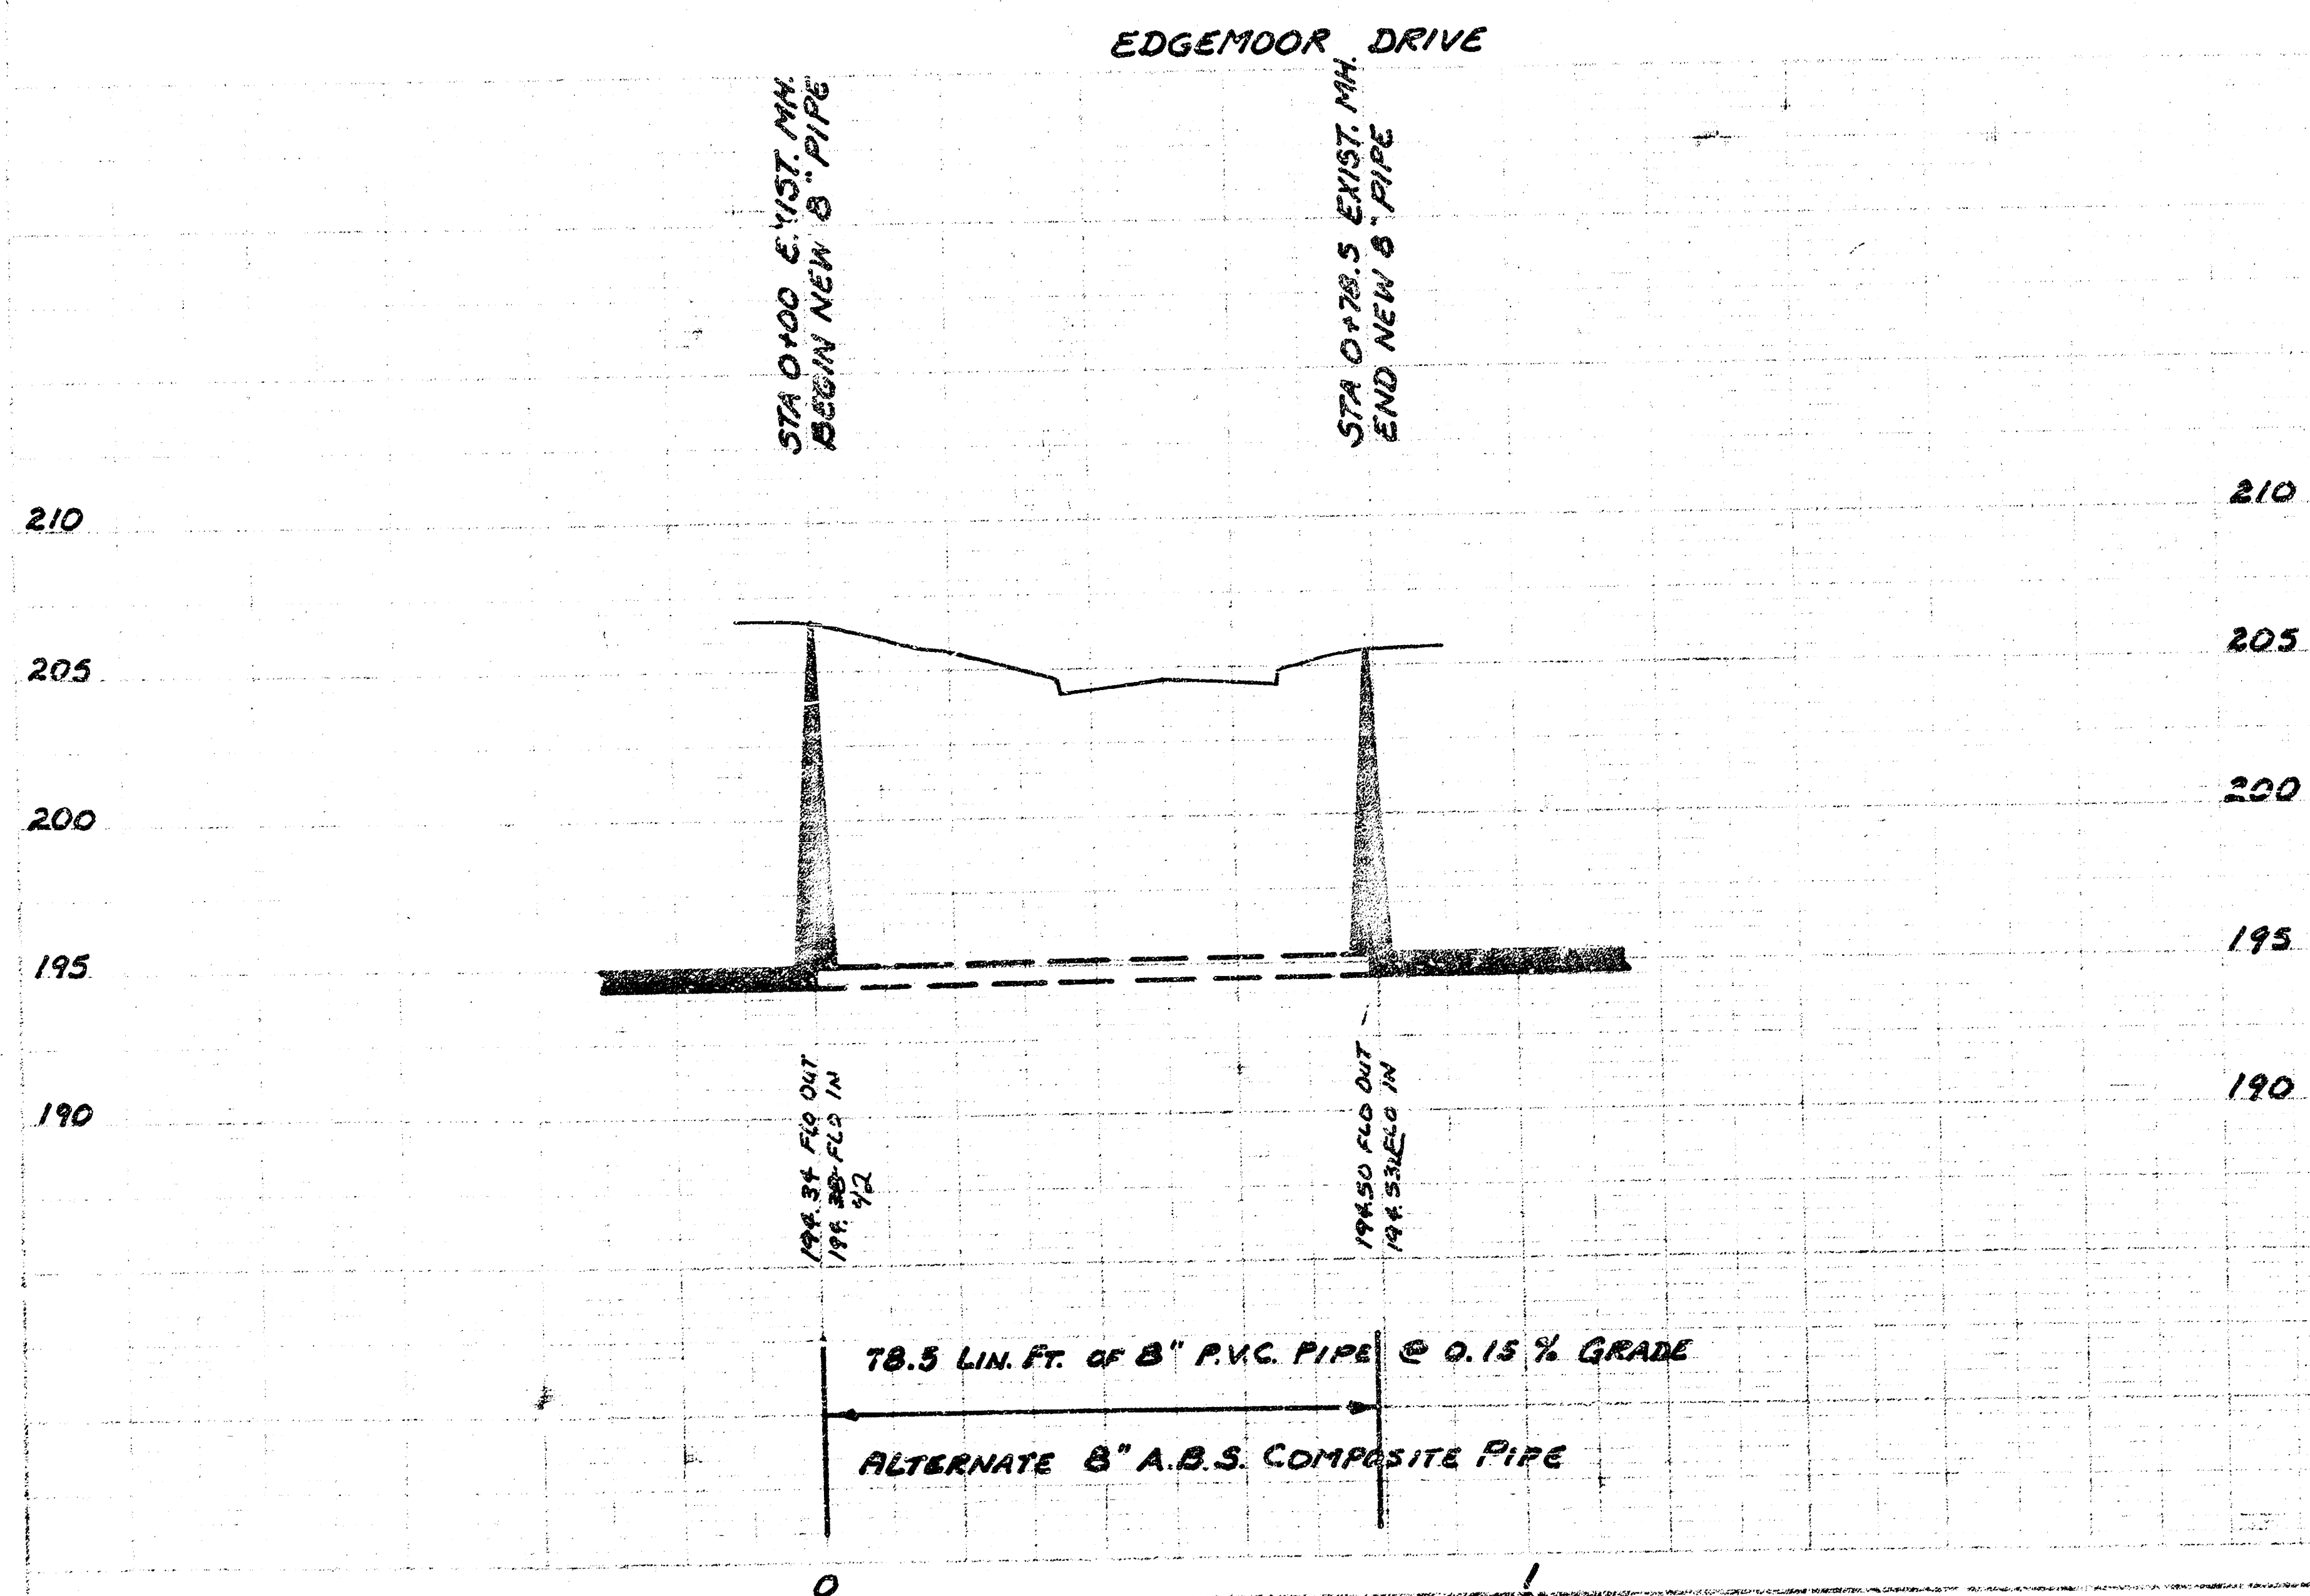

**RECONSTRUCTION OF A PORTION OF LAT 27, DRY CREEK SUBMAIN,
S. S. # 12 IN NINTH ST. BETWEEN NINE WOOD AND EDGEWOOD
CITY OF WICHITA, KANSAS
R. W. SROGGERMAN - DIRECTOR OF ENGINEERING / CITY ENGINEER
PROJ. NO. 488-78-245-81181-000-000-901**

10 5 5 5