
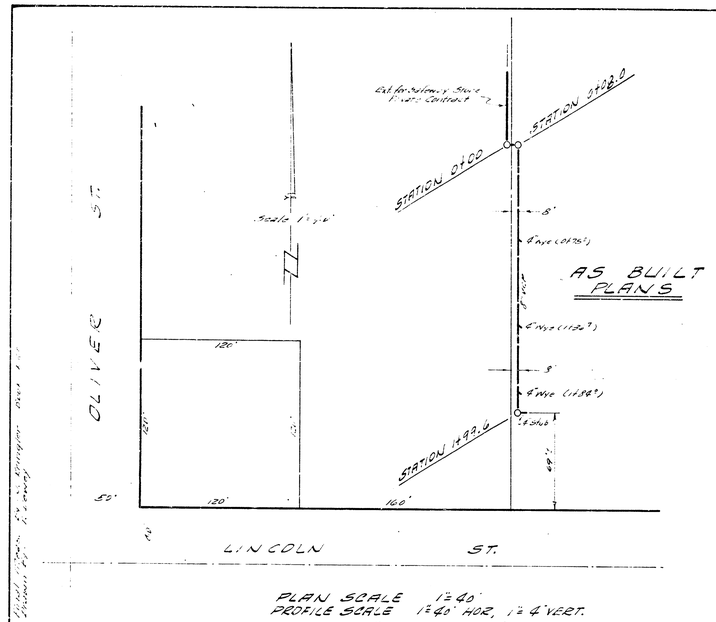


PLAN SCALE 1"=40'
PROFILE SCALE 1"=40' HOR, 1"=4' VERT.

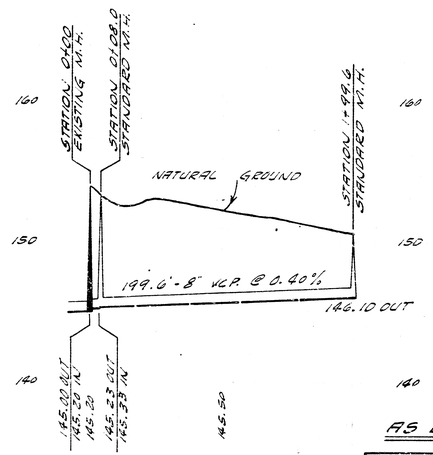


199.6 LIN. FT. 8" VCP @ 0.40%


0 1 2

AS BUILT PLANS

EXT. OF LAT. 33 DCS SS 12
CITY OF WICHITA, KANSAS
B.E. SMITH CITY ENGINEER
PRIVATE JOB. OCT., 1960

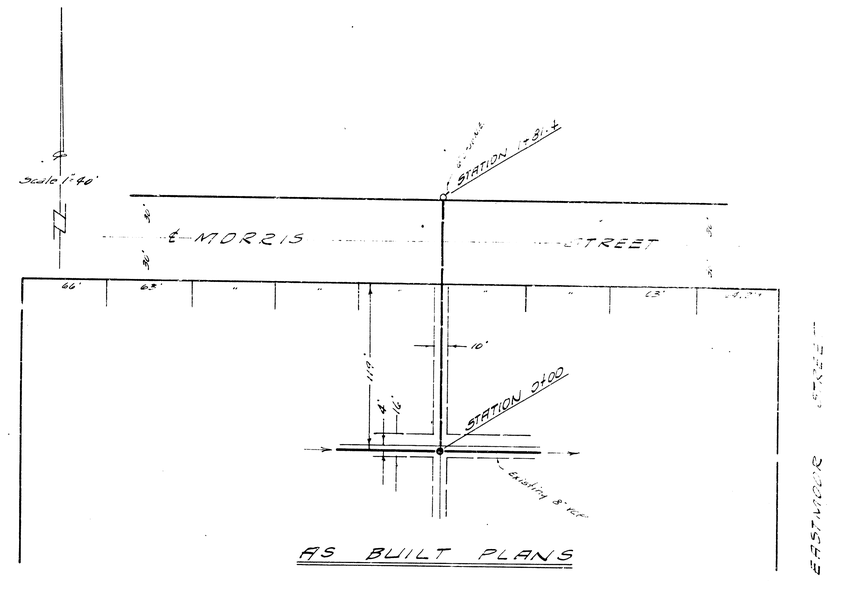

AS BUILT PLANS

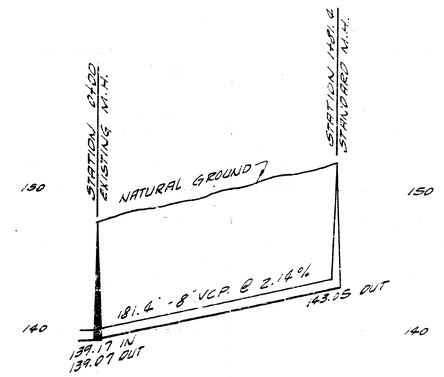

181.4'-8" VCP @ 2.14%

0 1 2

AS BUILT PLANS

EXT. OF LATERAL "23" W.13
CITY OF WICHITA, KANSAS
B.E. SMITH CITY ENGINEER
PRIVATE JOB. OCT. 1960