


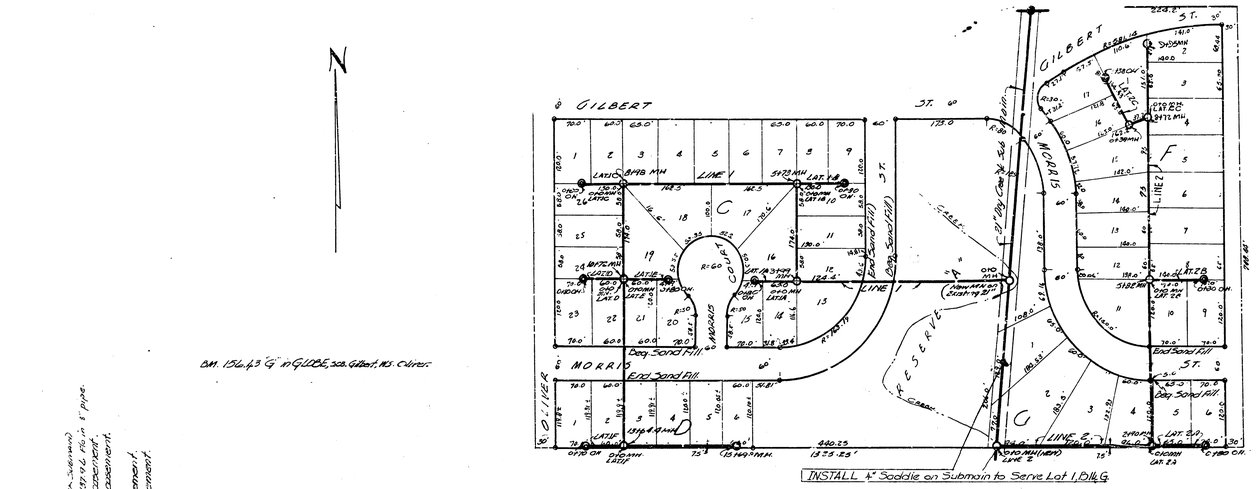


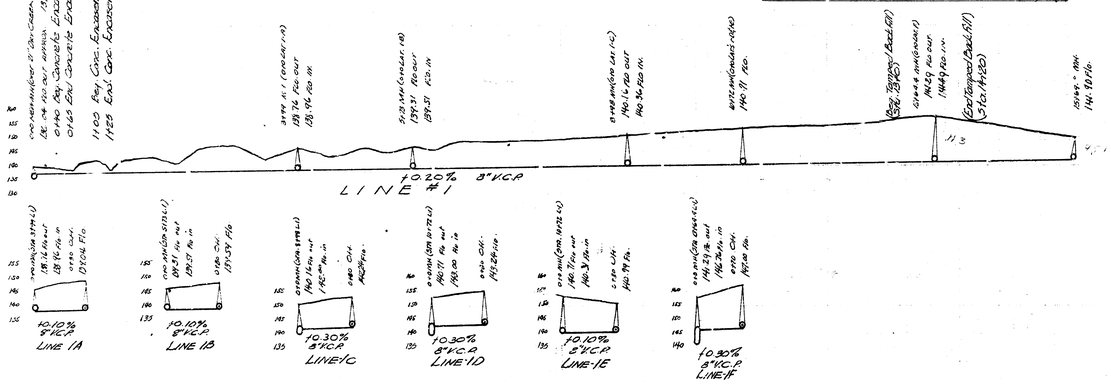

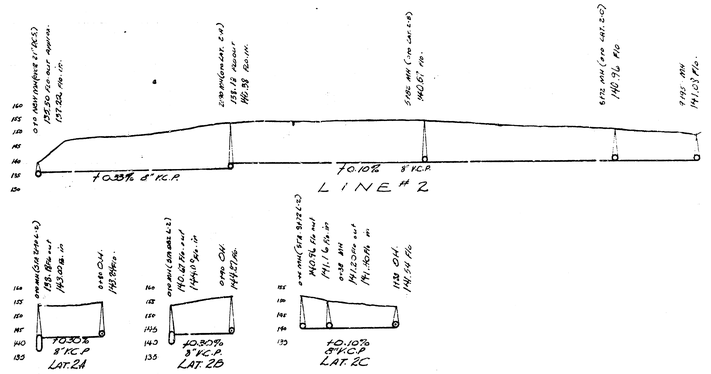

Bottom quadrant of Pipe to be in Contact with Undisturbed trench bottom.

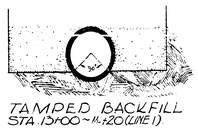

TAMPED BACKFILL
STA. 13+00 - 14+20 (LINE 1)

LAT 33, DRY CREEK SUBMAIN, MAIN 12
CITY OF WICHITA, KANSAS
L.V. WHITE - CITY ENGINEER
DATE 5-17-49 PROJ. NO. C2332