

LOCATION OF ERY CREEK SEWER. Beg. at a point 21.3' E. of the Southwest Cor. of said Sec 16 Sec 22 Twp 28 S. R. 1 E. Thence in a N. E. direction at an angle with the S.L. of said Sec. 16 of 58°28' a distance of 30' thence with an angle to the Rt of 4°(0°09')

CONTRACT LINES FOR PURCELL'S 6TH.
LINE 1 - STA. 010 - STA. 46155
" 2 - STA. 010 - STA. 20110
" 2A - STA. 010 - STA. 0480
" 3 - STA. 010 - STA. 8108
" 4 - STA. 010 - STA. 6450
" 5 - STA. 010 - STA. 9124
" 5-0 - STA. 010 - STA. 4403

CONTRACT LINES FOR PURCELL'S 5TH.
LINE 1 - STA. 46155 - STA. 52487
LINE 2 - STA. 20110 - STA. 29168
LINE 2B - STA. 010 - STA. 0480

DETAIL ROD TAMPED BACK FILL OVER PIPE TRENCH

DETAIL OF SPECIAL MANHOLE

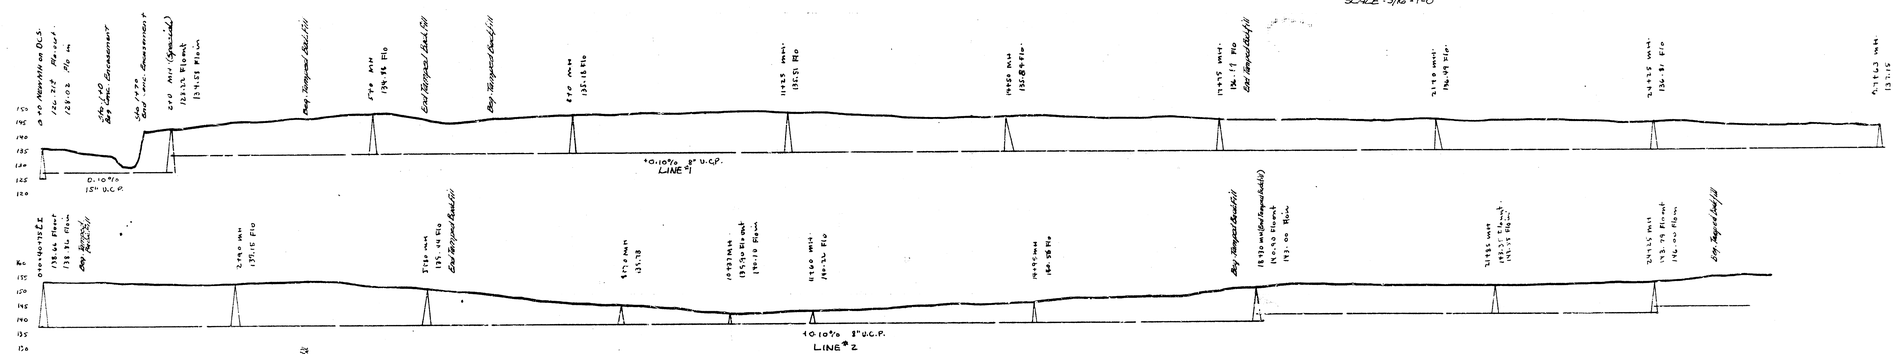

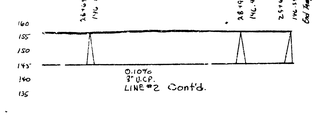

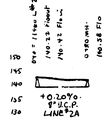

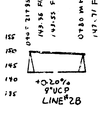

L.9T. 39, D.C.S. 35TH 12
LAT. 36, D.C.S. 35TH 12

CITY OF WICHITA KANS
C.E. WHITE CITY ENGINEER.
DATE 7-3-49 PROJ NOS C29-19
C29-31

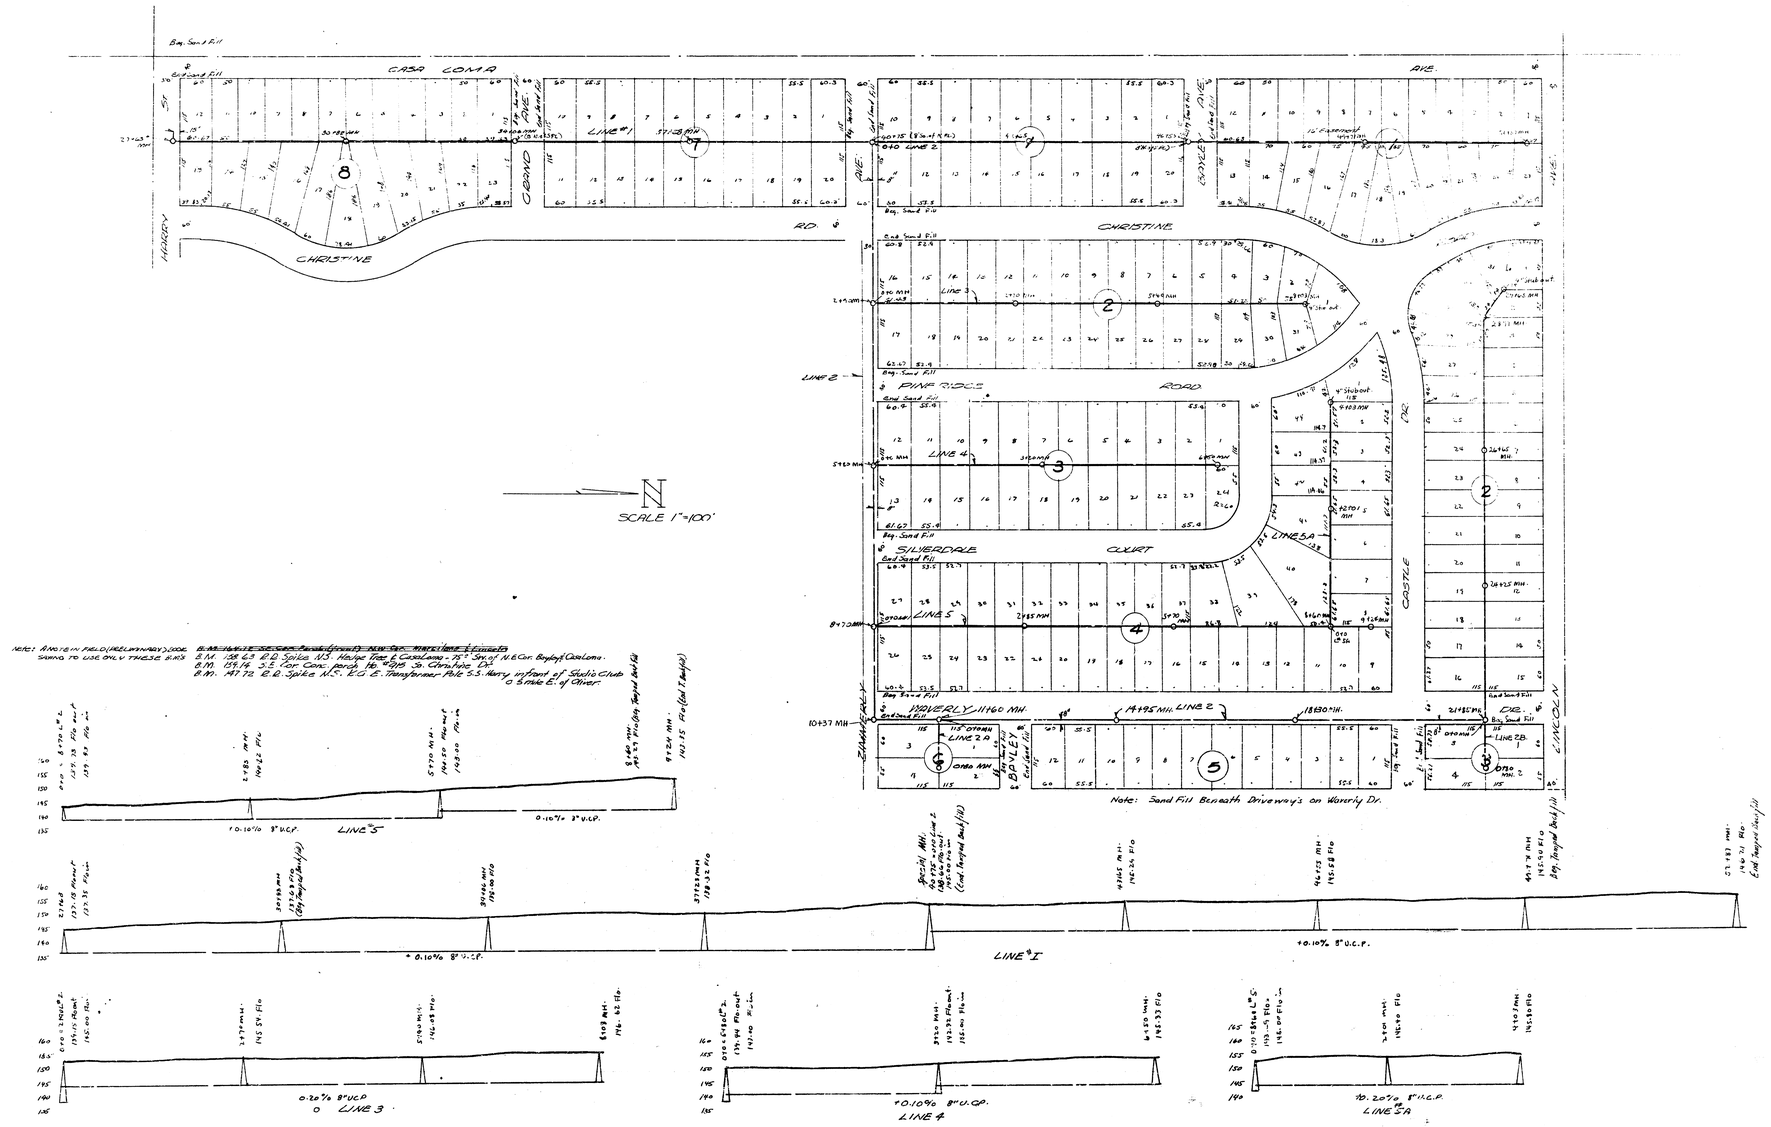
CASA COMA
AVE.
CHRISTINE
RD.
HARRY
GRAND
AVE.
GAYLEY
AVE.
PINE RIDGE
ROAD
SILVERDALE
COURT
CASTLE
DR.
WAVERLY
DR.
ZIMMERLY
BAYLEY
LINCOLN
LINE #1
LINE 2
LINE 3
LINE 4
LINE 5
LINE 5A
LINE 2A
LINE 2B
N
SCALE 1"=100'
Note: Sand Fill Beneath Driveway's on Waverly Dr.
LINE #5
LINE #I
LINE 3
LINE 4
LINE 5A

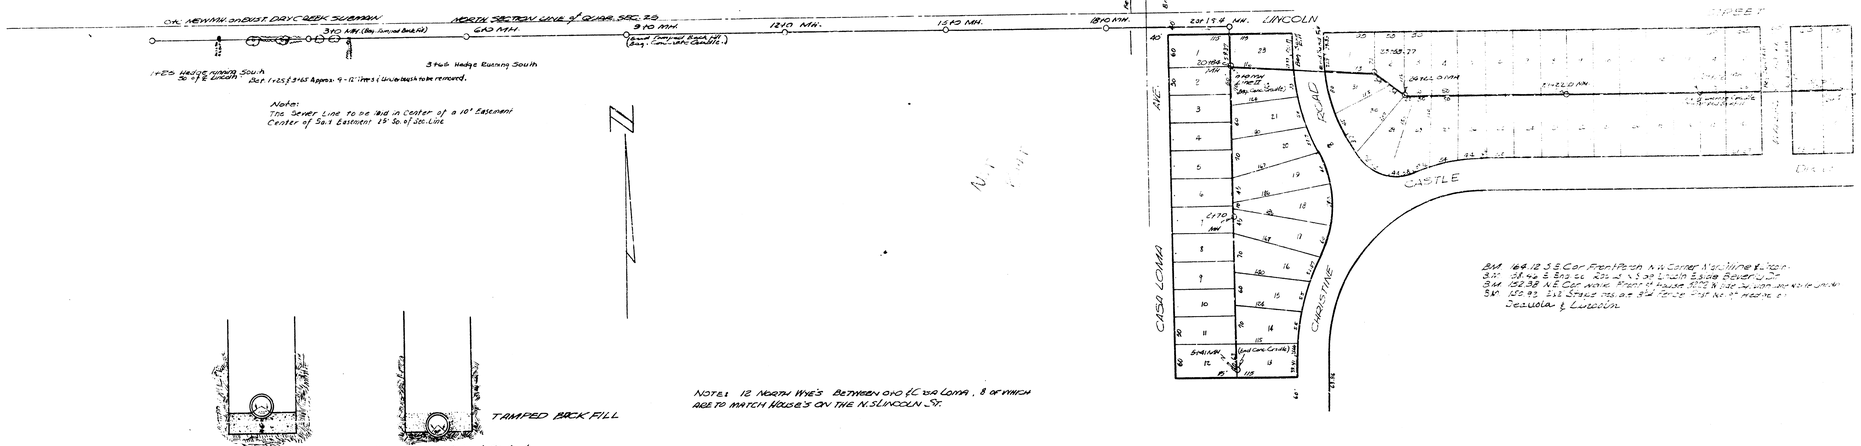

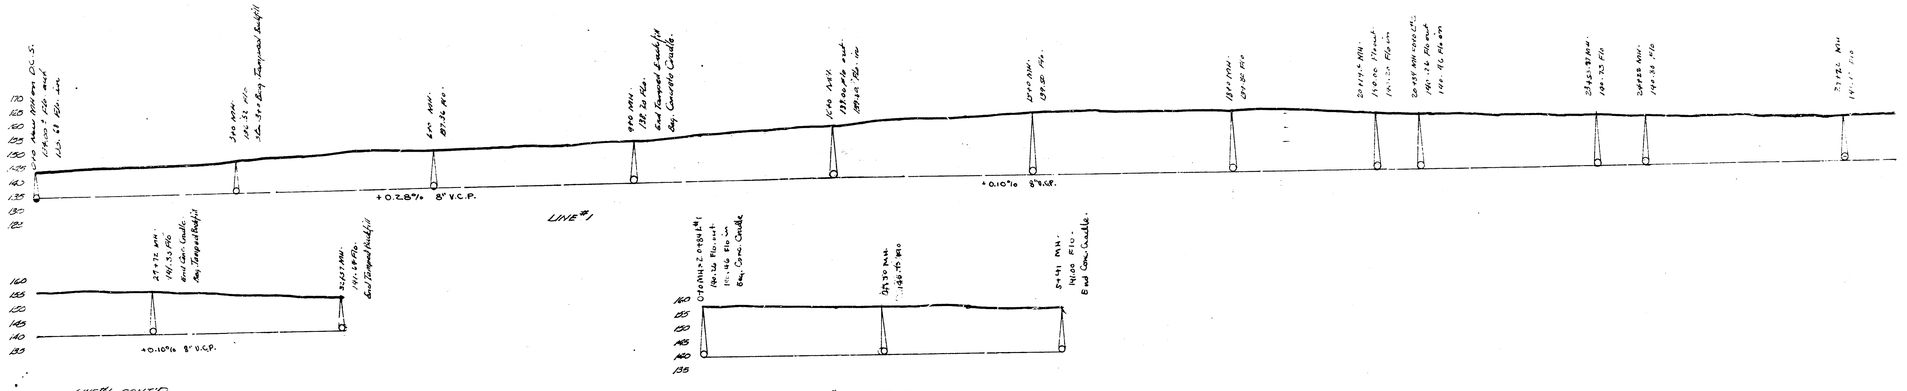

Lat. 36 Dist. 002 S.S.# 12
City of Wichita, Kansas
I. K. White City Engineer
date 7-49 Proj. No C29-19