
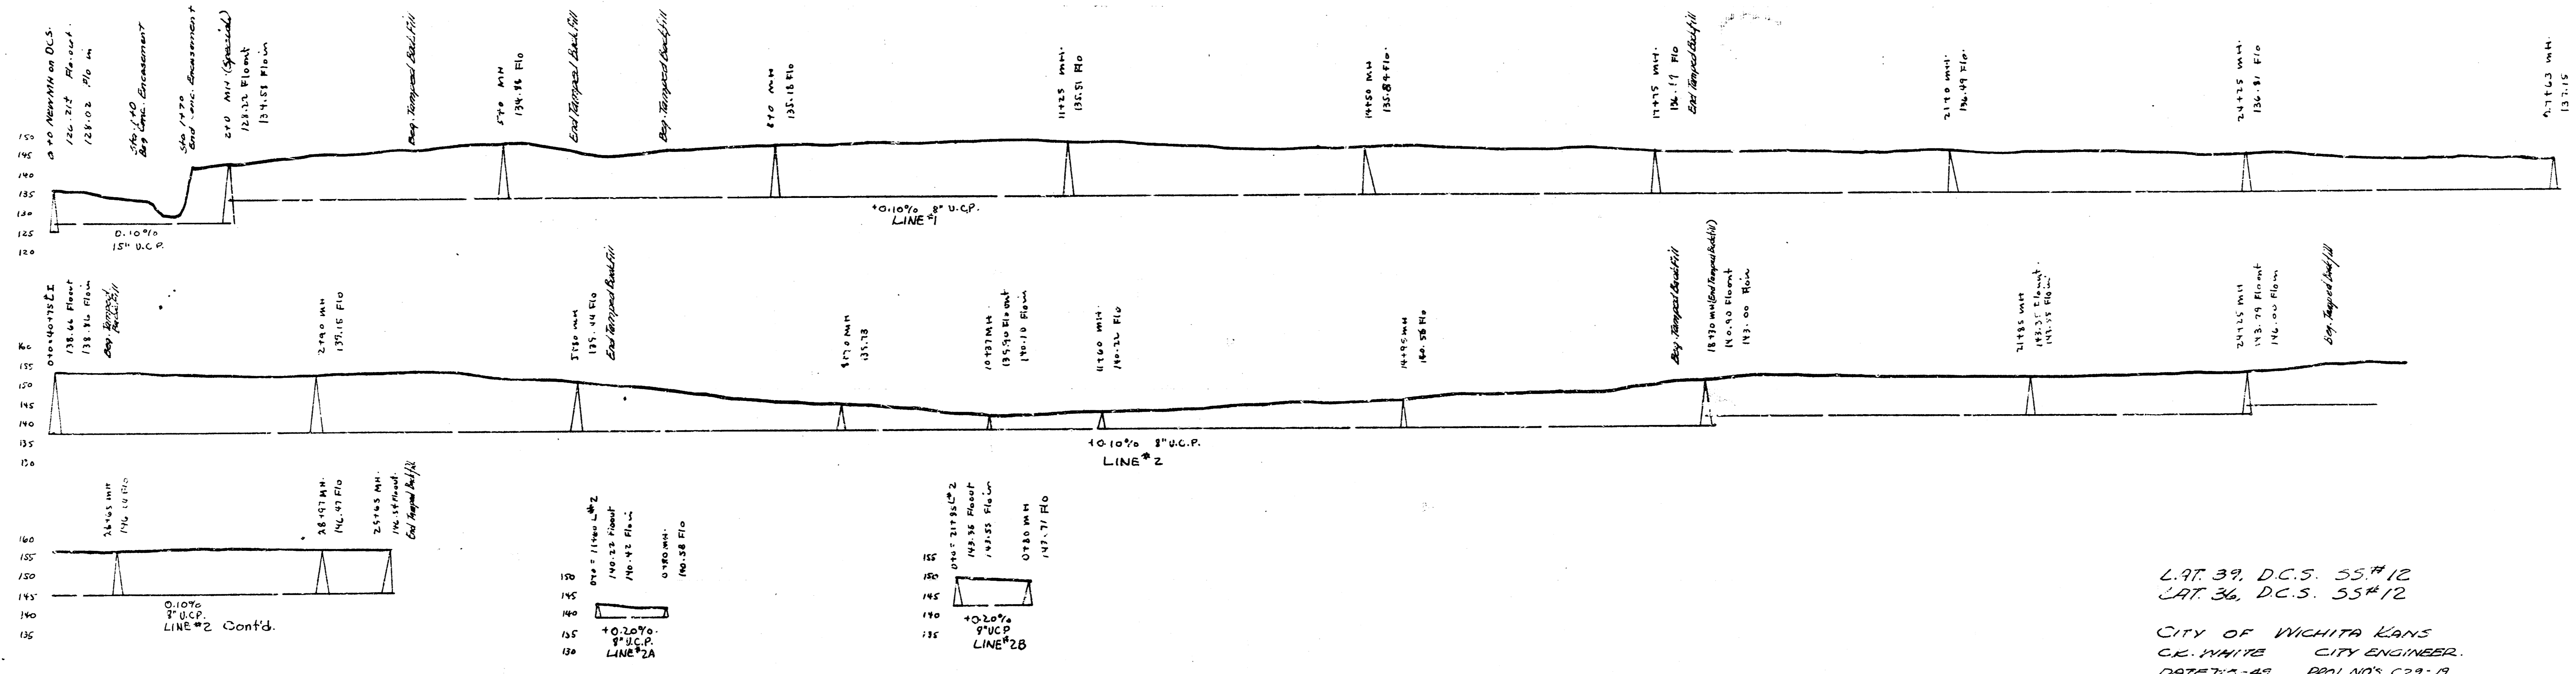
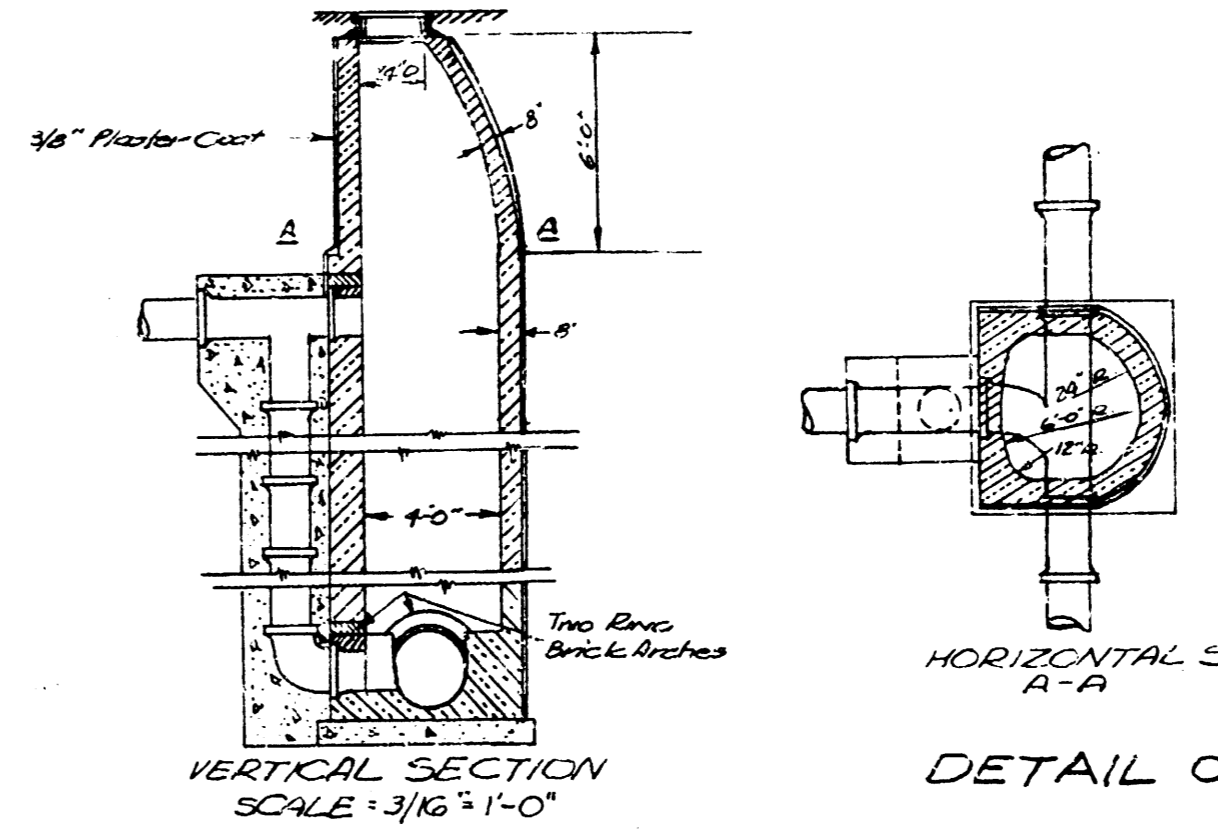







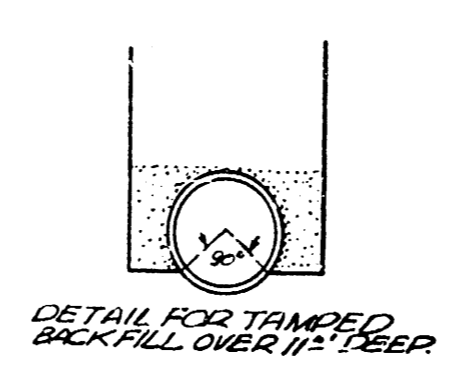

LAT. 39, D.C.S. 55#12  
 LAT. 36, D.C.S. 55#12  
 CITY OF WICHITA KANS  
 C.E. WHITE CITY ENGINEER  

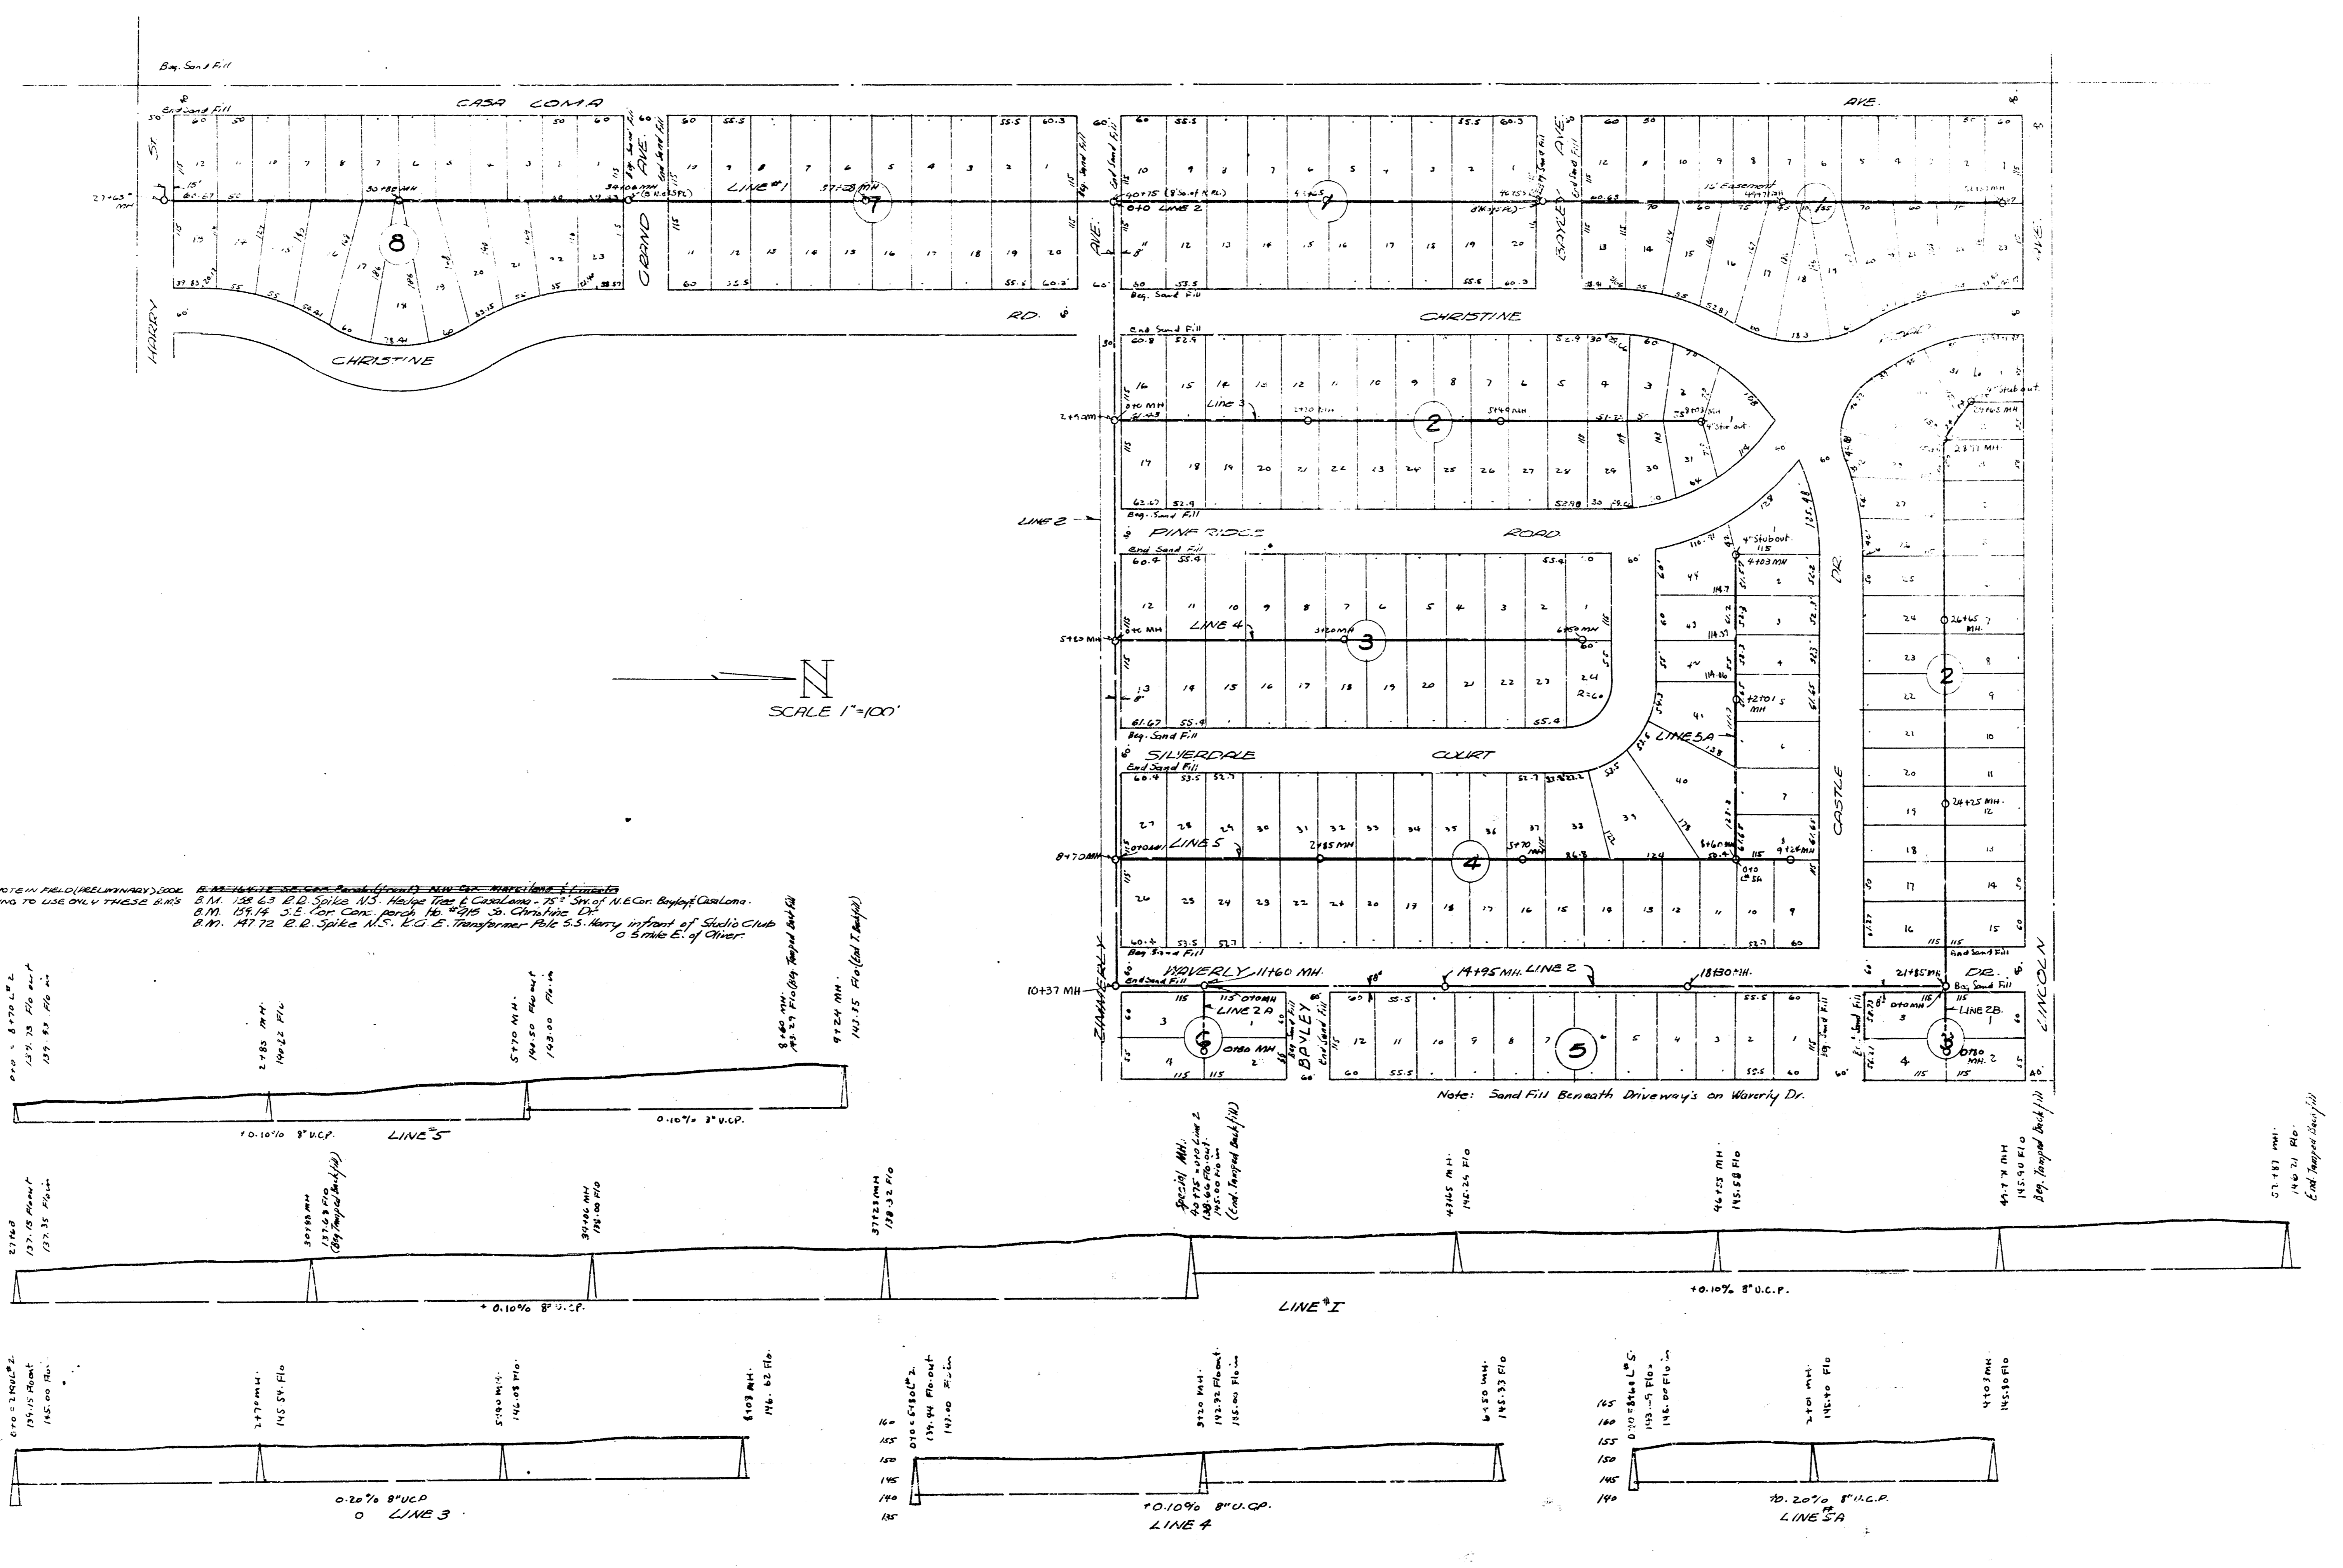

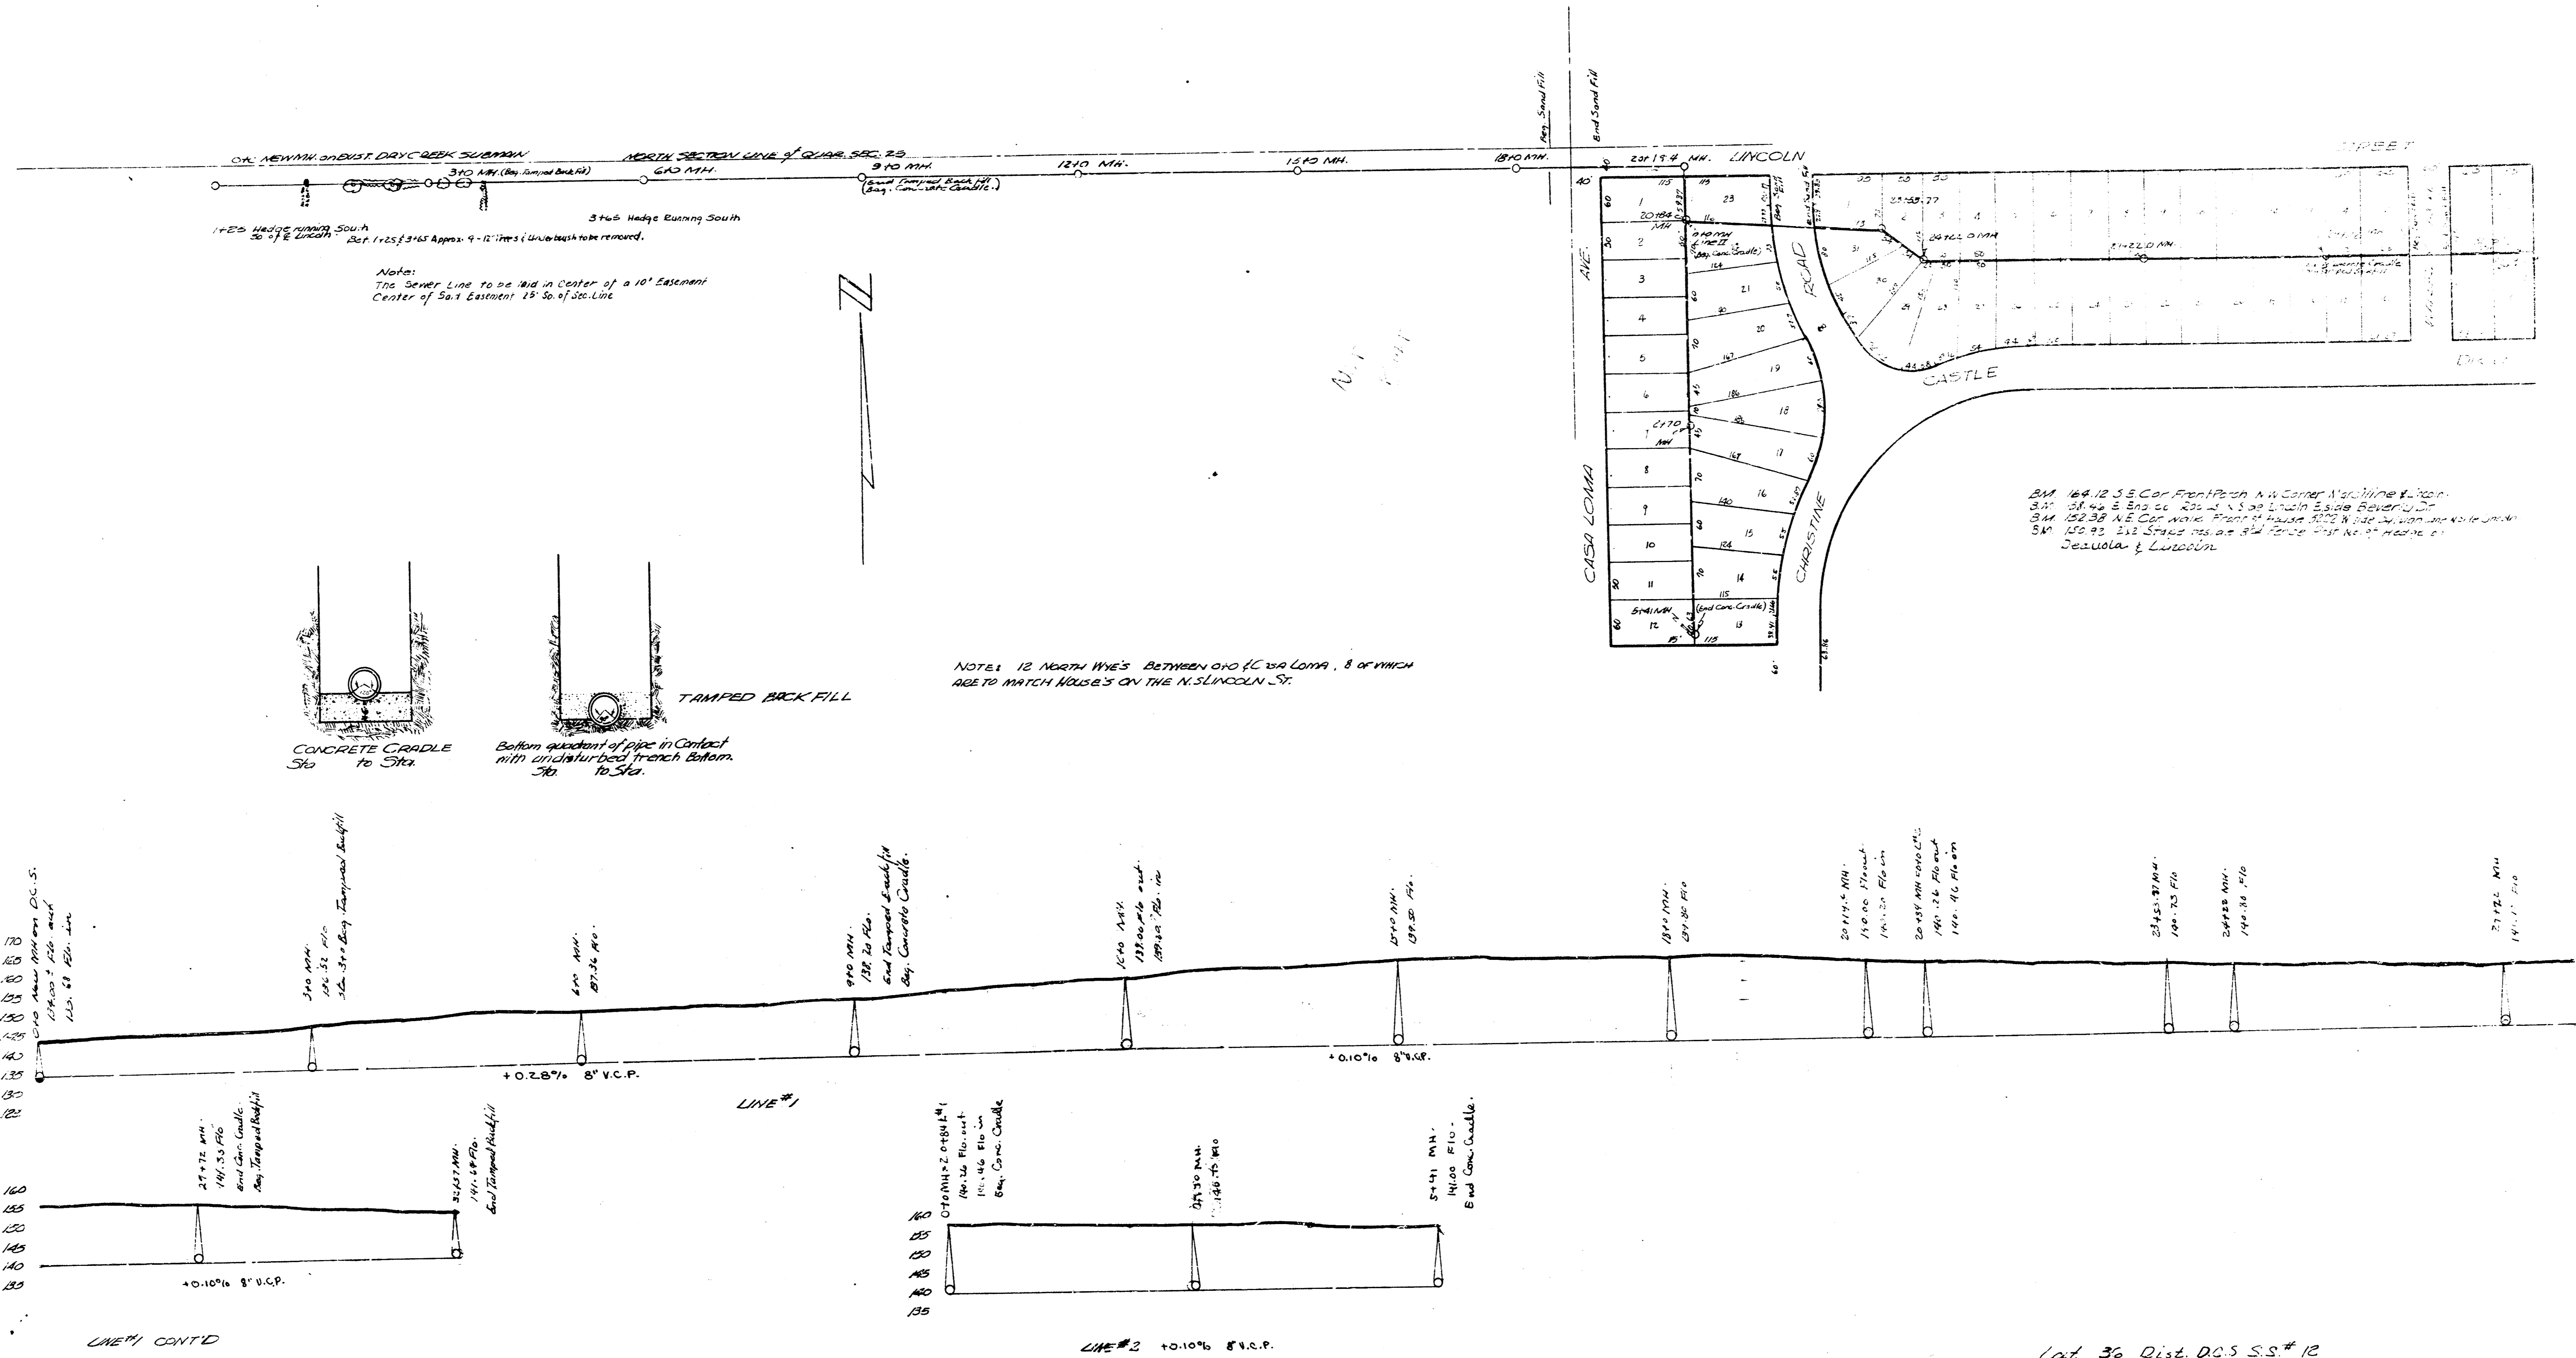

Note:  
The Sewer Line to be laid in Center of a 10' Eastward  

NOTE: 12 NORTH WYE'S BETWEEN 010 (CASA LOMA) & 010 WHICH  
ARE TO MATCH HOUSE'S ON THE N. LINCOLN ST.


LINE #1 CONT'D

LINE #2 +0.10% 8" V.C.P.

Lot. 36 Dist. DC5 S.S.# 12  
City of Wichita, Kansas  
I. K. White City Engineer  
date 7-99 Proj. No. C29-19