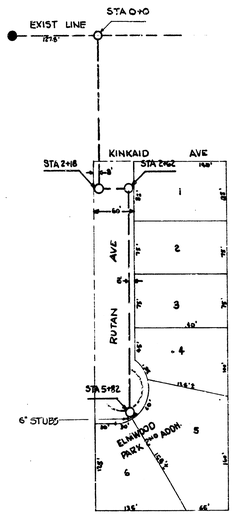


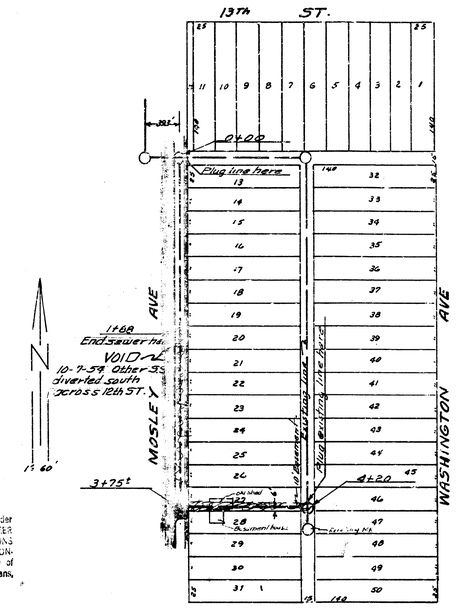


NOTE TO CONTRACTOR

This project will be constructed under the supervision of the CITY ENGINEER and conformed to the SPECIFICATIONS of the CITY OF WICHITA. The CONTRACTOR will reimburse the City of Wichita for all cost of Engineering, Plans, and Inspection.

B.M. 116.16 E. Rim MH. 39.3 West of 0+00

B.M. 1027 LARGE STAPLE N. FACE P.P. S.W. COR. RUTAN & KINKAID

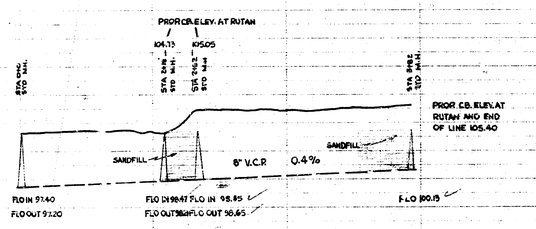


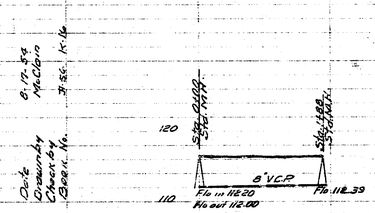


DATE 15-6-58
DRAWN BY
CHK. BY
BK. NO. K-18

LAT 38 D.C.S. #2 S.S. 12.
CITY OF WICHITA, KANS.
B.E. SMITH CITY ENGINEER
PROJ. NO. C 24-42

PRIVATE SEWER
ROCK ISLAND LUMBER CO.
CITY OF WICHITA KANSAS
B.E. SMITH CITY ENGINEER