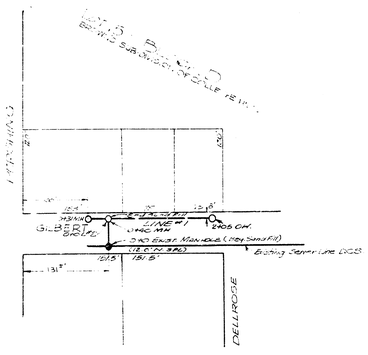

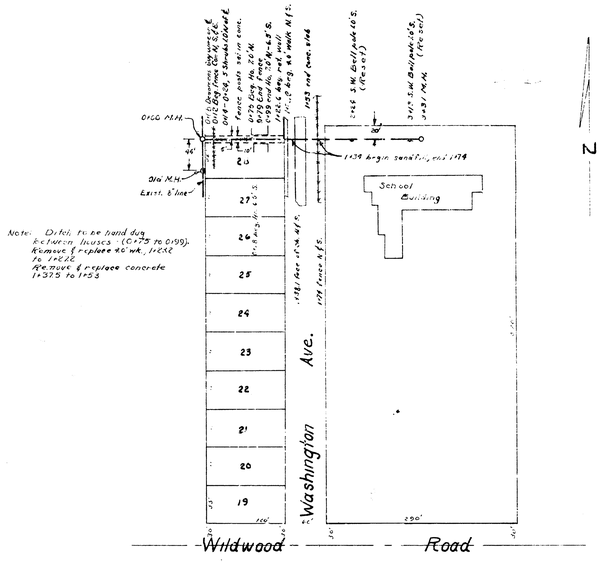

LAT. 42, DRY CREEK SUBMAIN, SS#12

BM. 1641 S.E. Corner Cor. Brick, three SW Cor Gilbert & Dellrose
BM. 1656 "G" in Globe Pershing & Gilbert End (East) of Bases NE. Cor.

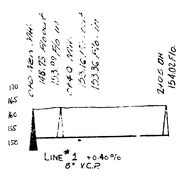

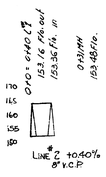

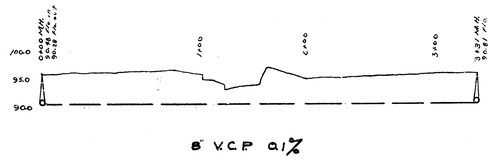

LAT. 42, DRY CREEK SUBMAIN, SS#12
SOUTH WASHINGTON ELEMENTARY SCHOOL

CITY OF WICHITA, KANSAS

L. K. WHITE ~ CITY ENGINEER

OCT. 6, 1949 ~ PRIVATE JOB