
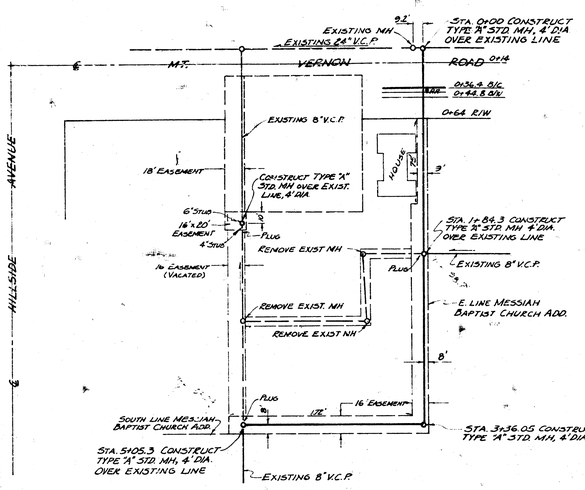



1"=50'

NOTES:

1. ALL MANHOLES TO BE REMOVED SHALL BE DEMOLISHED AND ALL LINES PLUGGED WITH CONCRETE. SALVAGE FRAME AND COVER AND DELIVER TO CITY OF WICHITA MATERIAL YARD.
2. ALL LINES TO BE SAND BACKFILLED AND FLUSHED.
3. ABANDONED LINES UNDER NEW CHURCH BUILDING SHALL BE SAND FILLED.
4. ALL PAVEMENT REMOVED SHALL BE REPLACED ACCORDING TO CITY OF WICHITA SPECIFICATIONS (SEE DETAIL).

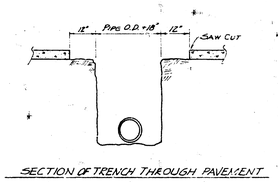

SECTION OF TRENCH THROUGH PAVEMENT

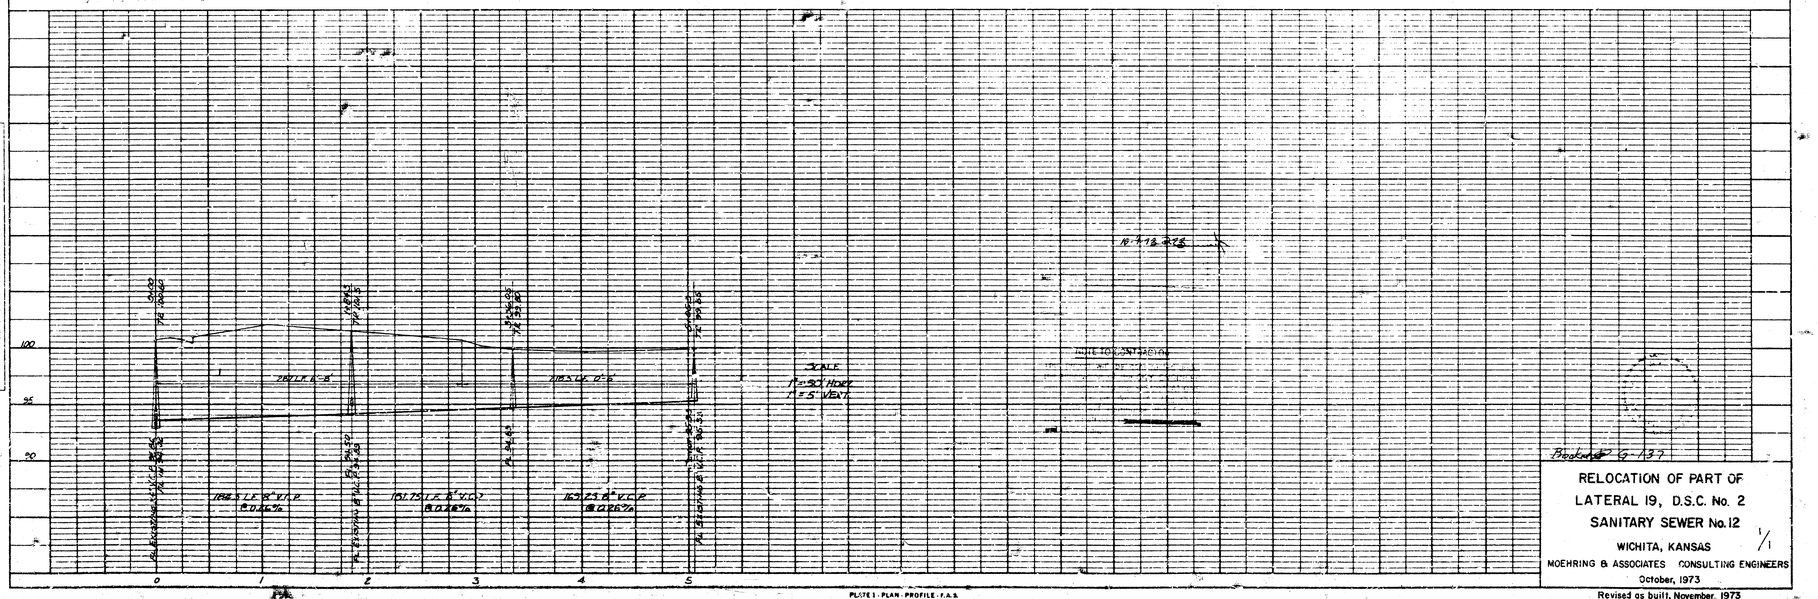

Book No. G-137

RELOCATION OF PART OF
LATERAL 19, D.S.C. No. 2
SANITARY SEWER No. 12
WICHITA, KANSAS
1/1
MOEHRING & ASSOCIATES CONSULTING ENGINEERS
October, 1973
Revised as built, November, 1973

PLATE I - PLAN - PROFILE - F.A.S.
CLEARPRINT PAPER CO., S. F. CAL.

FILMED FROM THE BEST