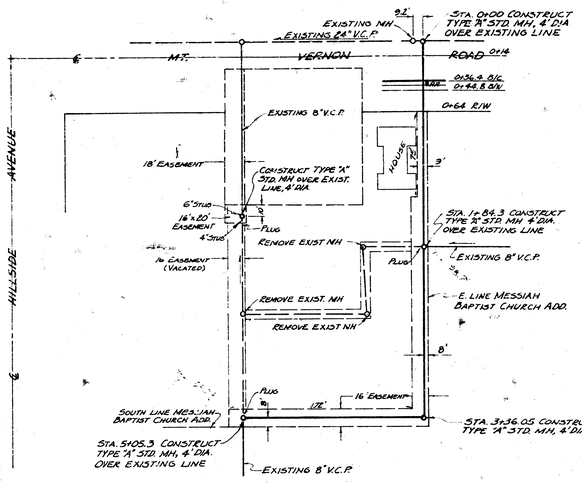

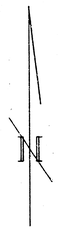

NOTES:

1. ALL MANHOLES TO BE REMOVED SHALL BE DEMOLISHED AND ALL LINES PLUGGED WITH CONCRETE. SALVAGE FRAME AND COVER AND DELIVER TO CITY OF WICHITA MATERIAL YARD.
2. ALL LINES TO BE SAND BACKFILLED AND FLUSHED.
3. ABANDONED LINES UNDER NEW CHURCH BUILDING SHALL BE SAND FILLED.
4. ALL PAVEMENT REMOVED SHALL BE REPLACED ACCORDING TO CITY OF WICHITA SPECIFICATIONS (SEE DETAIL).

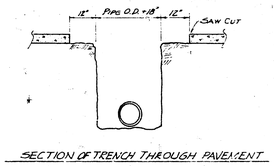

SECTION OF TRENCH THROUGH PAVEMENT

PLAN
HORIZ. SCALE 1" = 50'
VERT. SCALE
DATE
NOTE BOOK
CONSULTING ENGINEERS
MOEHRING & ASSOCIATES
WICHITA, KANSAS
NO.

PROFILE
HORIZ. SCALE 1" = 50'
VERT. SCALE 1" = 5'
DATE
NOTE BOOK
CONSULTING ENGINEERS
MOEHRING & ASSOCIATES
WICHITA, KANSAS
NO.

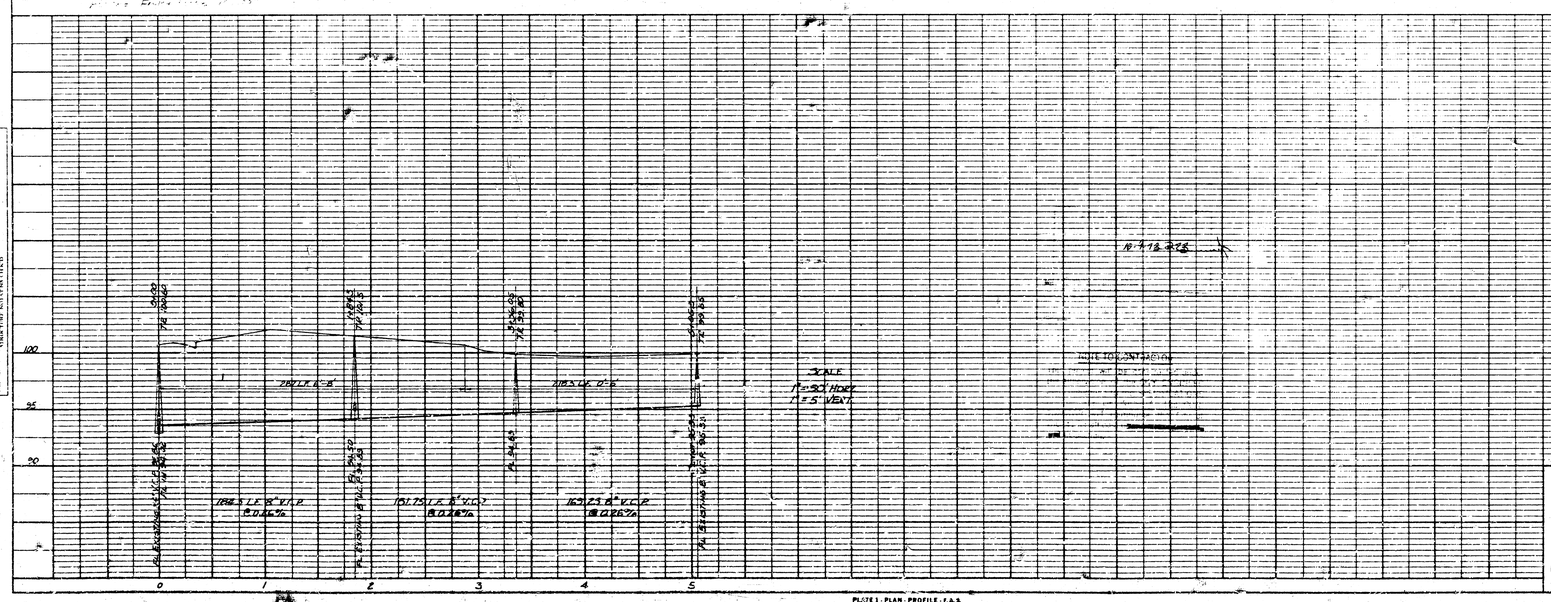

RELOCATION OF PART OF
LATERAL 19, D.S.C. No. 2
SANITARY SEWER No. 12
WICHITA, KANSAS
1/1
MOEHRING & ASSOCIATES CONSULTING ENGINEERS
October, 1973

Revised as built, November, 1973
(SHEET 2 SEE ABOVE)
SHEET 1 of 2

PLATE 1 - PLAN - PROFILE - F.A.S.
"CLEARPRINT PAPER CO., S.F. CAL."
NO. 1000R

FILMED FROM THE BEST