

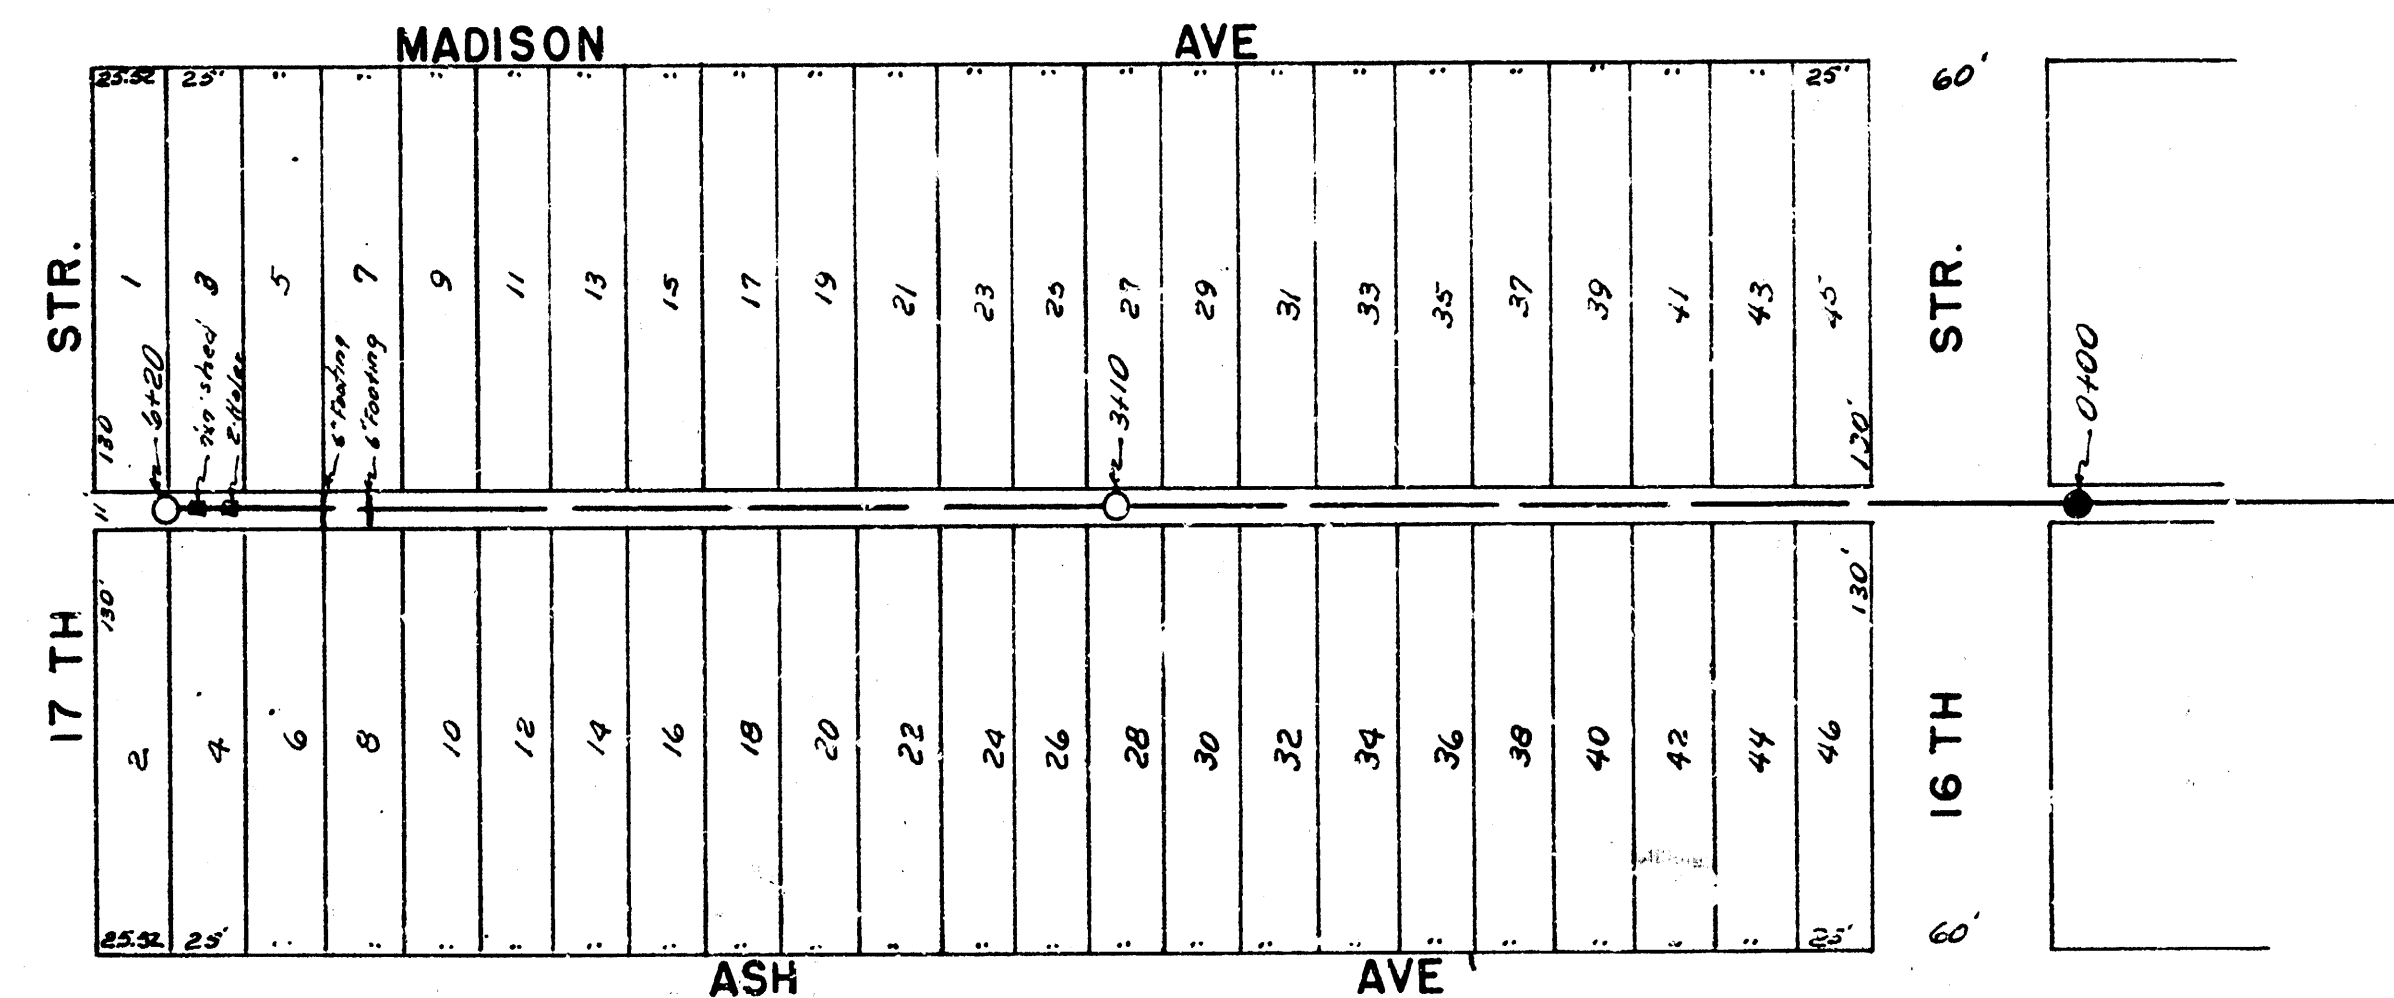
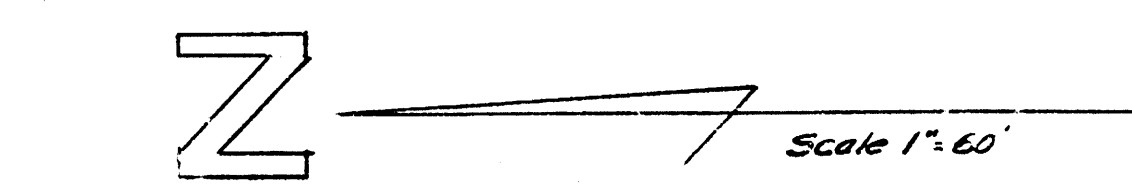
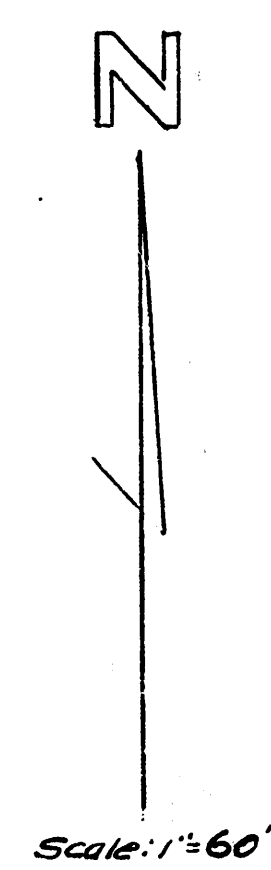
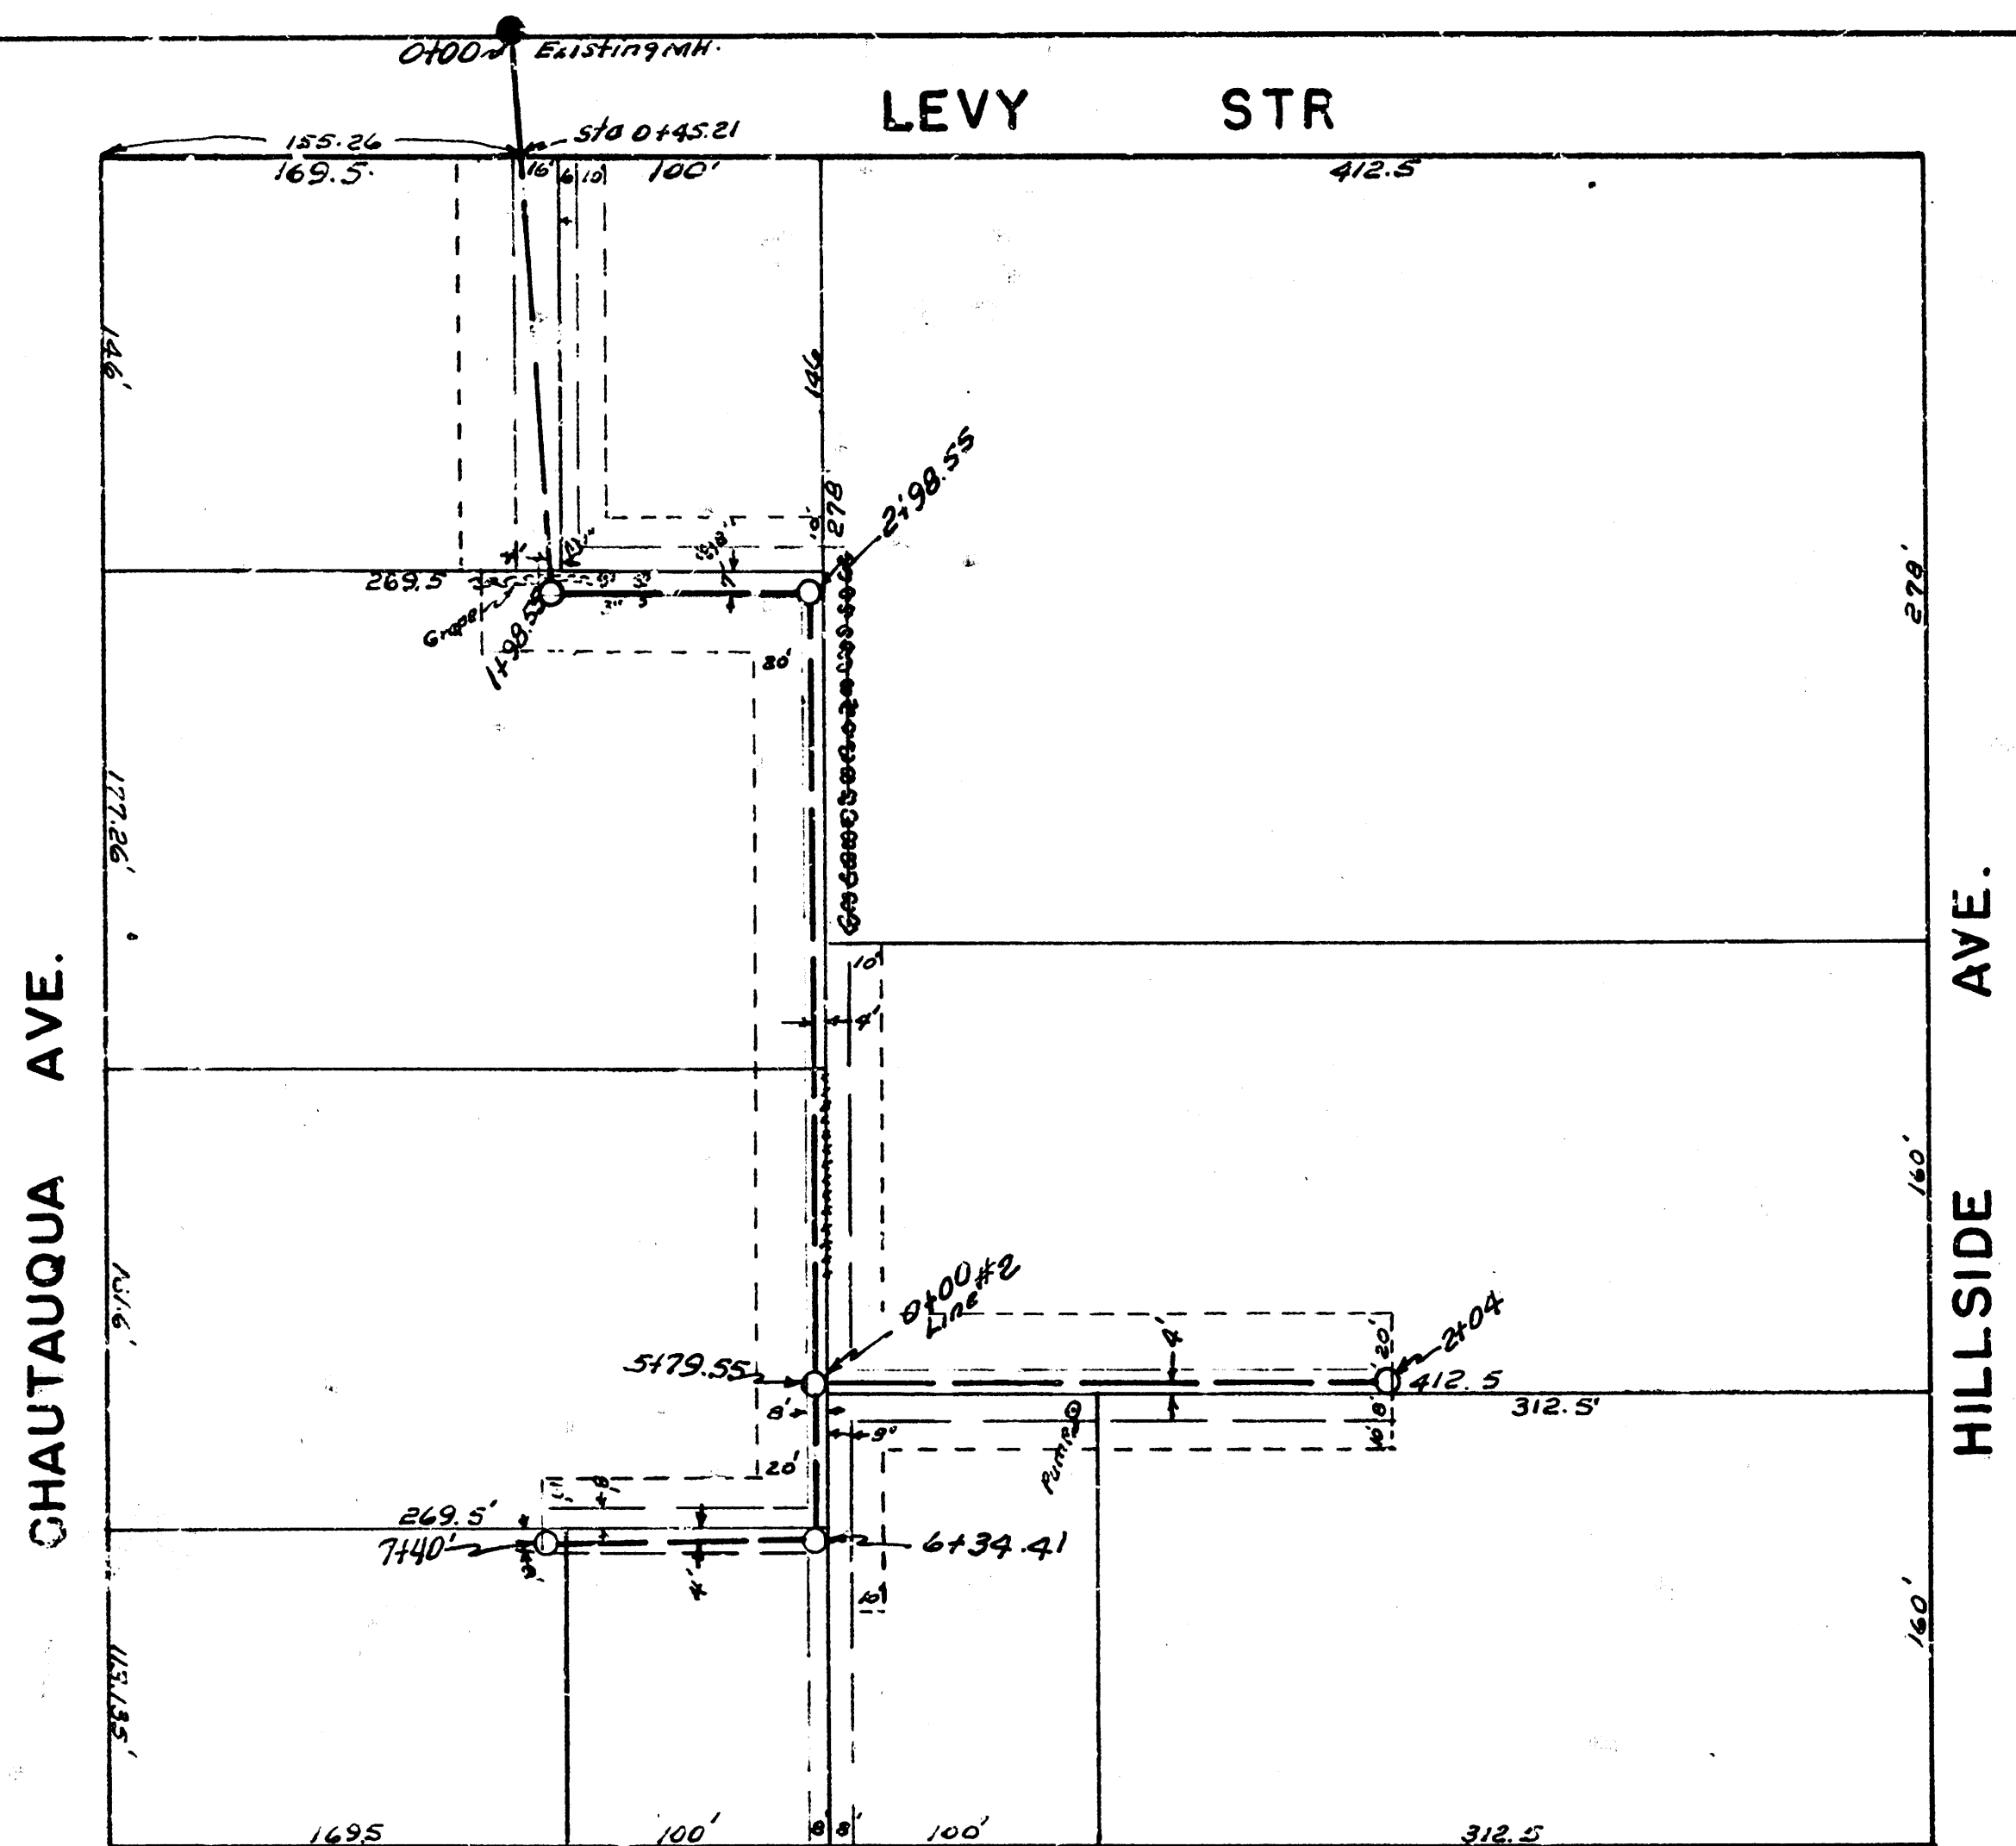
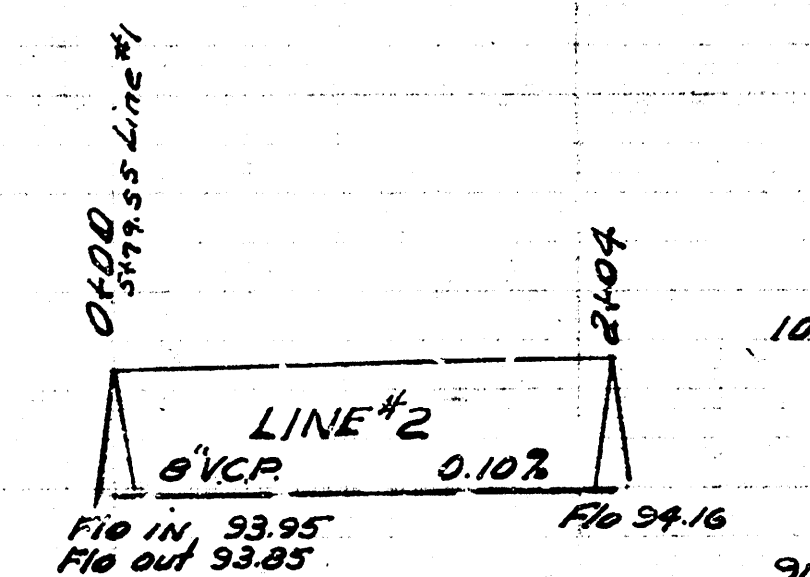


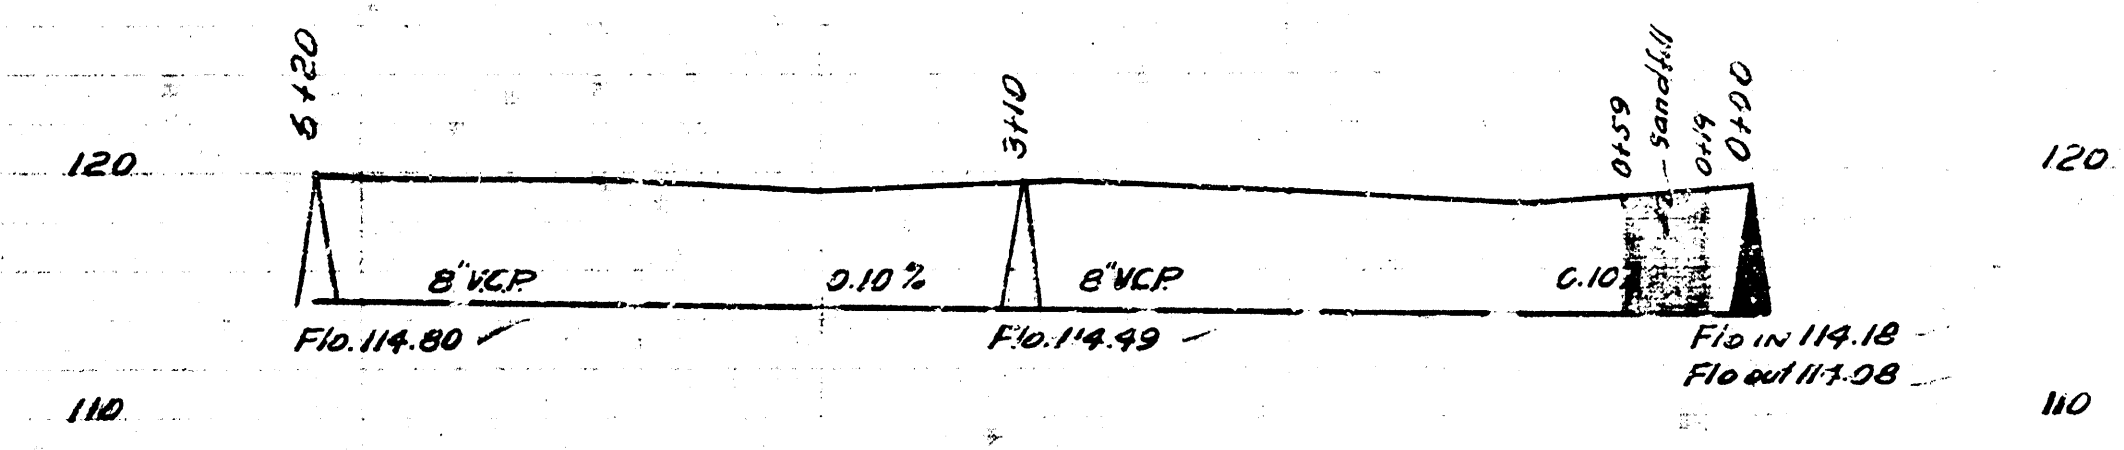


BM 100.72 Head 60" spike SW side Bell Tel. Pole #3000
NE Corner Chautauqua & Mt. Vernon

BM 119.33 So. Rim MH 0100

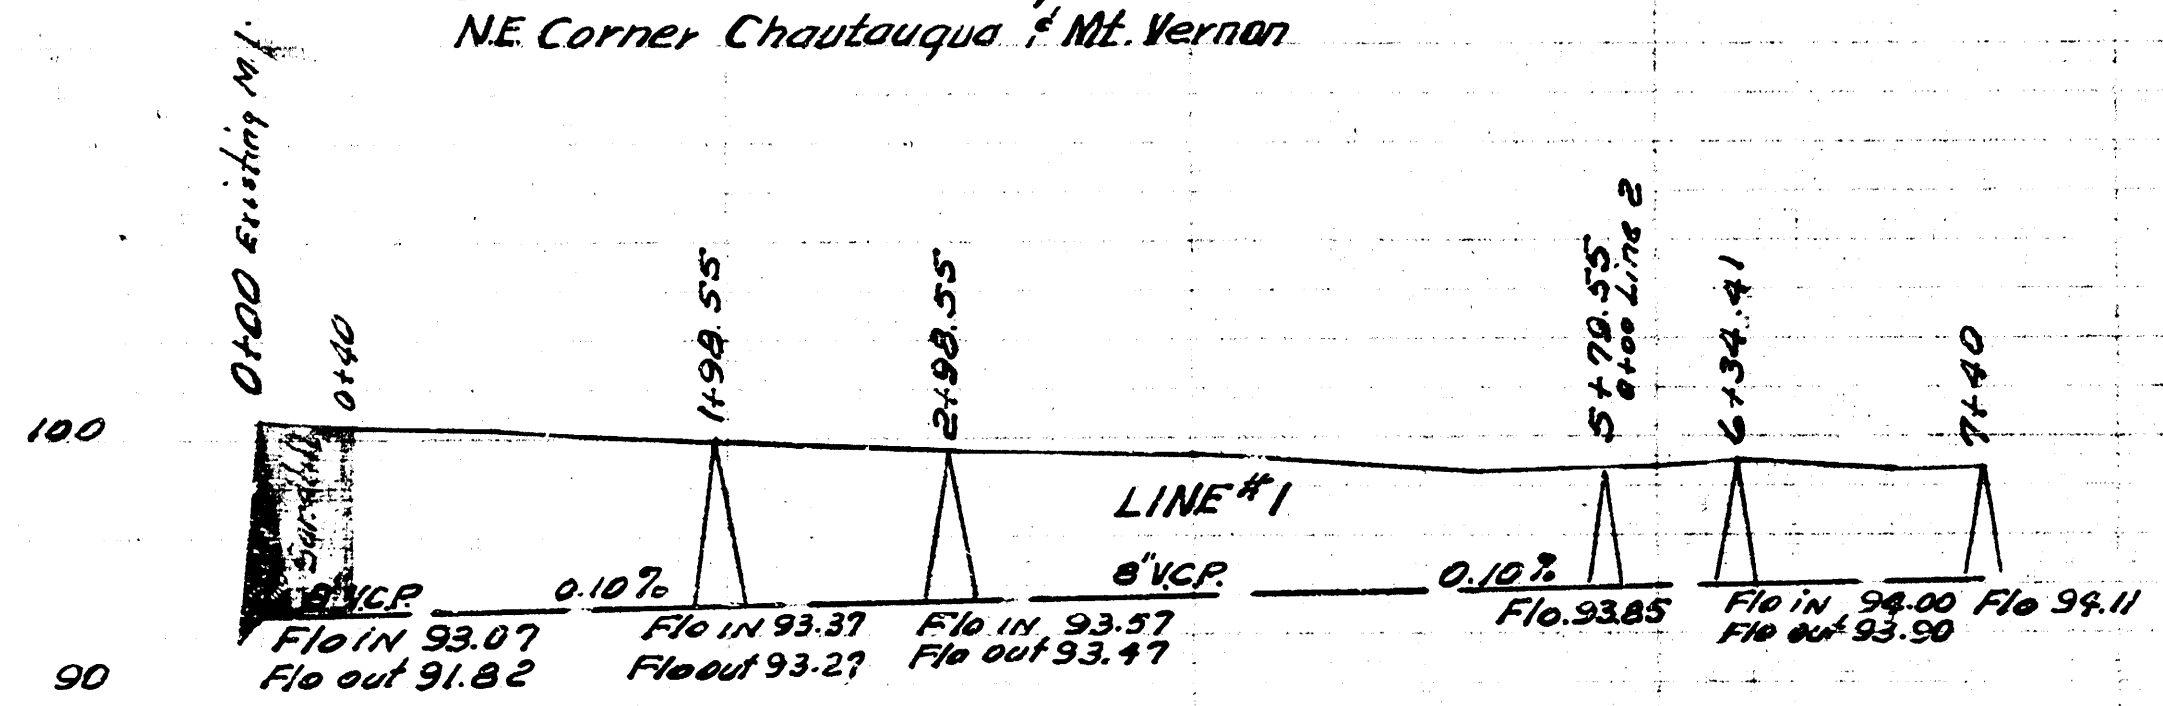

LAT 13 DCS 2 SS 12
CITY OF WICHITA KANSAS
LKW WHITE CITY ENGINEER
Proj No. C-22-79

LAT 13 DIST 0 SS 12
CITY OF WICHITA KANSAS
LKW WHITE CITY ENGINEER
Proj No. C-22-79

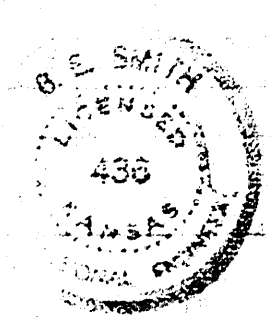

Date 9-19-52
Drawn by McClam
Checked by
Block No. N-26

Date 9-23-52
Drawn by McClam
Checked by
Block No. N-26