



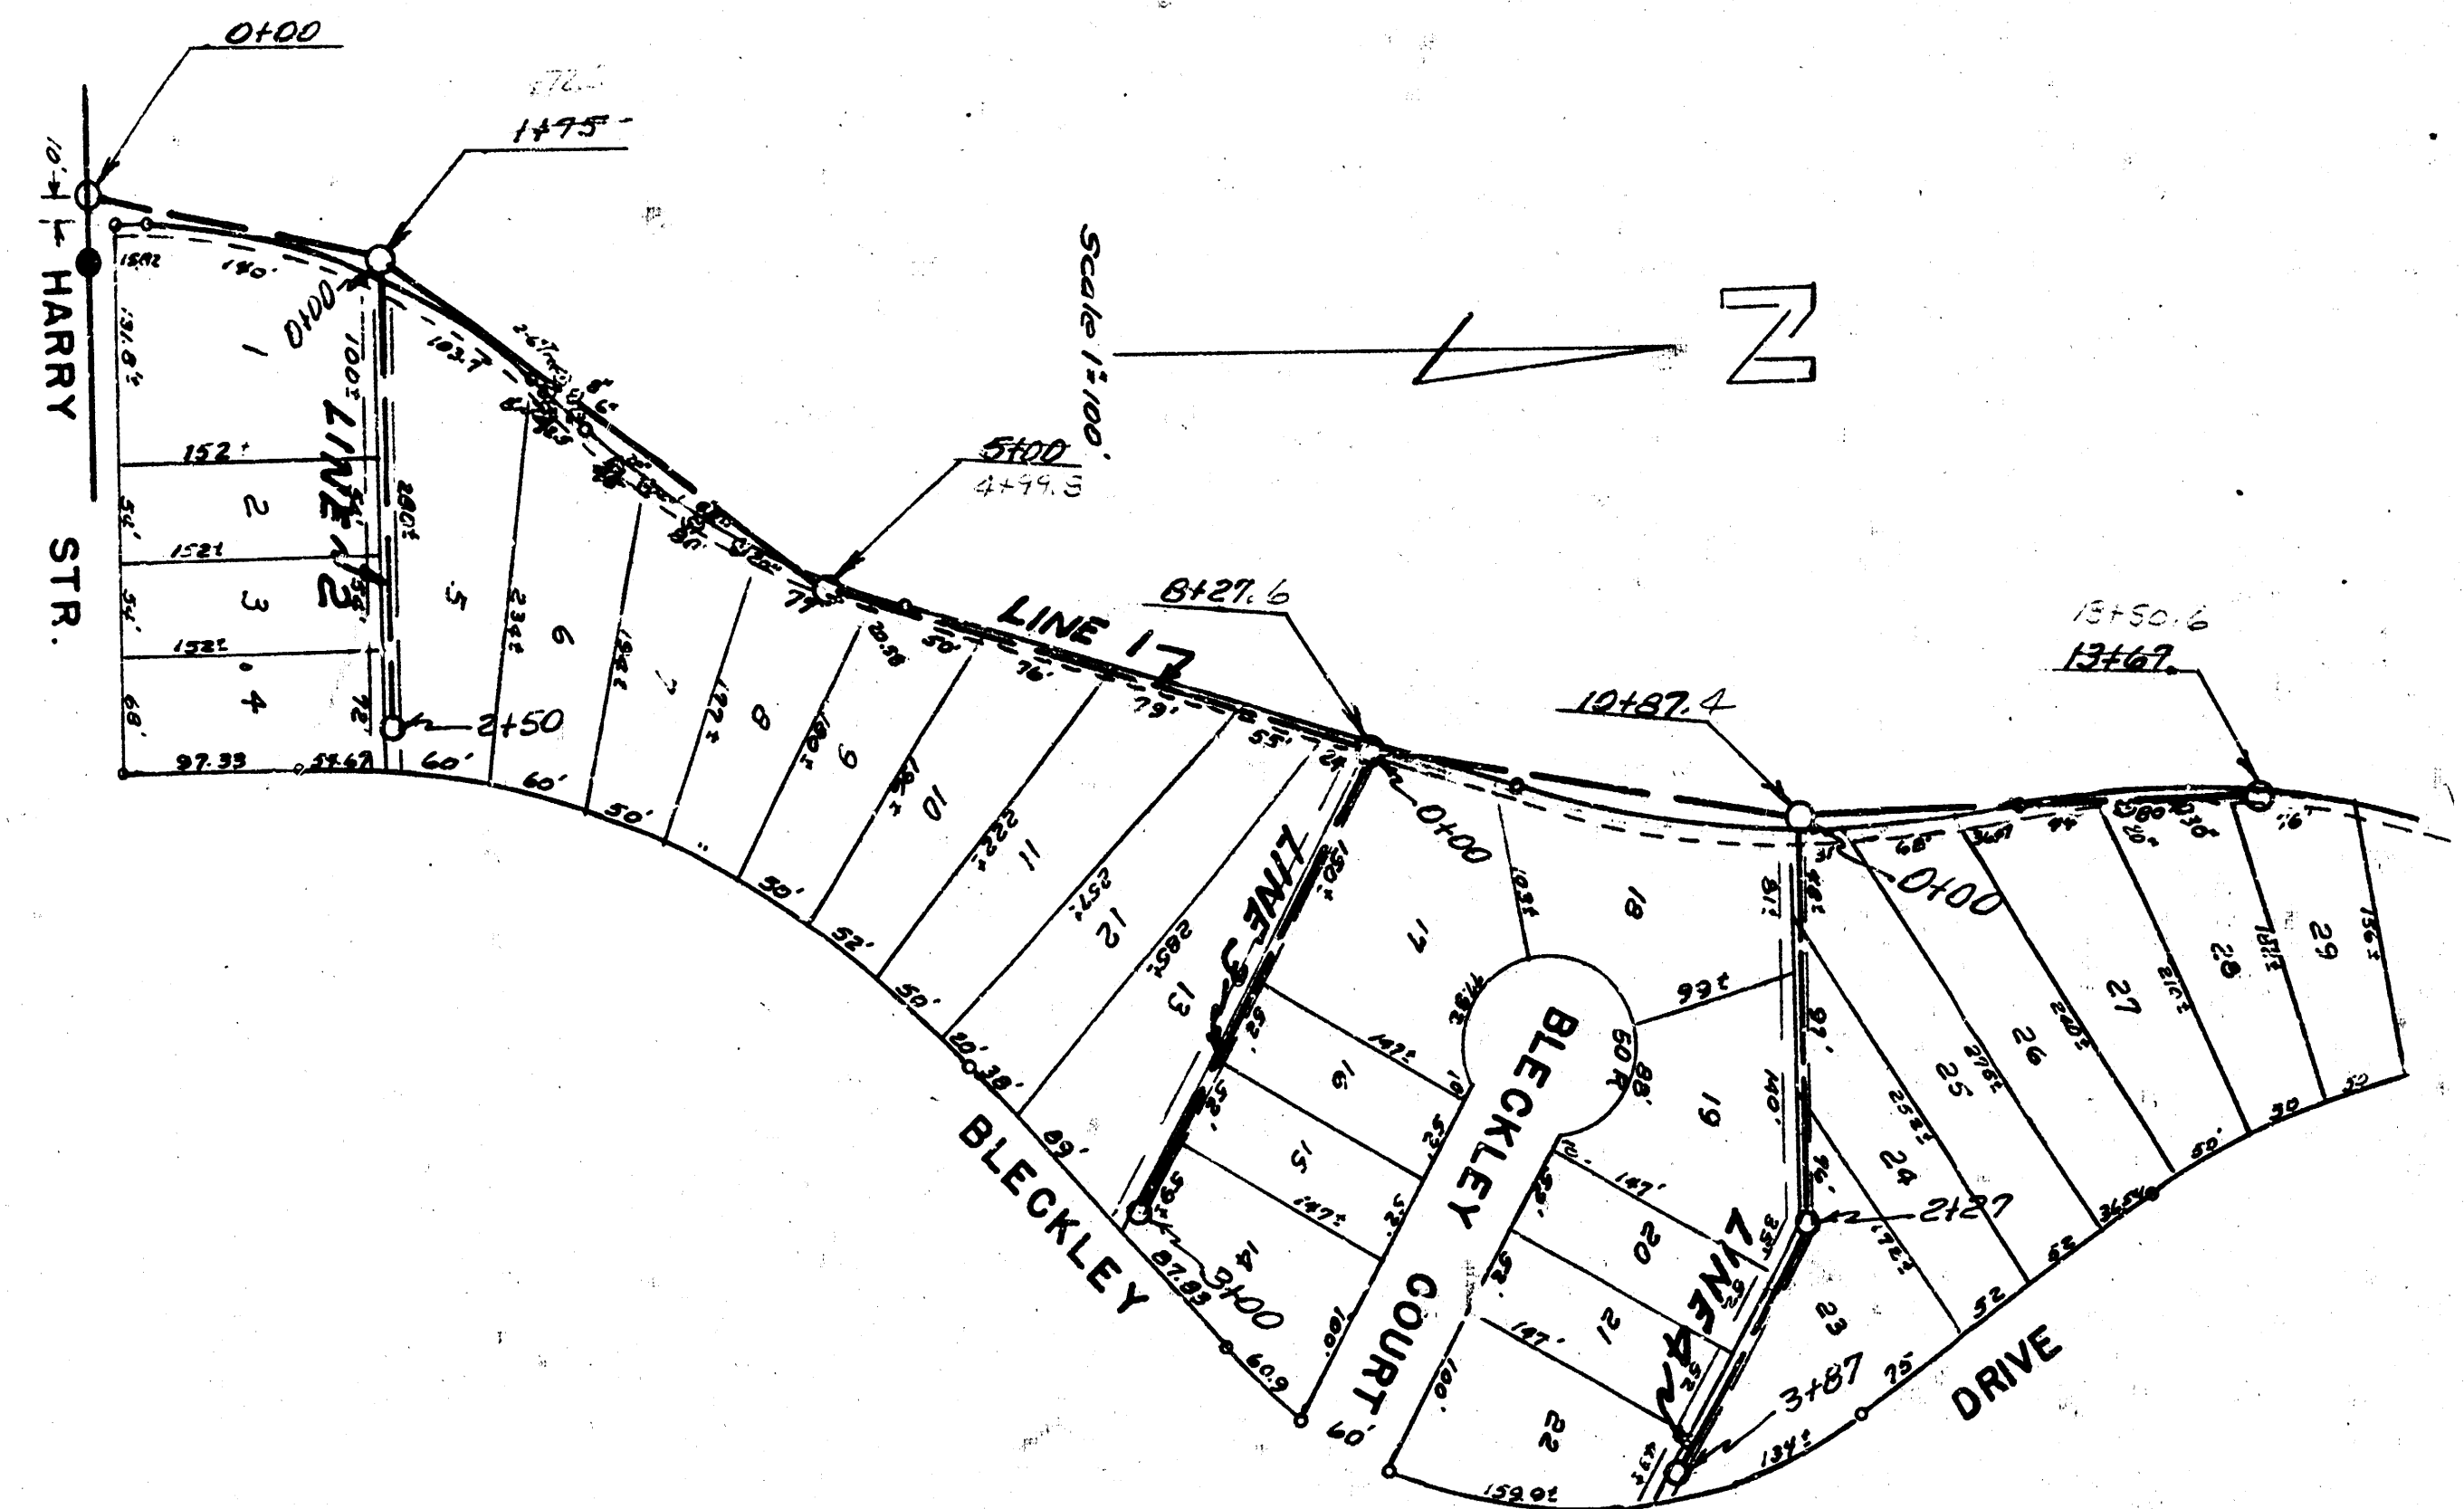

Date 10-1-52
 Drawn by M. C. Allen
 Checked by J. W. Allen
 10-1-52

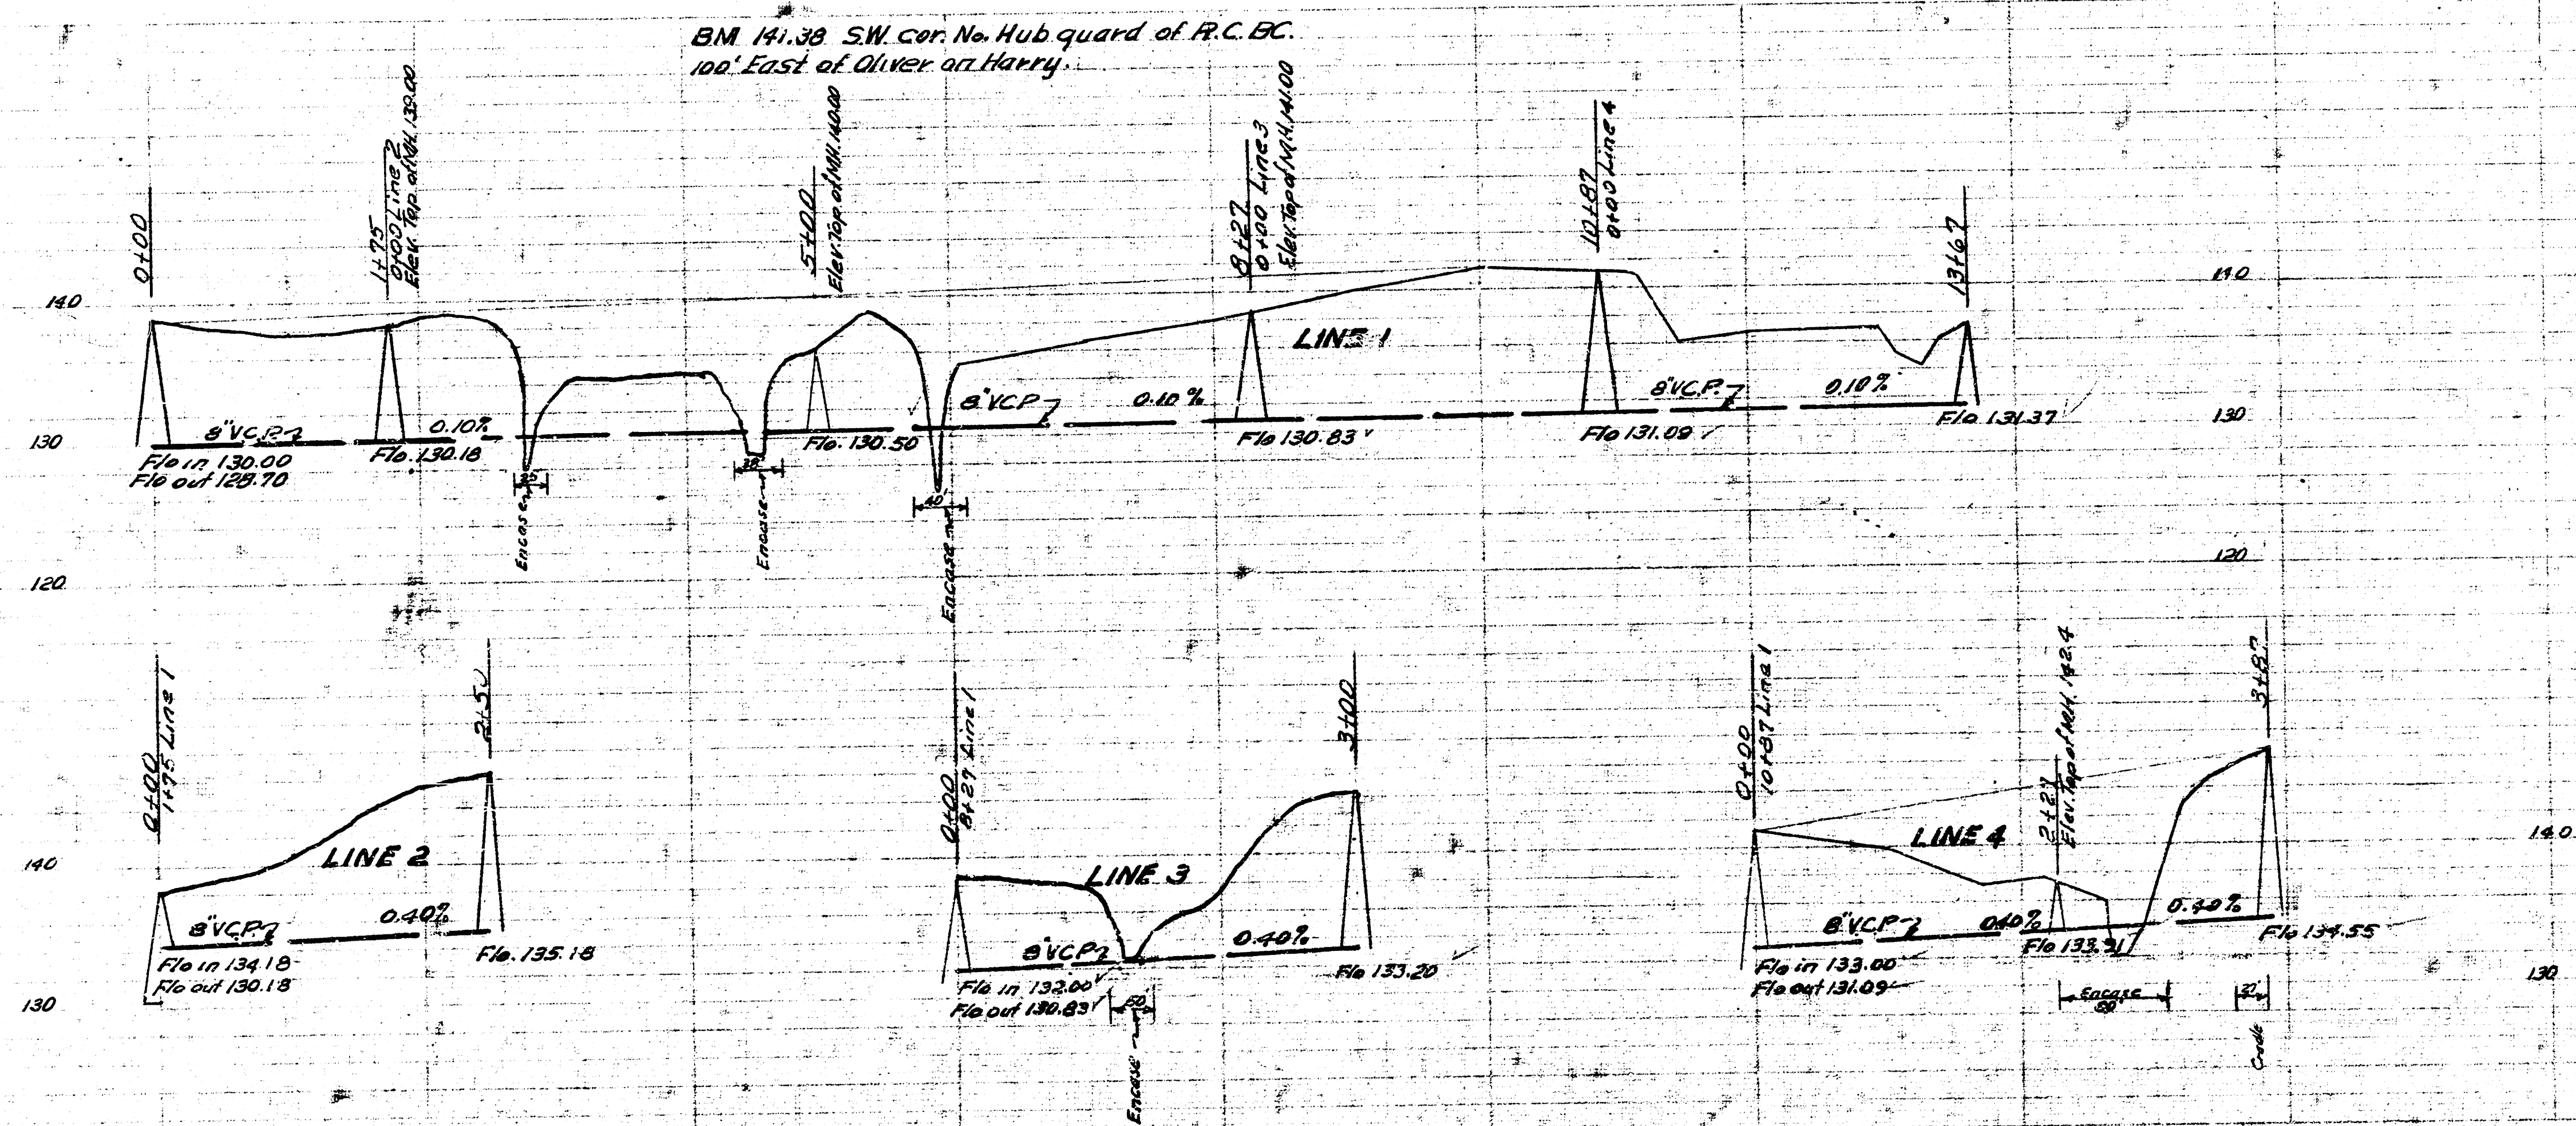

LAT. 23 DCS 2 SS 12
 CITY OF WICHITA KANSAS
 LK. WHITE CITY ENGINEER
 Proj No. C-22-62

