
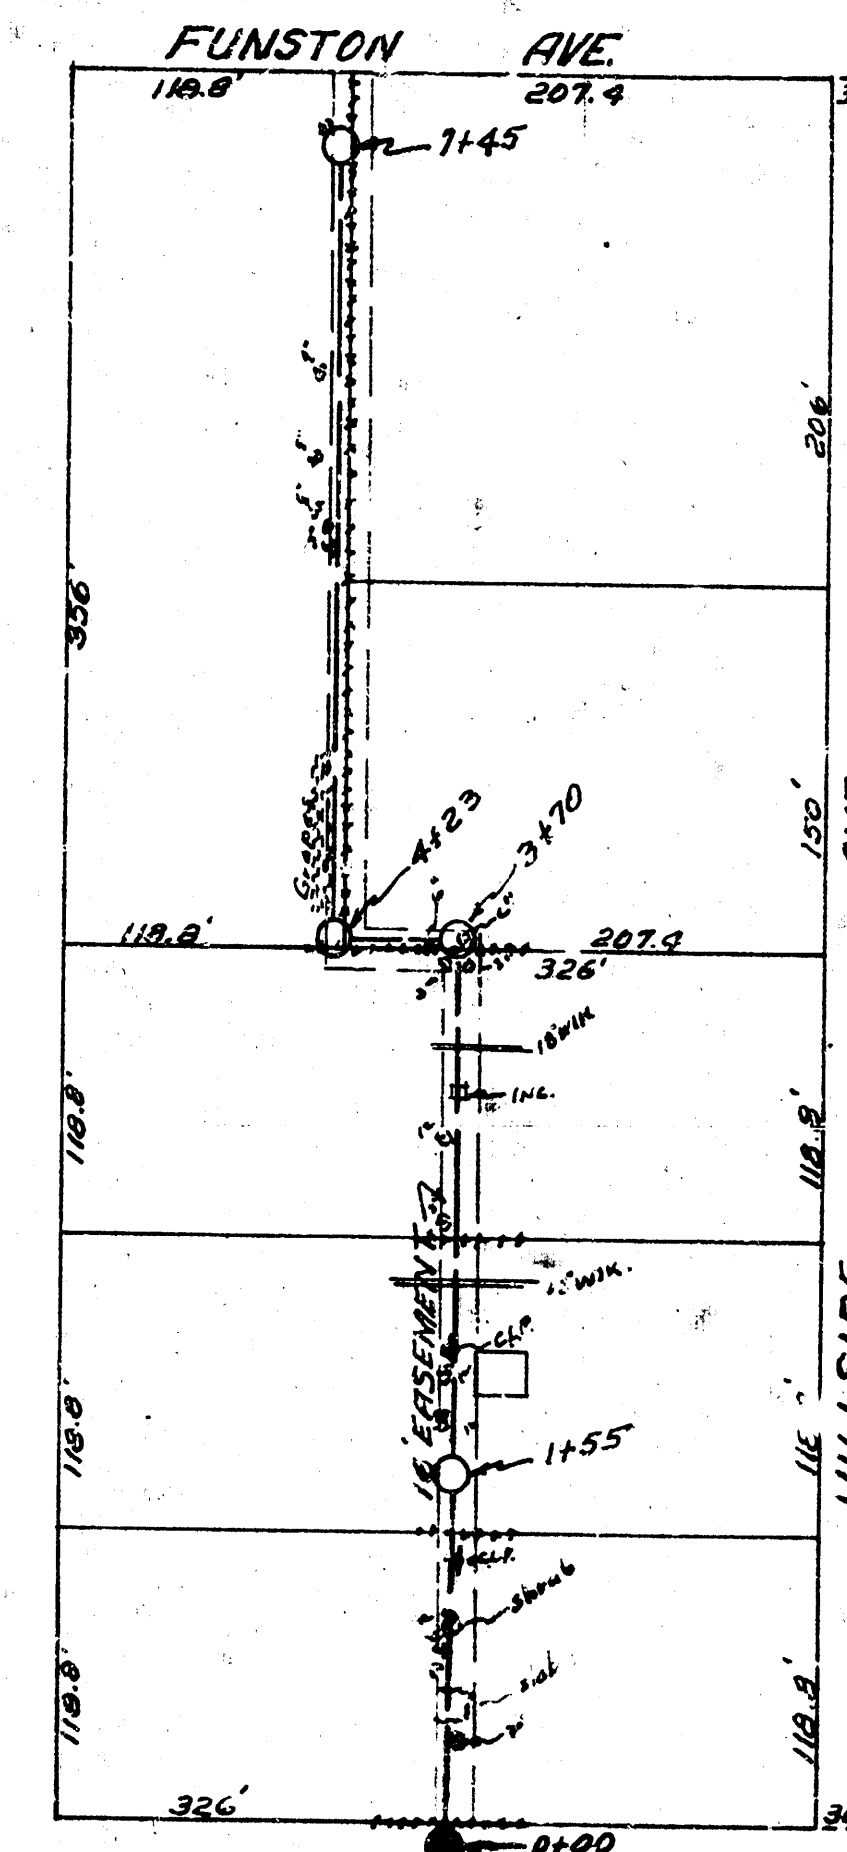



[illegible]

Date	Drawn by	Checked by	Book No.
9-1-53	McClain	[Signature]	78Y

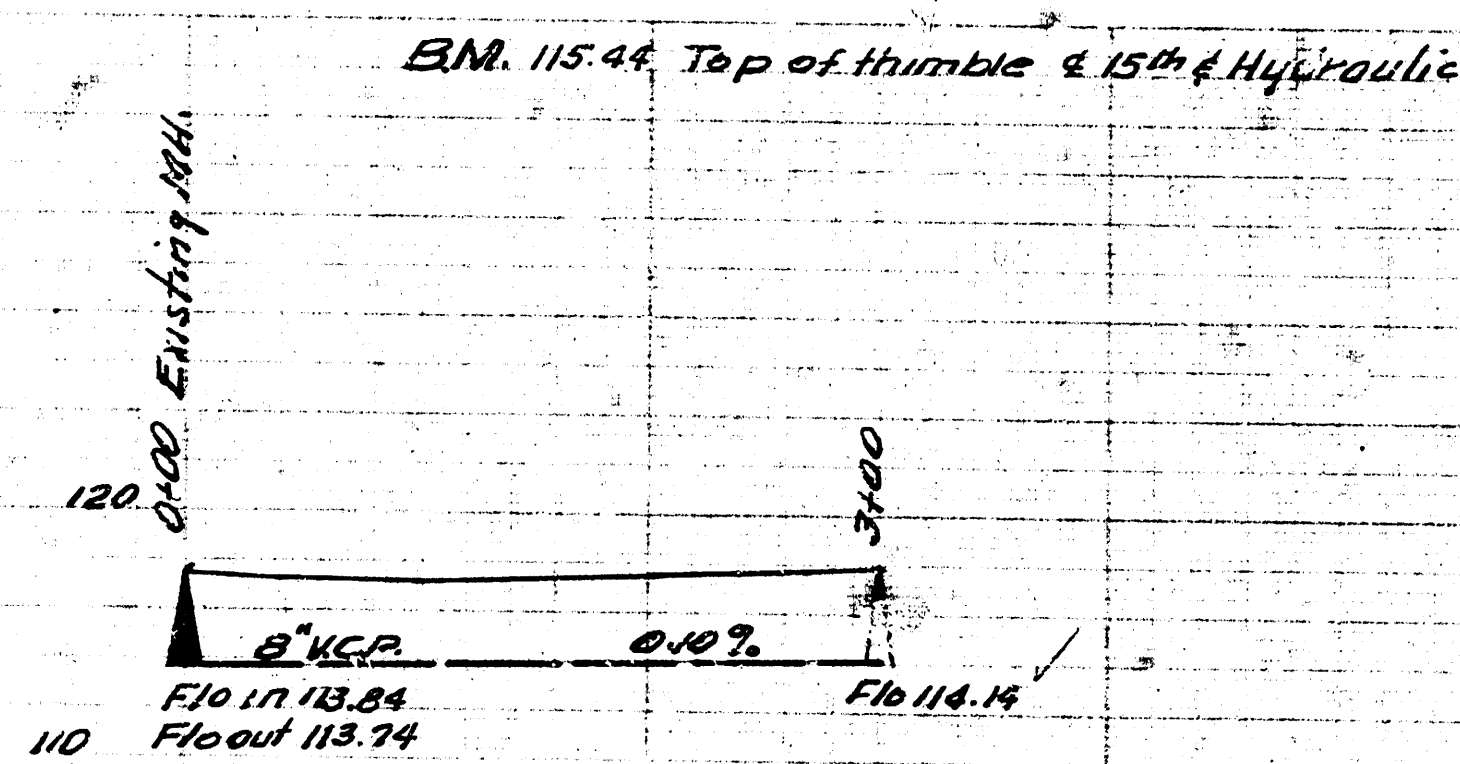

LAT. G. DIST. R. SS12
CITY OF WICHITA KANSAS
BESMITH CITY ENGINEER
Proj. No. C-22-95

Date _____
Drawn by _____
Checked by _____
Book No. _____

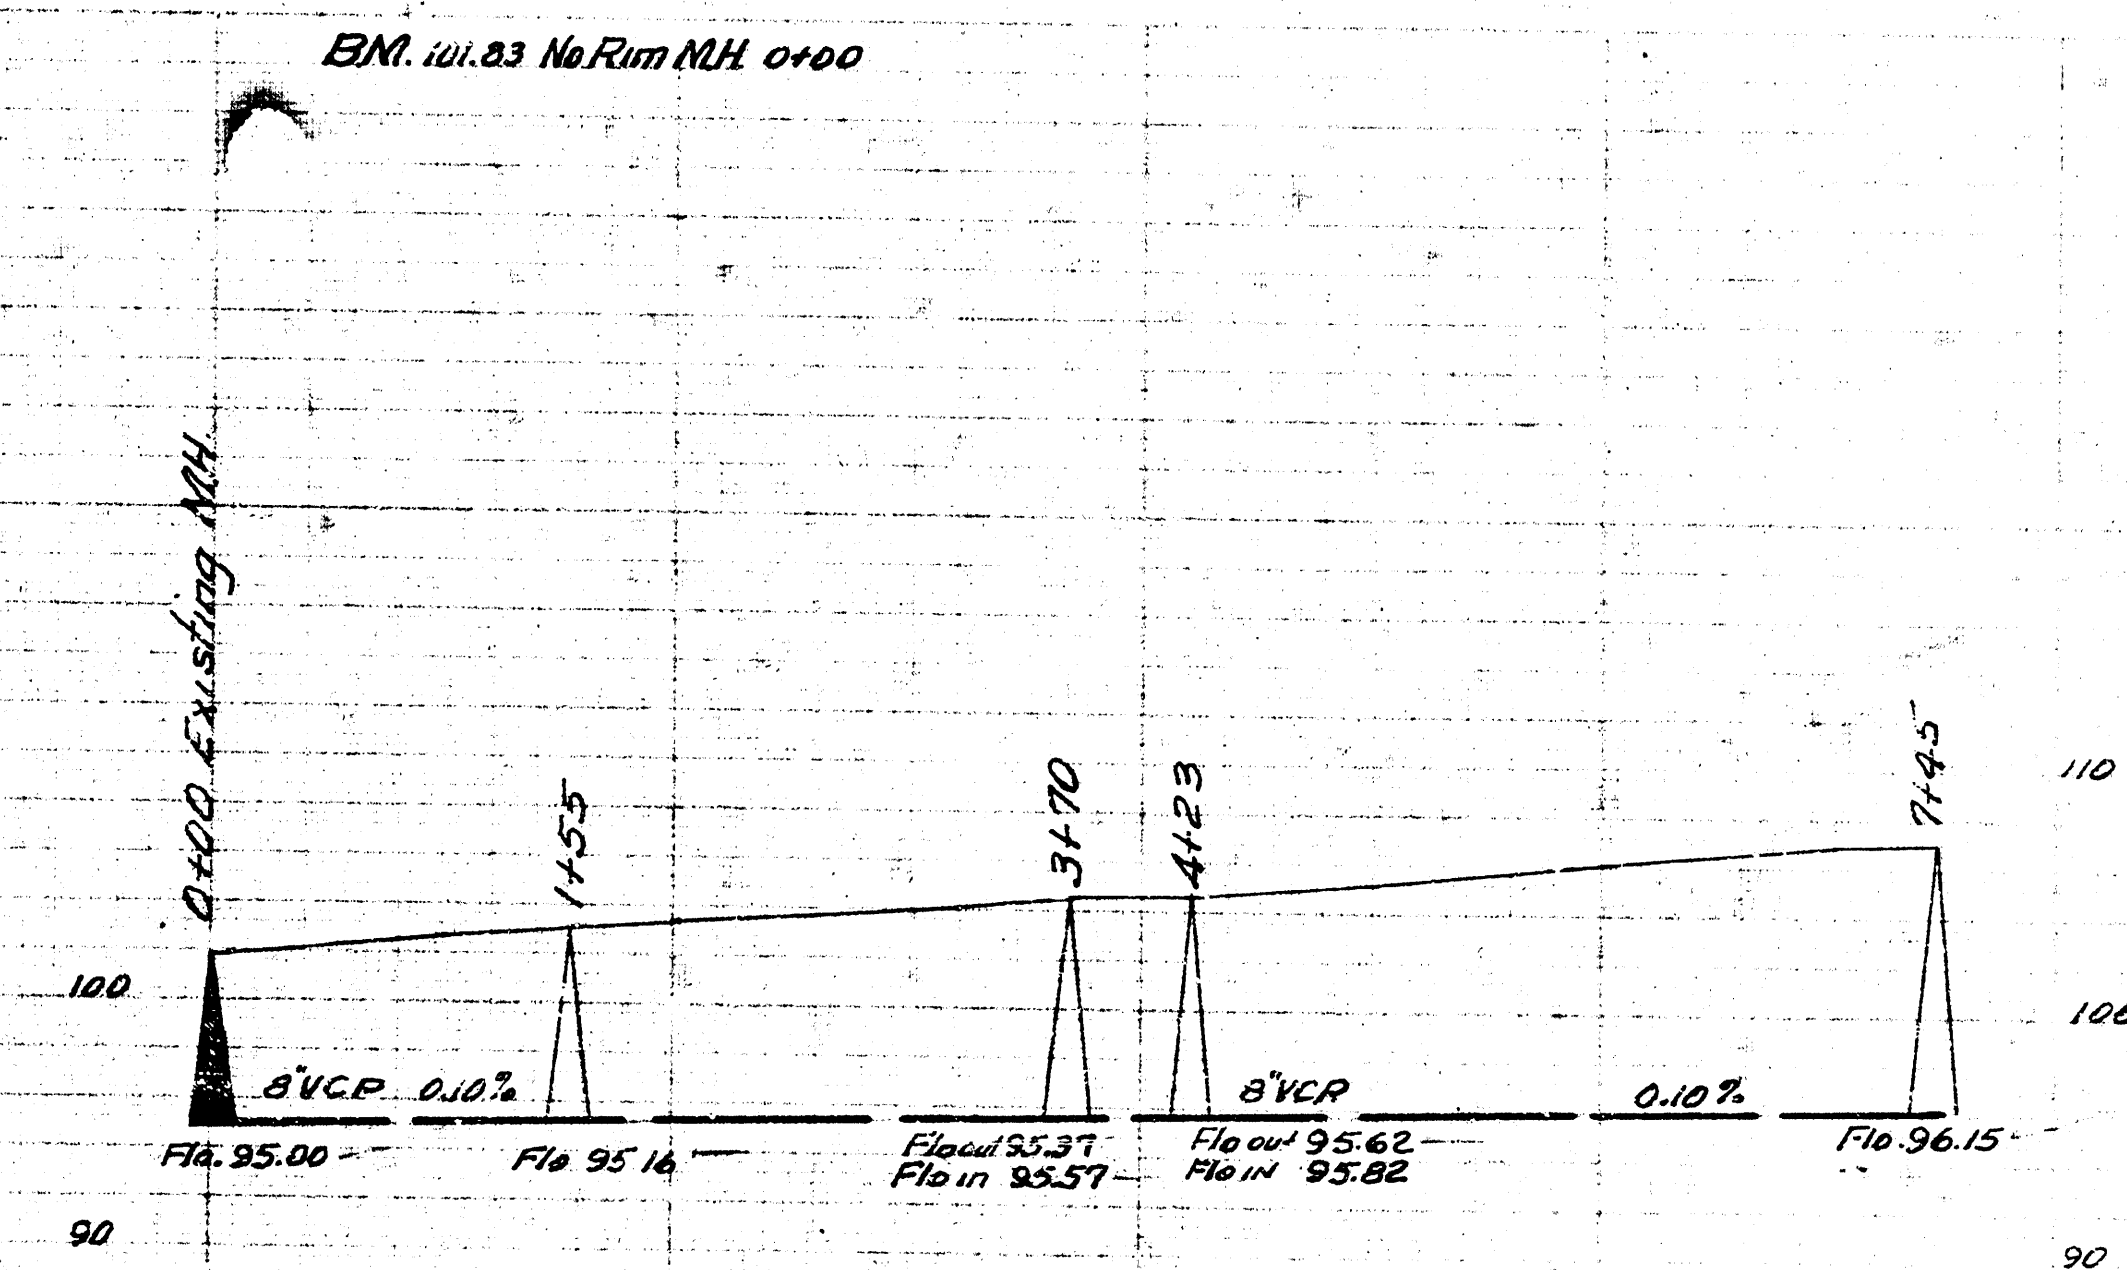

LAT 26 DCS.2 SS.12
CITY OF WICHITA KANSAS
BE. SMITH CITY ENGINEER
Proj. No. C-22-81