
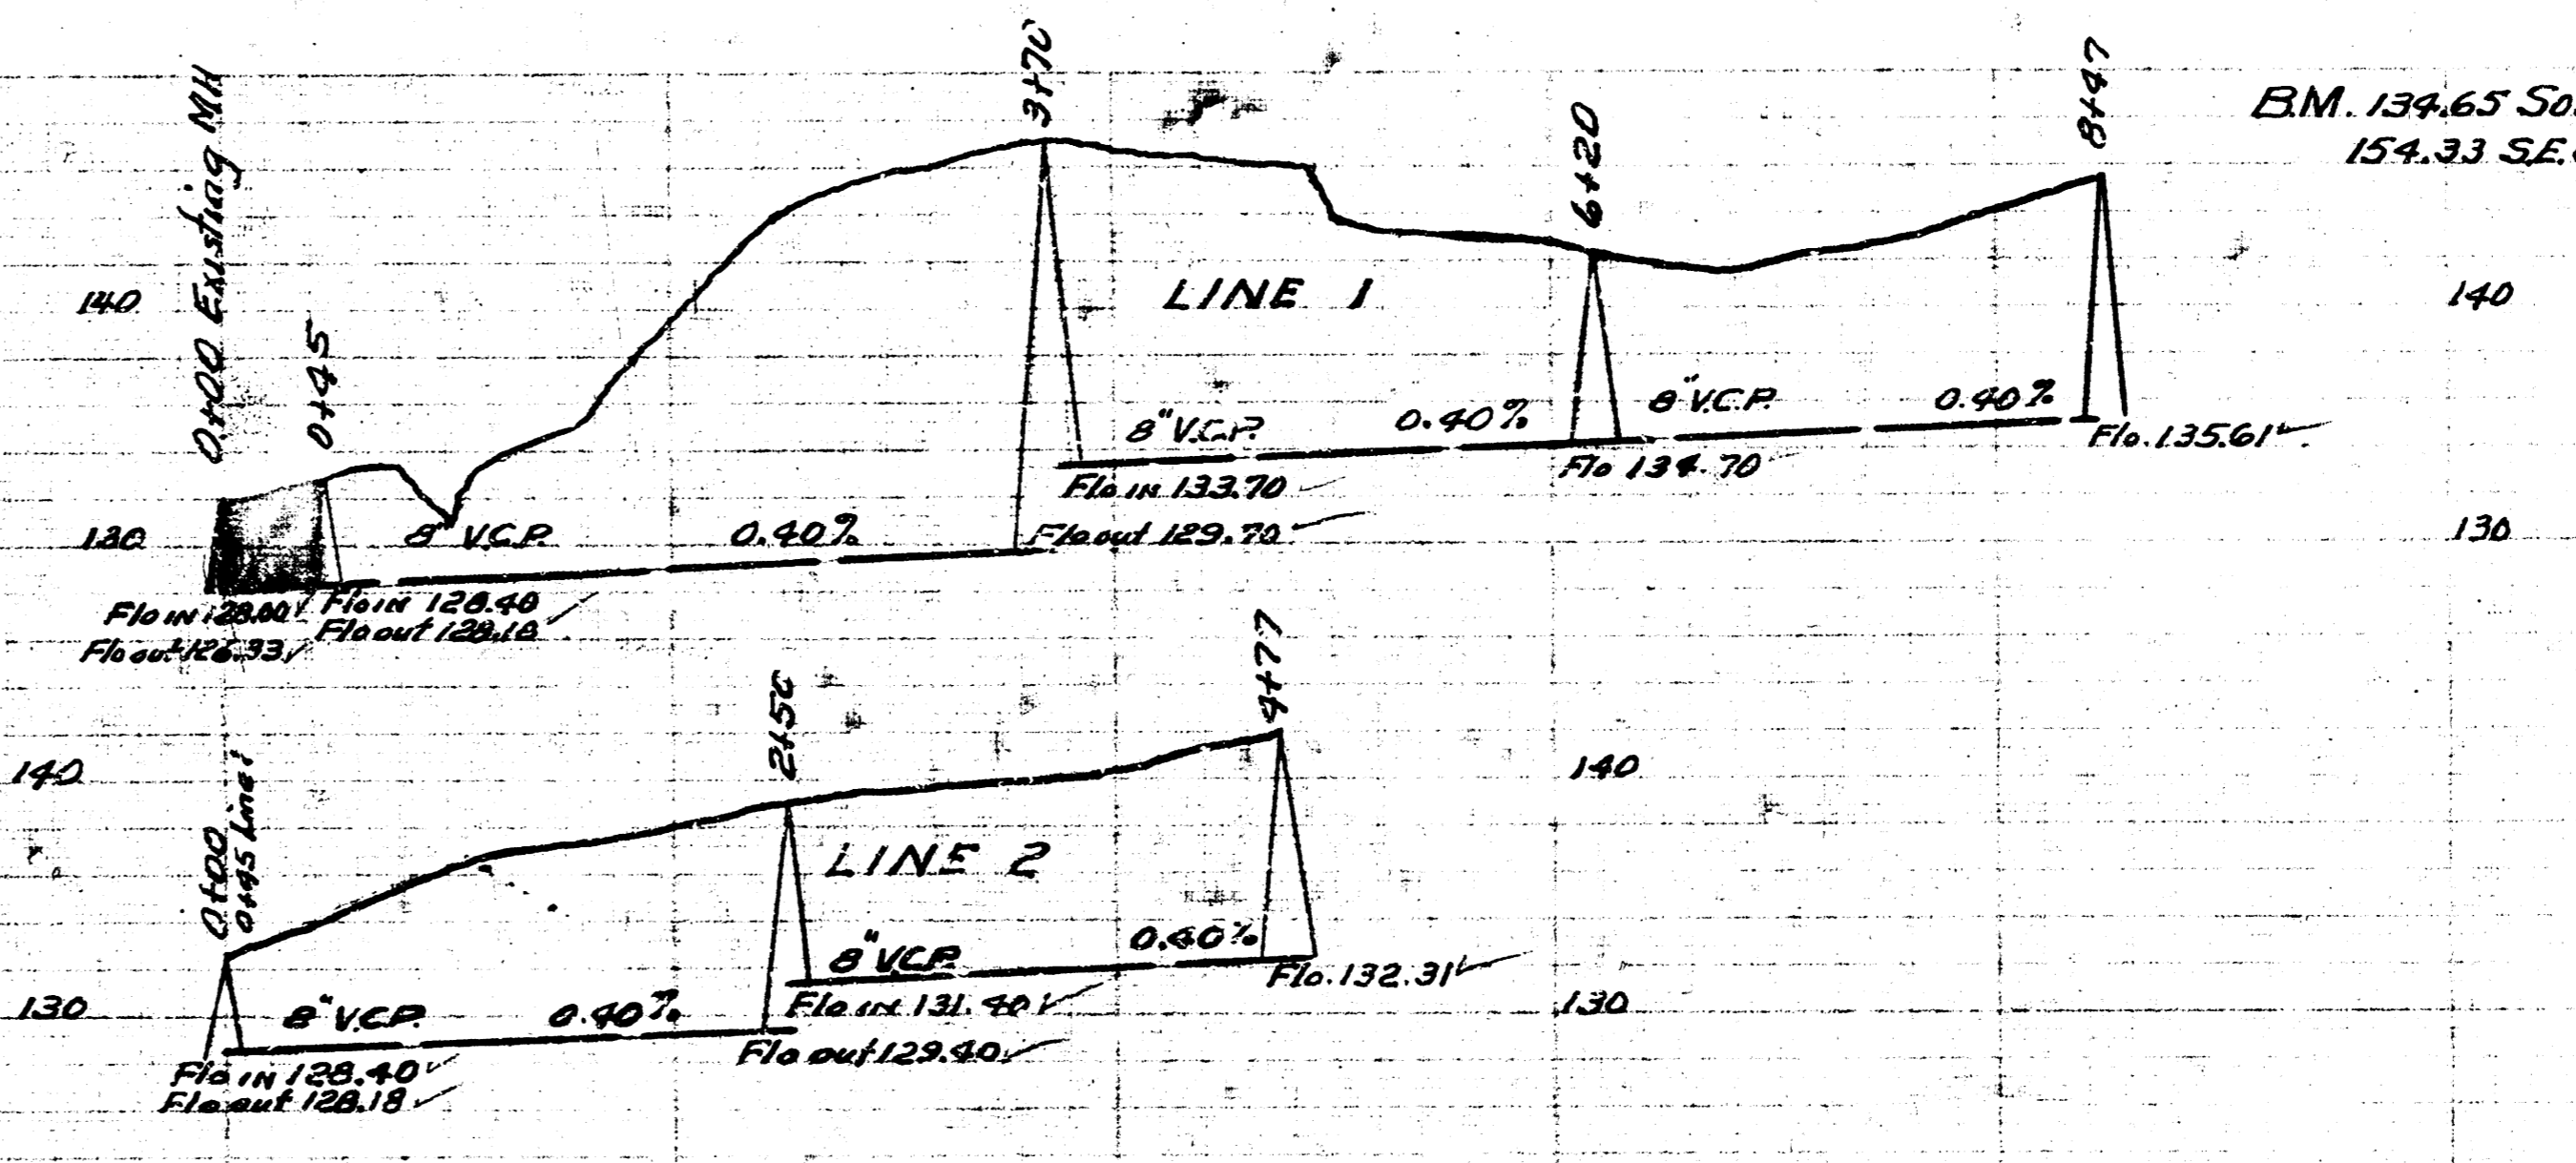


B.M. 157.94 M in Mueller Fireplug  
SE corner 26th & Grove

B.M. 134.65 So. Firm M.H. 0+00 LINE 1  
154.33 SE. cor. conc. porch 1129 SA 144

Date 3-11-53  
Drawn by A. McLean  
Checked by B. Smith

Date 12-14-53  
Drawn by A. McLean  
Checked by B. Smith

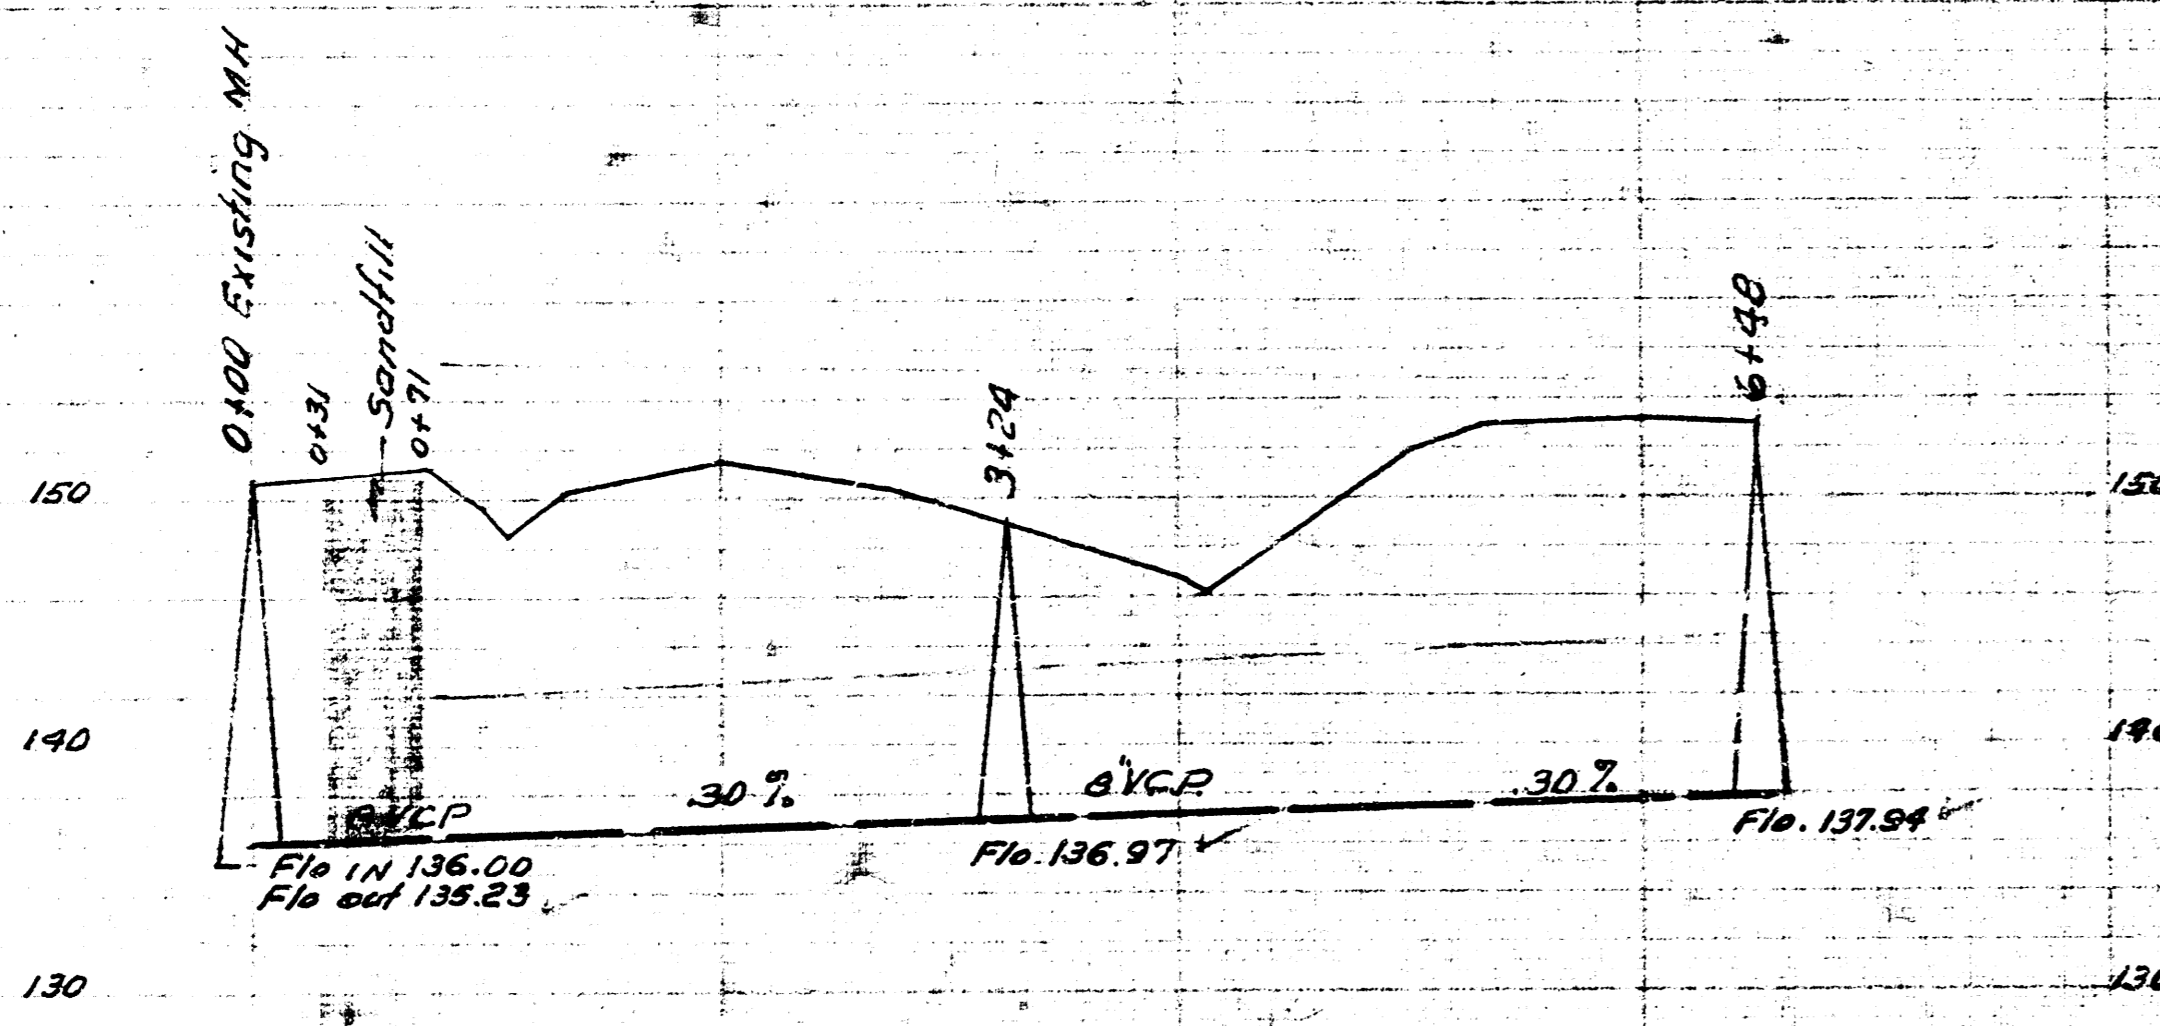

LAT. 32 DIST. T. SS. 12  
CITY OF WICHITA KANSAS  
BE. SMITH CITY ENGINEER  
Proj No. C 23-9

LAT. 30 DGS. 2 SS. 12  
CITY OF WICHITA KANSAS  
BE. SMITH CITY ENGINEER  
Proj No. C 23-10

