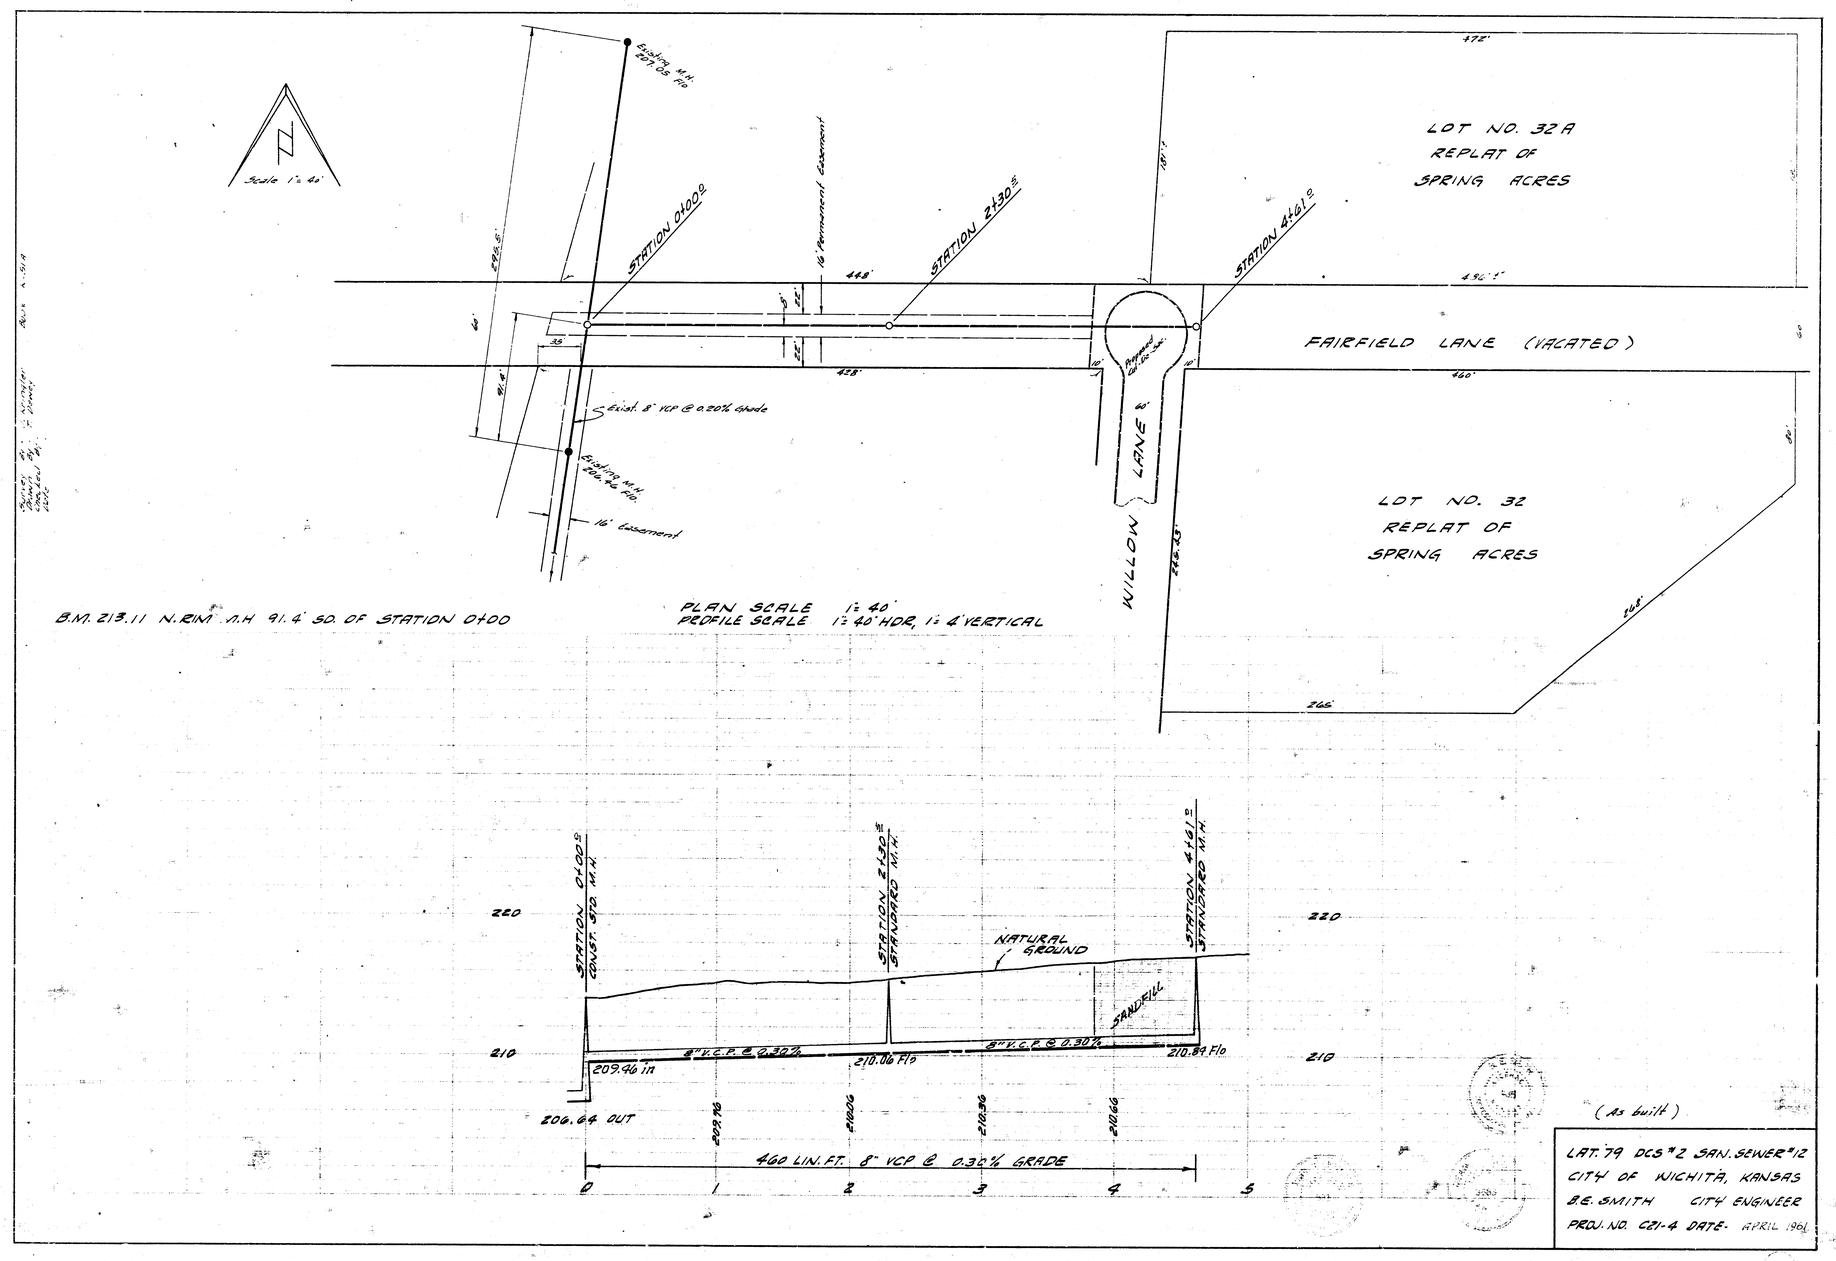

(As Built)

LAT. 79 DCS #2 SAN. SEWER #12
CITY OF WICHITA, KANSAS
B.E. SMITH CITY ENGINEER
PROJ. NO. C21-4 DATE- APRIL 1961