

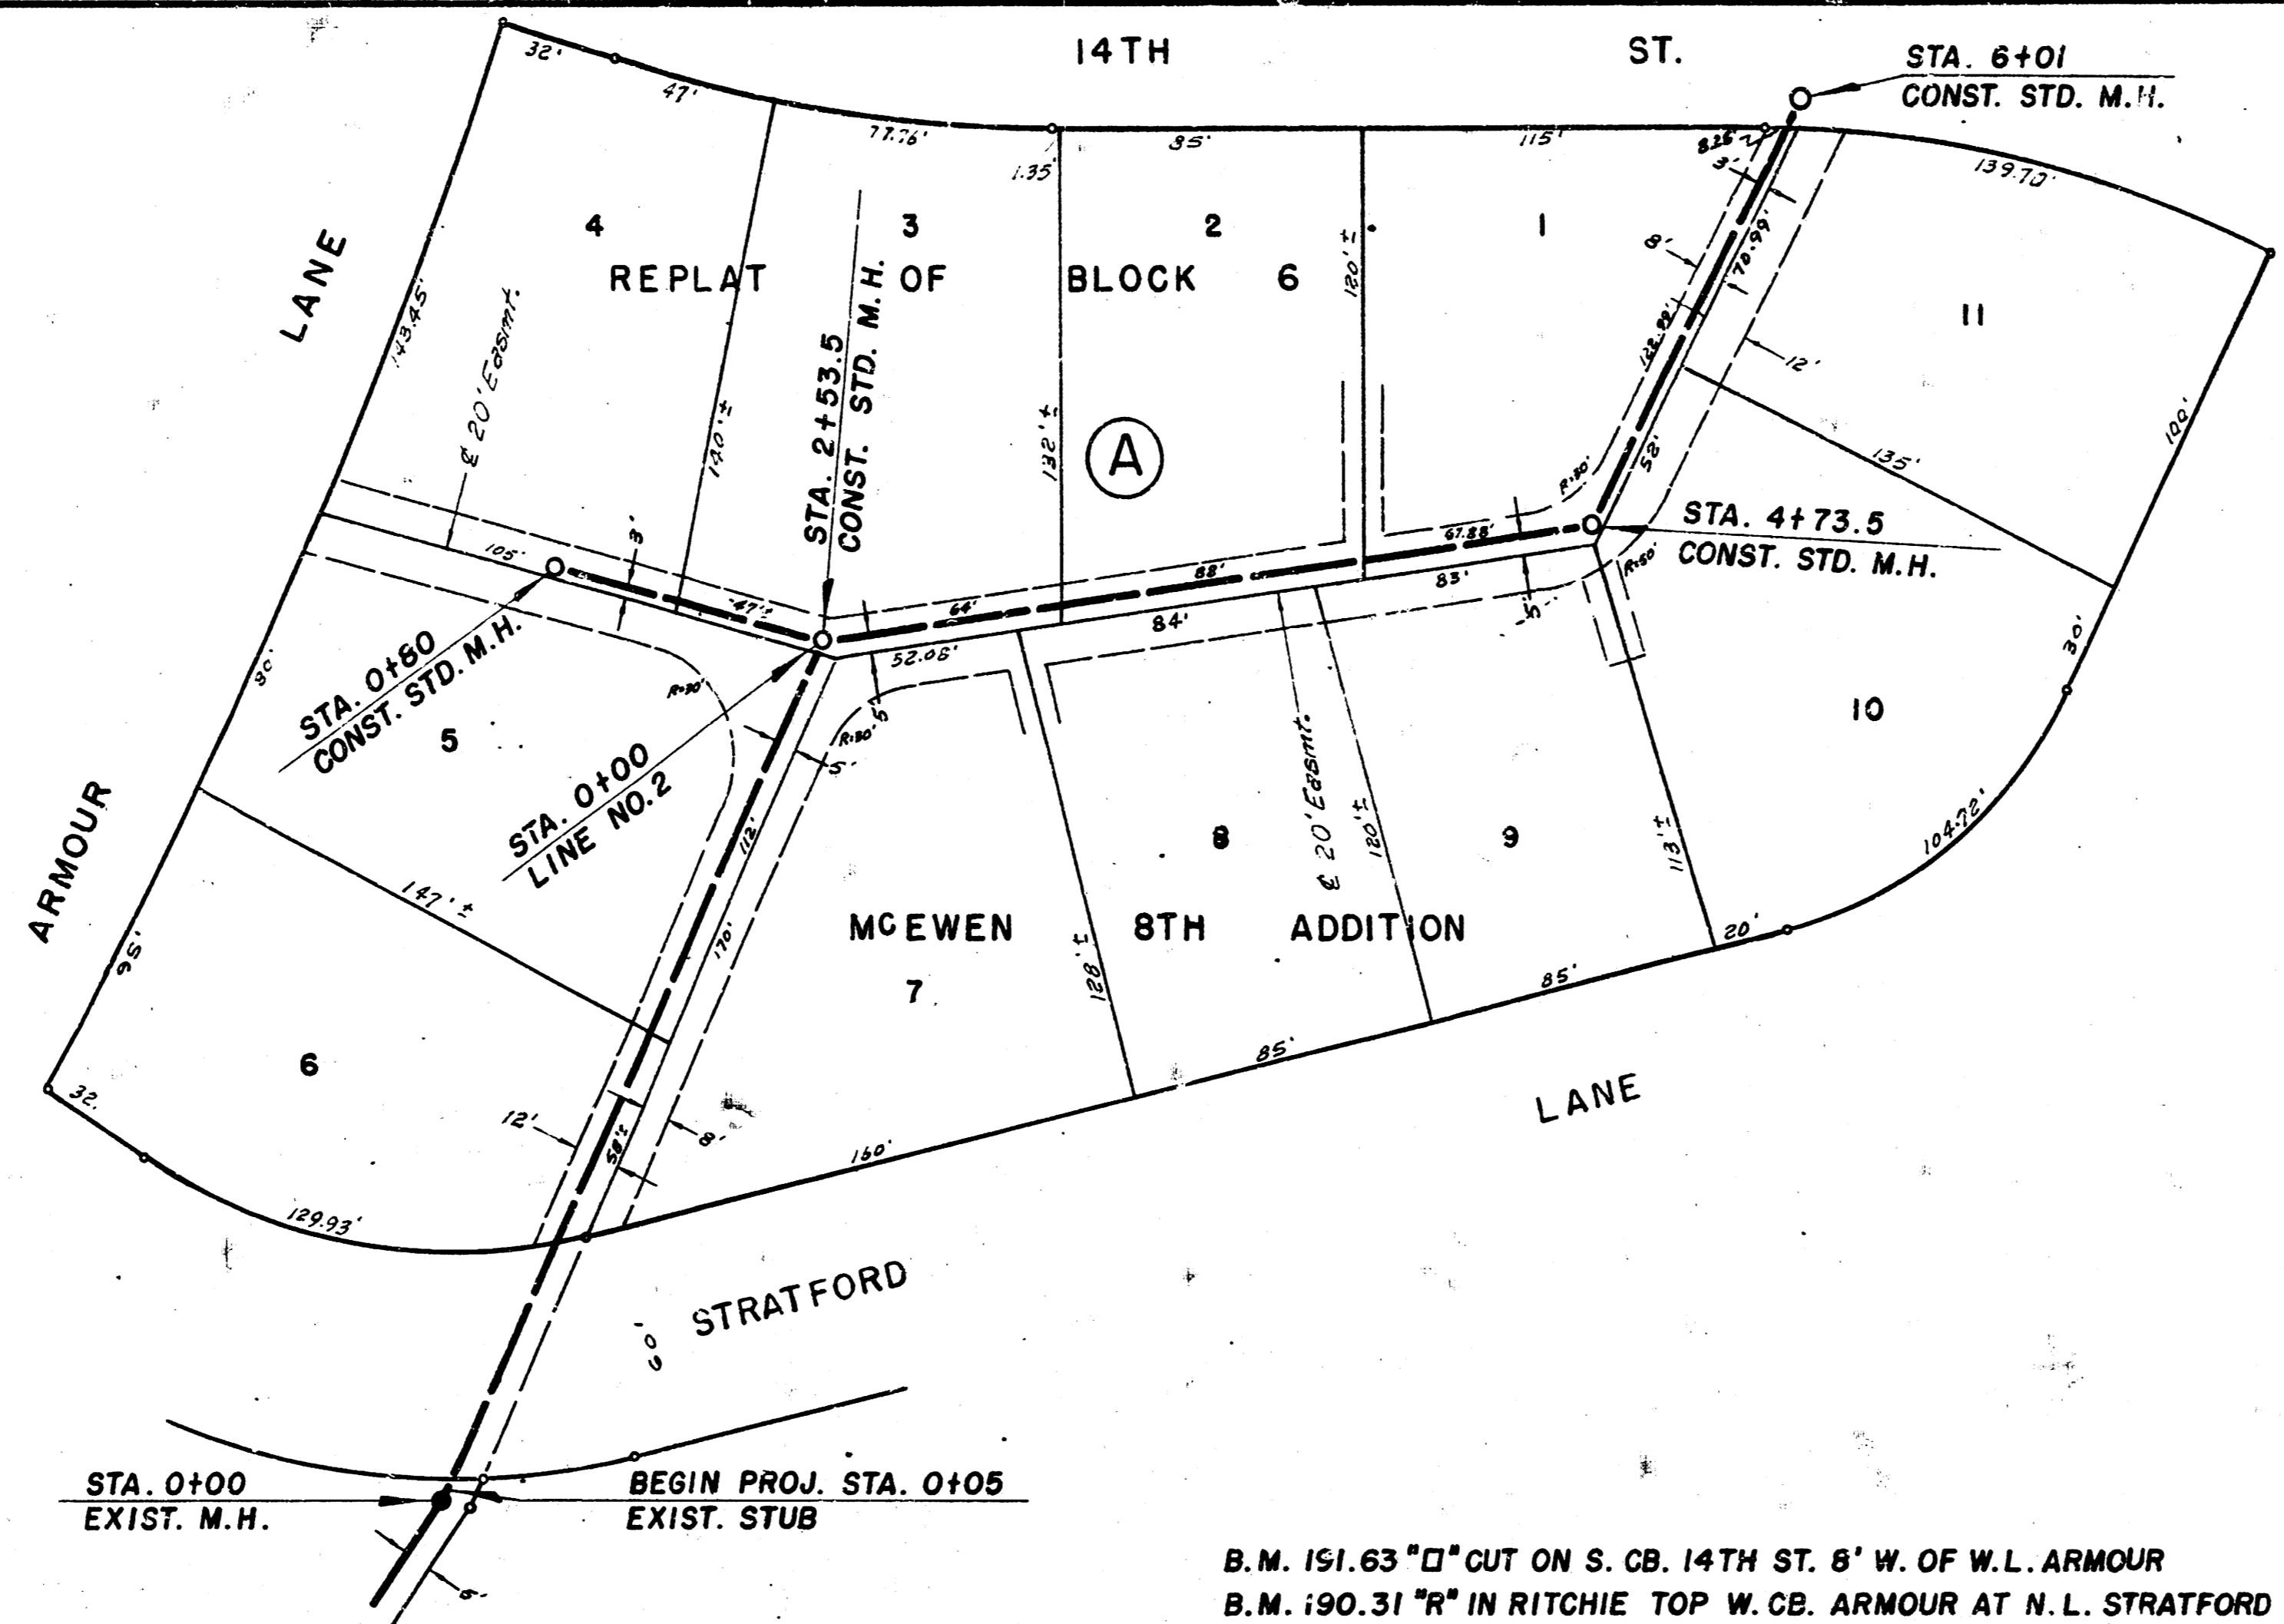


Surveyed by J. F. G. BK. No. J. F. G. 37
 Plans by J. M. C. Checked by J. M. C. Date:

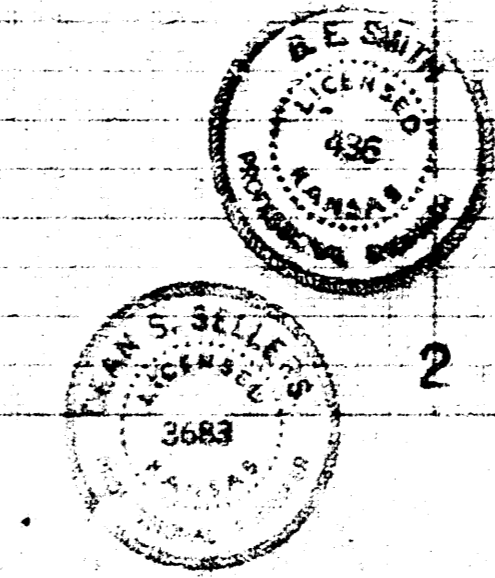

PLAN SCALE 1"=40'
 PROFILE SCALE 1"=40' HOR.
 1"=4' VERT.

 B. M. 190.31 "R" IN RITCHIE TOP W. CB. ARMOUR AT N. L. STRATFORD

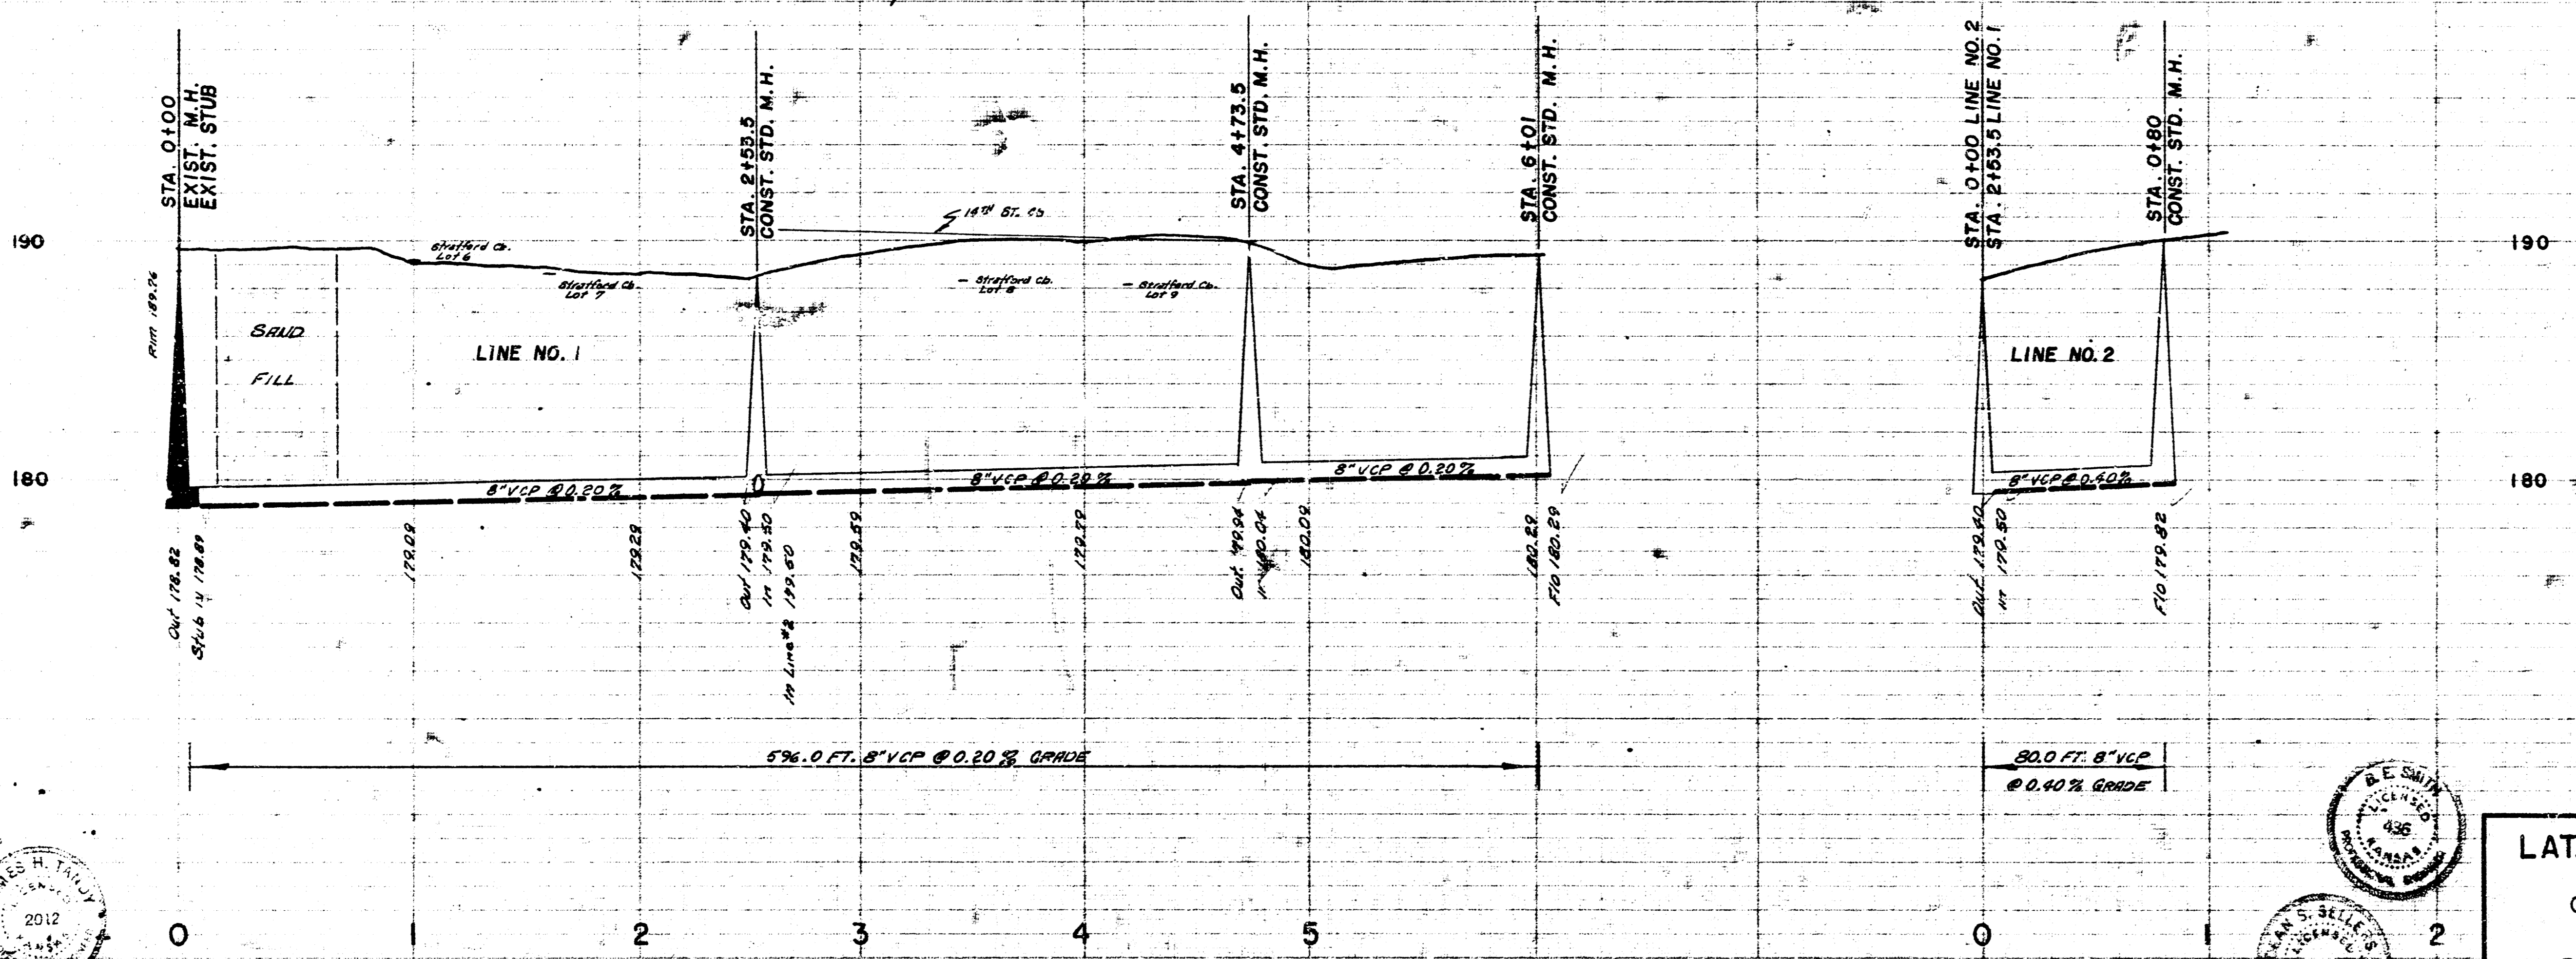

LAT. 86, D.C.S. 2, S. S. NO. 12
 CITY OF WICHITA, KANSAS
 B. E. SMITH CITY ENGINEER
 MAY 1963 PROJECT. NO. C22-20