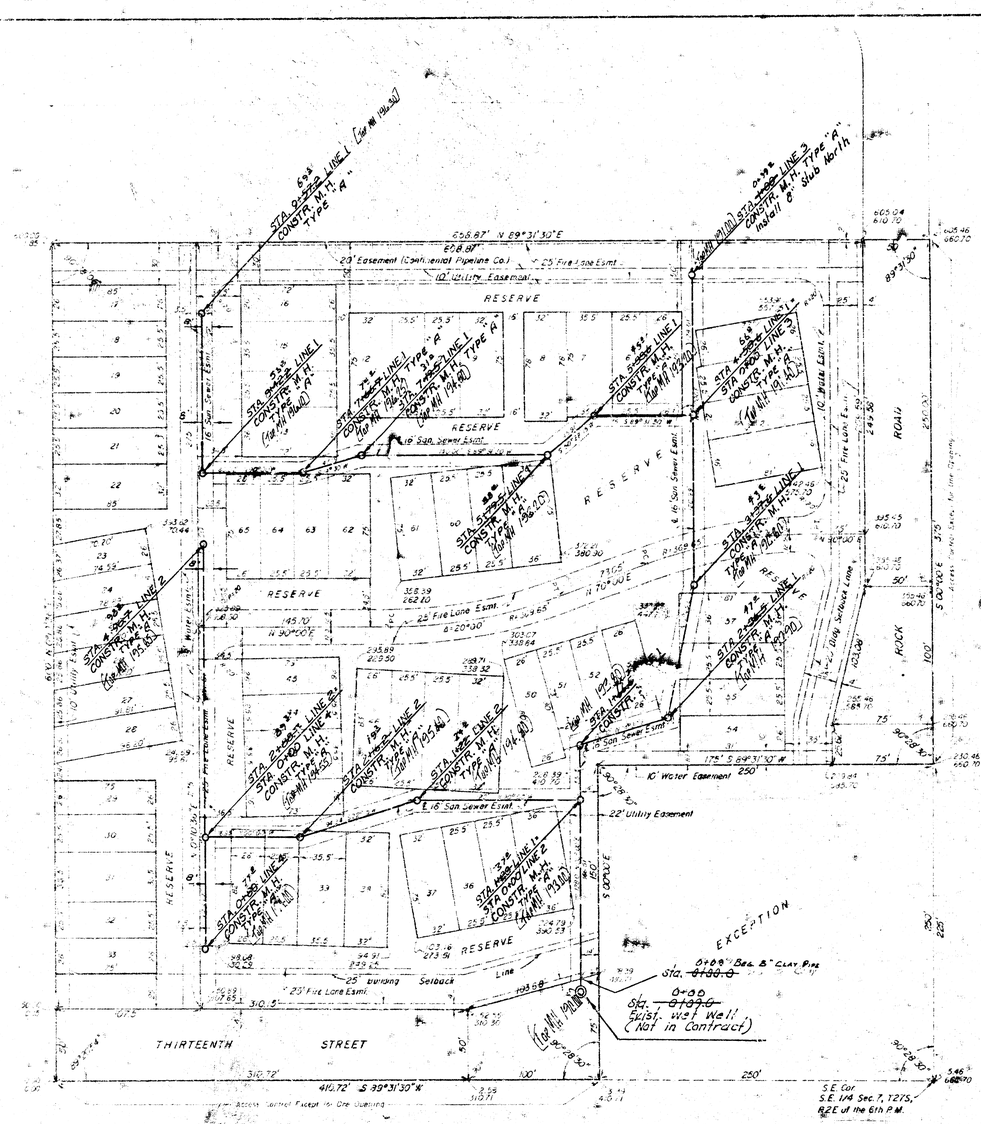


LAT. 94, DRY CREEK MAIN 2, S. S. 12
R. W. LINN CITY ENGINEER
CITY OF WICHITA, KANSAS
PROJ. NO. DBKL 572065
DATE: DEC. 1972

SANITARY SEWER FORCE MAIN
&
PUMPING STATION

SERVING

LEISURE LIVING FIRST ADDITION

WICHITA, KANSAS

MOEHRING & ASSOCIATES

CONSULTING ENGINEERS

WICHITA

1972

INDEX

SHEET NO.	DESCRIPTION
2	PLAN & PROFILE
3	STREET CROSSING & MISC. DETAILS
4	SEWAGE PUMPING STATION

SANITARY SEWER FORCE MAIN
&
PUMPING STATION

SERVING


LEISURE LIVING FIRST ADDITION
WICHITA, KANSAS


MOEHRING & ASSOCIATES
CONSULTING ENGINEERS
WICHITA

1972


INDEX

SHEET NO.	DESCRIPTION
2	PLAN & PROFILE
3	STREET CROSSING & MISC. DETAILS
4	SEWAGE PUMPING STATION

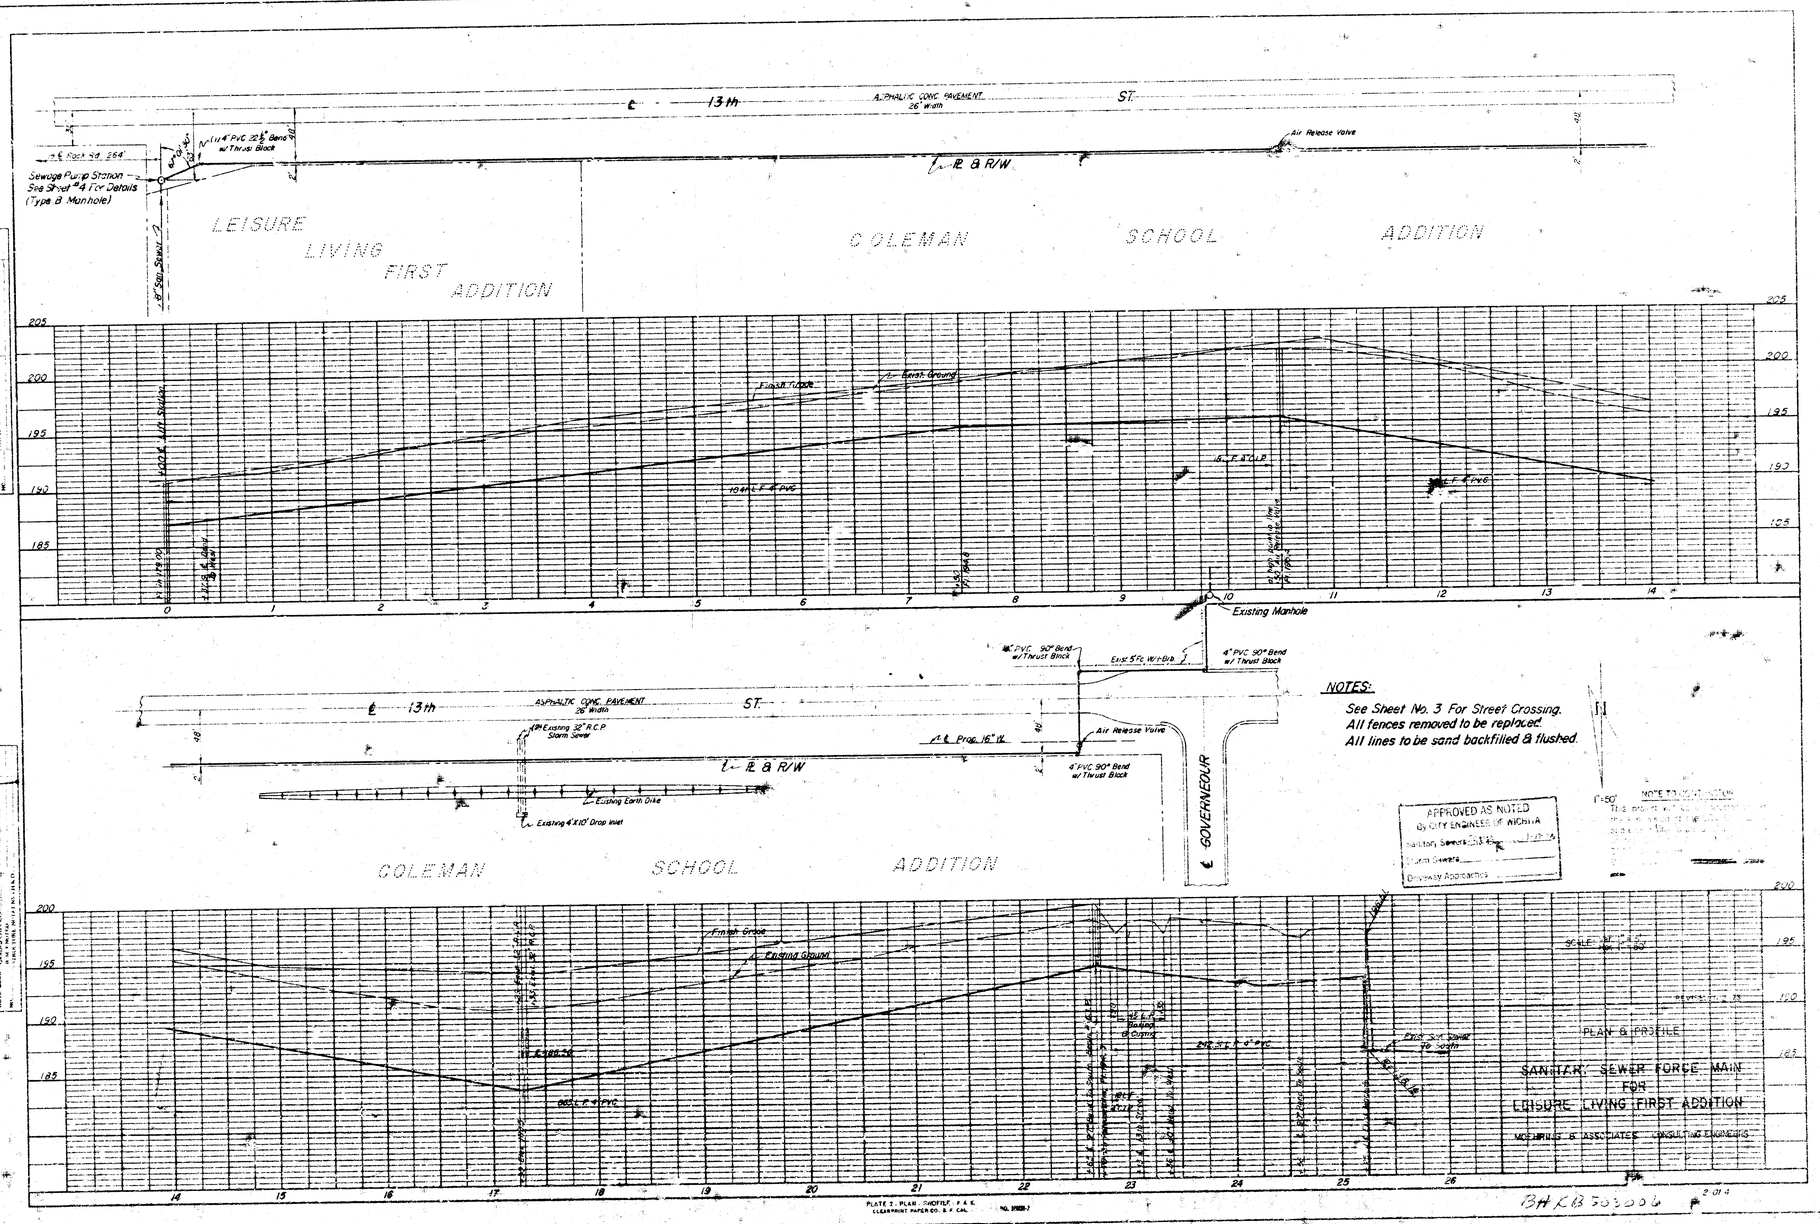

℄ 13th
ASPHALTIC CONC. PAVEMENT 26' Width
ST.
℄ R & R/W
Air Release Valve
Sewage Pump Station See Sheet #4 for Details (Type B Manhole)
LEISURE LIVING FIRST ADDITION
COLEMAN SCHOOL ADDITION
Existing Manhole
4" PVC 90° Bend w/ Thrust Block
Exist 5'ø Manhole
NOTES:
See Sheet No. 3 For Street Crossing.
All fences removed to be replaced.
All lines to be sand backfilled & flushed.
GOVERNEUR
Existing Earth Dike
Existing 4'X10' Drop Inlet
Finish Grade
Existing Ground
APPROVED AS NOTED
BY CITY ENGINEER OF WICHITA
Sanitary Sewers
Storm Sewers
Driveway Approaches
PLAN & PROFILE
SANITARY SEWER FORCE MAIN
FOR
LEISURE LIVING FIRST ADDITION
MOEHRING & ASSOCIATES CONSULTING ENGINEERS

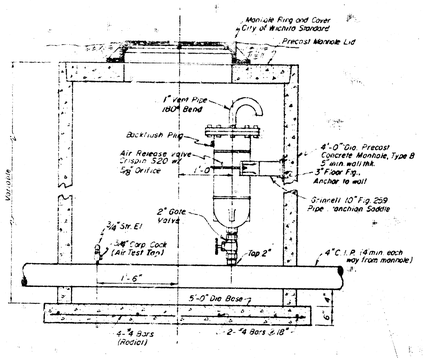

AIR RELEASE VALVE MANHOLE
2 REQ'D.

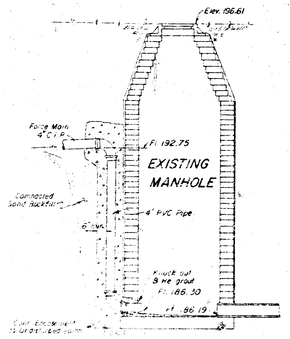

OUTSIDE DROP DETAIL
AT EXISTING MANHOLE

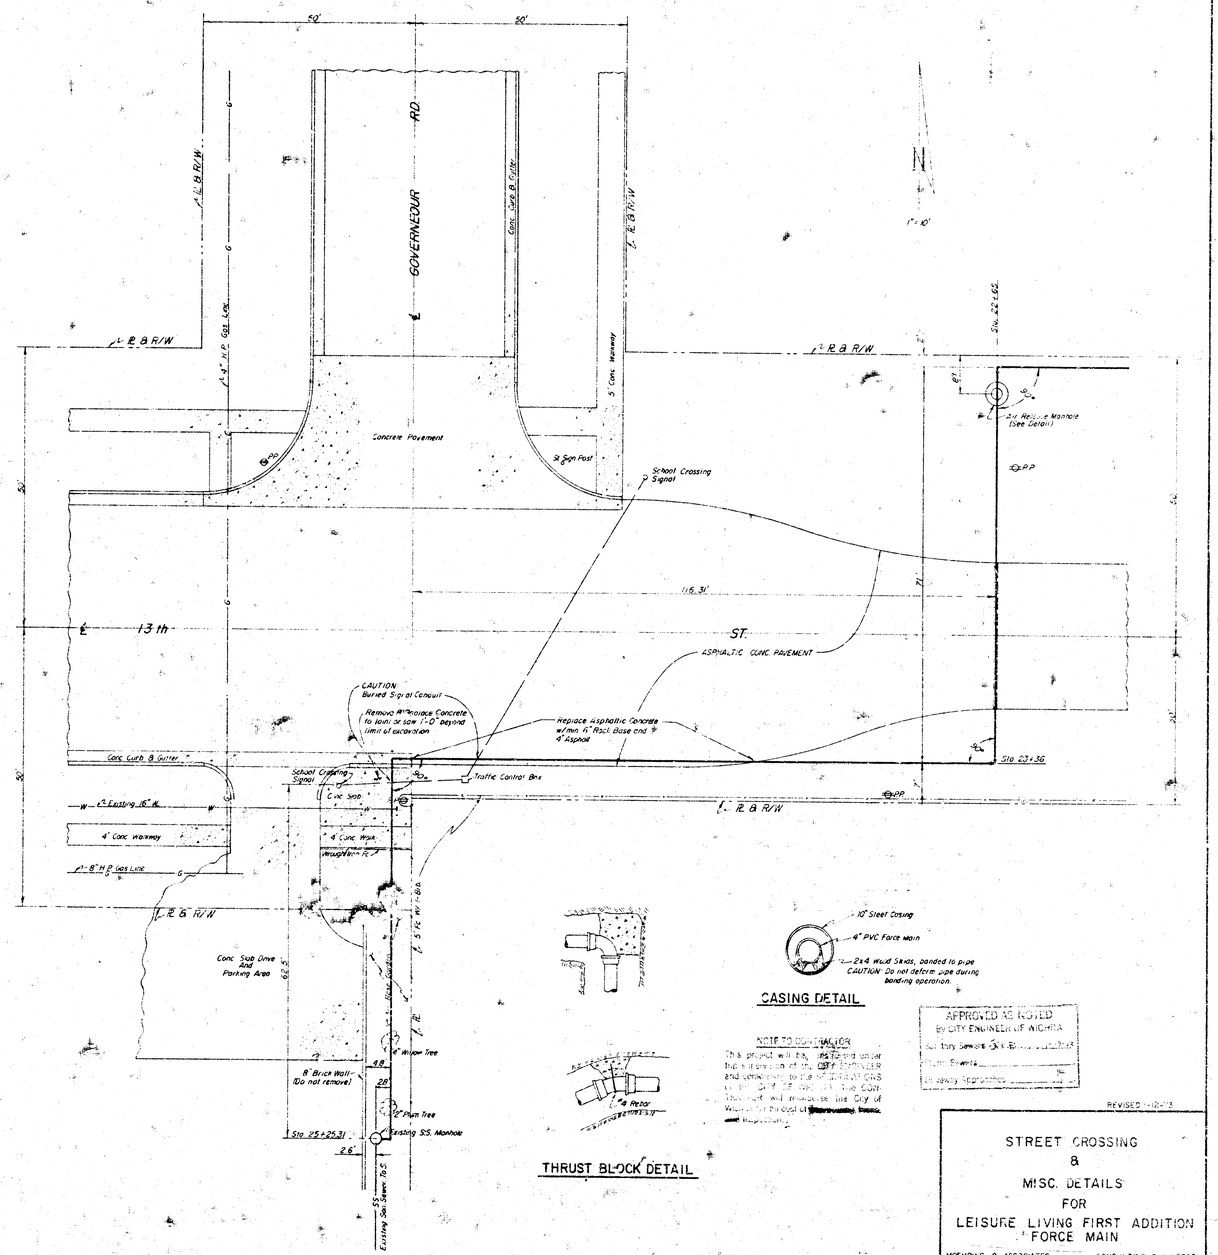

THRUST BLOCK DETAIL

CASING DETAIL

NOTE TO CONTRACTOR



APPROVED AS NOTED
by CITY ENGINEER OF WICHITA
Sanitary Sewers
Storm Sewers
Roadway Appurtenances

REVISED 11-12-73


STREET CROSSING
&
MISC. DETAILS
FOR
LEISURE LIVING FIRST ADDITION
FORCE MAIN

MOEHRING & ASSOCIATES CONSULTING ENGINEERS


5 OF 6

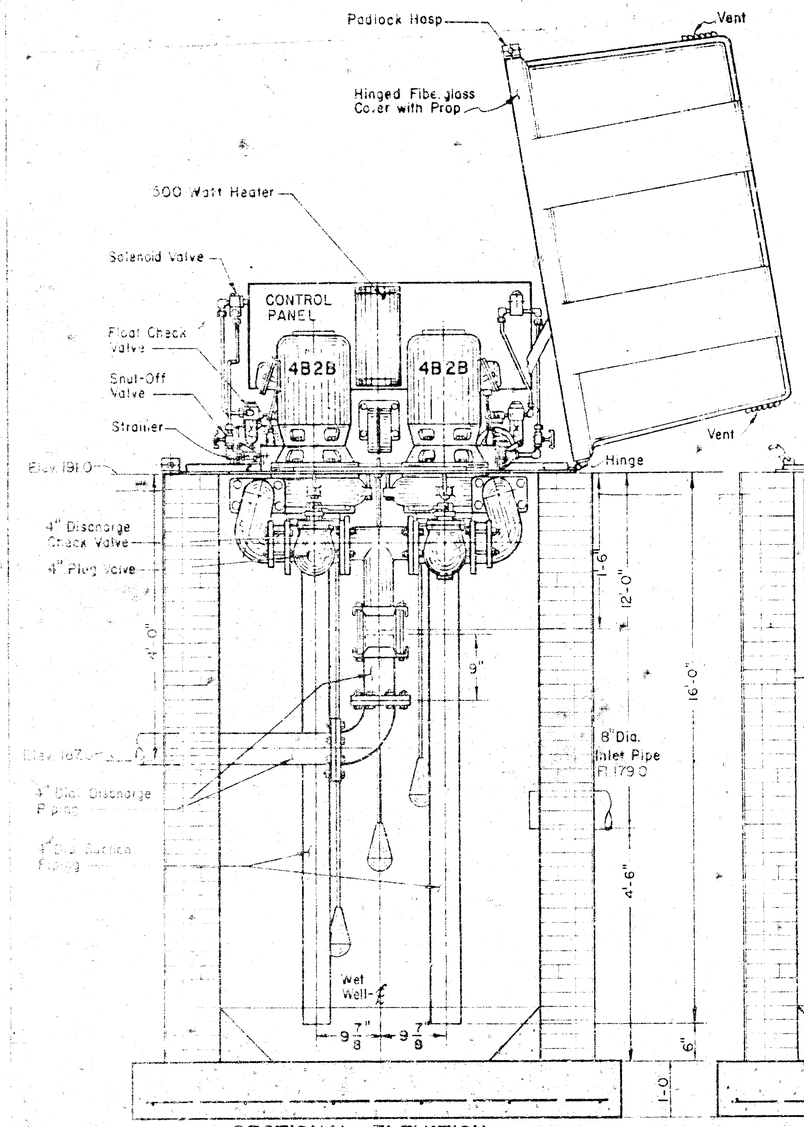

SECTIONAL ELEVATION

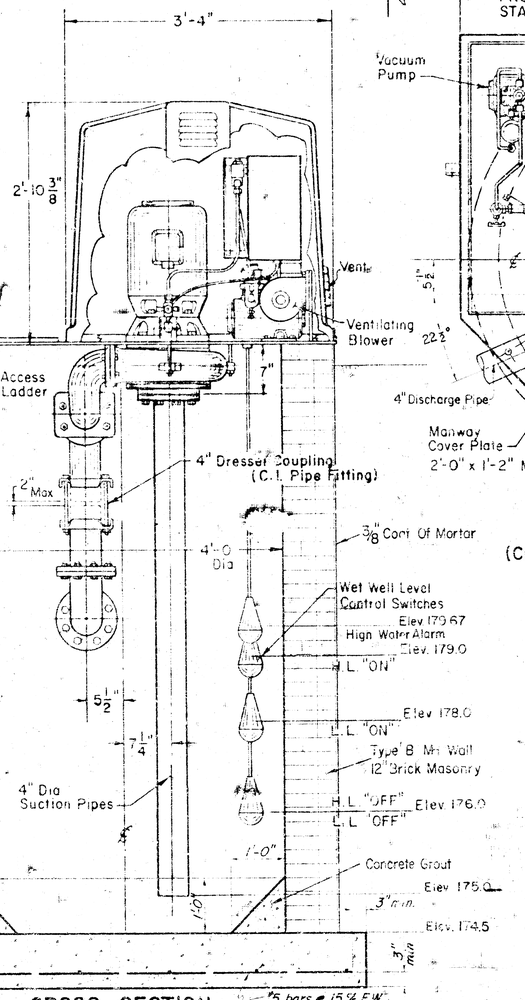

CROSS SECTION

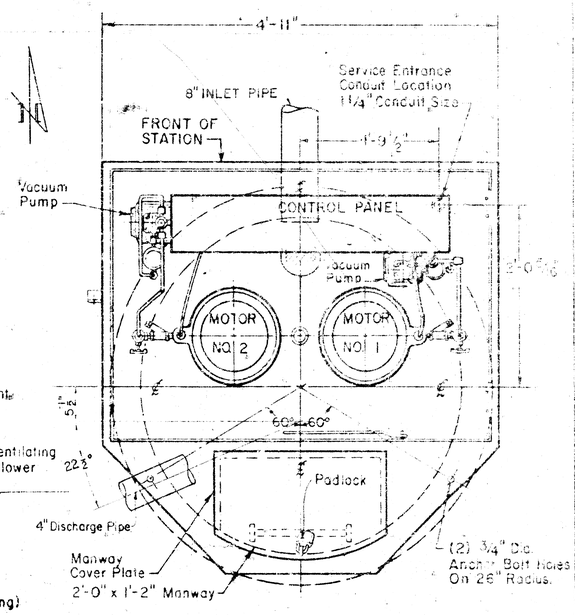

PLAN VIEW
MACHINERY CHAMBER
(COVER DELETED FOR CLARITY)

NOTE: Manhole To Be Type "B" Construction Without Tapered Section

Lift Station to be furnished with Power Failure & High Water Alarm, to be connected to City of Wanna Alarm System.

Construct 2'-0" conc. walk around Manhole.

NOT TO SCALE

WET WELL MOUNTED SEWAGE PUMPING STATION FOR LEISURE LIVING FIRST ADDITION

MOORING & ASSOCIATES CONSULTING ENGINEERS