



NOTE TO CONTRACTOR:
The developer, is to establish top of manhole elevations even if top of manhole elevations are shown.
Sta. 0+00.0 Exist. M. H.
Conc. Dr. Iron
Barb Wire Angle
Street Light
Barricade 13-5ft. posts
4" high
"+" Cut by others
Barb wire fence cor.
NOTE:
Replace drive and pavement.
Take ties to cross on pavement.
Conc. drive
Exist. Pavement
MURDOCK
AVE.
KAPRUN
SECOND
ADDITION
12' Perm. Easement
20' util. and Drainage Easement
LINE NO. 1
(Private Drive, Drainage and Utility Easement, Fire Lane)
Barb Wire fence
Sta. 2+47.0 Const. Std. M.H. Type "A"
Sta. 3+52.0 Const. Std. M.H. Type "A" Sta. 0+00.0 Line No. 2 So.
Sta. 4+39.5 Const. Std. M.H. Type "A" Sta. 0+00.0 Line No. 3 So.
Sta. 6+68.5 Const. Std. M.H. Type "A" Sta. 0+00.0 Line No. 4 So.
Sta. 8+68.5 Const. Std. M.H. Type "A" Sta. 0+00.0 Line No. 5 So.
Sta. 10+74.5 Const. Std. M.H. Type "A" Sta. 0+00.0 Line No. 6 So.
Sta. 12+36.5 Const. Std. M.H. Type "A" Sta. 0+00.0 Line No. 7 So.
Plan Scale 1" = 40'
Profile Scale 1" = 40' Horz. 1" = 5' Vert.
B. M. 181.33 So. Rim of M.H. 14' S. of 0+00.0 Line No. 1 — This M.H. is 680' W. of M.H. shown on Addn. Plat
B. M. 189.42 SE cor. conc. porch 6002 Murdock.
B. M. 194.42 "+" top N-ob Murdock 12' W. of W.L. Marjorie NW cor. Murdock - Marjorie.
B. M. 201.18 SE cor. bot. conc. step 6302 Murdock.
Sta. 0+00.0 Exist. M.H.
185.54 S. Rim M.H.
Sta. 2+47.0 Const. Std. M.H. Type "A"
Sta. 3+52.0 Const. Std. M.H. Type "A" Sta. 0+02.0 Line No. 2
Sta. 4+60.5 Const. M.H. Type "A" Sta. 0+00.0 Line No. 3
Sta. 6+68.5 Const. M.H. Type "A" Sta. 0+00.0 Line No. 4
Sta. 8+68.5 Const. M.H. Type "A" Sta. 0+00.0 Line No. 5
Sta. 10+74.5 Const. M.H. Type "A" Sta. 0+00.0 Line No. 6
Sta. 12+36.5 Const. M.H. Type "A" Sta. 0+00.0 Line No. 7
TR = 184.3
TR = 186.1
TR = 187.3
TR = 190.6
TR = 193.9
TR = 195.9
TR = 197.4
Natural ground
Exist. South cb of Murdock Ave.
177.00 Flo in LINE NO. 2
178.40 Flo in Line No. 3
181.00 Flo in LINE No. 4
184.60 Flo in Line No. 5
186.00 Flo in Line No. 6
184.7 Flo in Line No. 7
184.69 Flo out
247 Lin. ft. of 8" Clay Pipe @ 0.40% grade
989.5 Lin. ft. of 8" Clay Pipe @ 0.90 % grade.
As Built
Final Mens
I-H-84
LAT. 95, DRY CREEK MAIN 2, S. S. NO. 12
CITY OF WICHITA, KANSAS
R. W. LINN — CITY ENGINEER
DEC. 1973 PROJECT NO. DBKL 573054
DONALD E. SCHNEIDER
6311
REGISTERED ENGINEER
KANSAS

B. M. 189.42 SE cor. conc. porch 6002 E. Murdock.

KAPAUN SECOND ADDITION

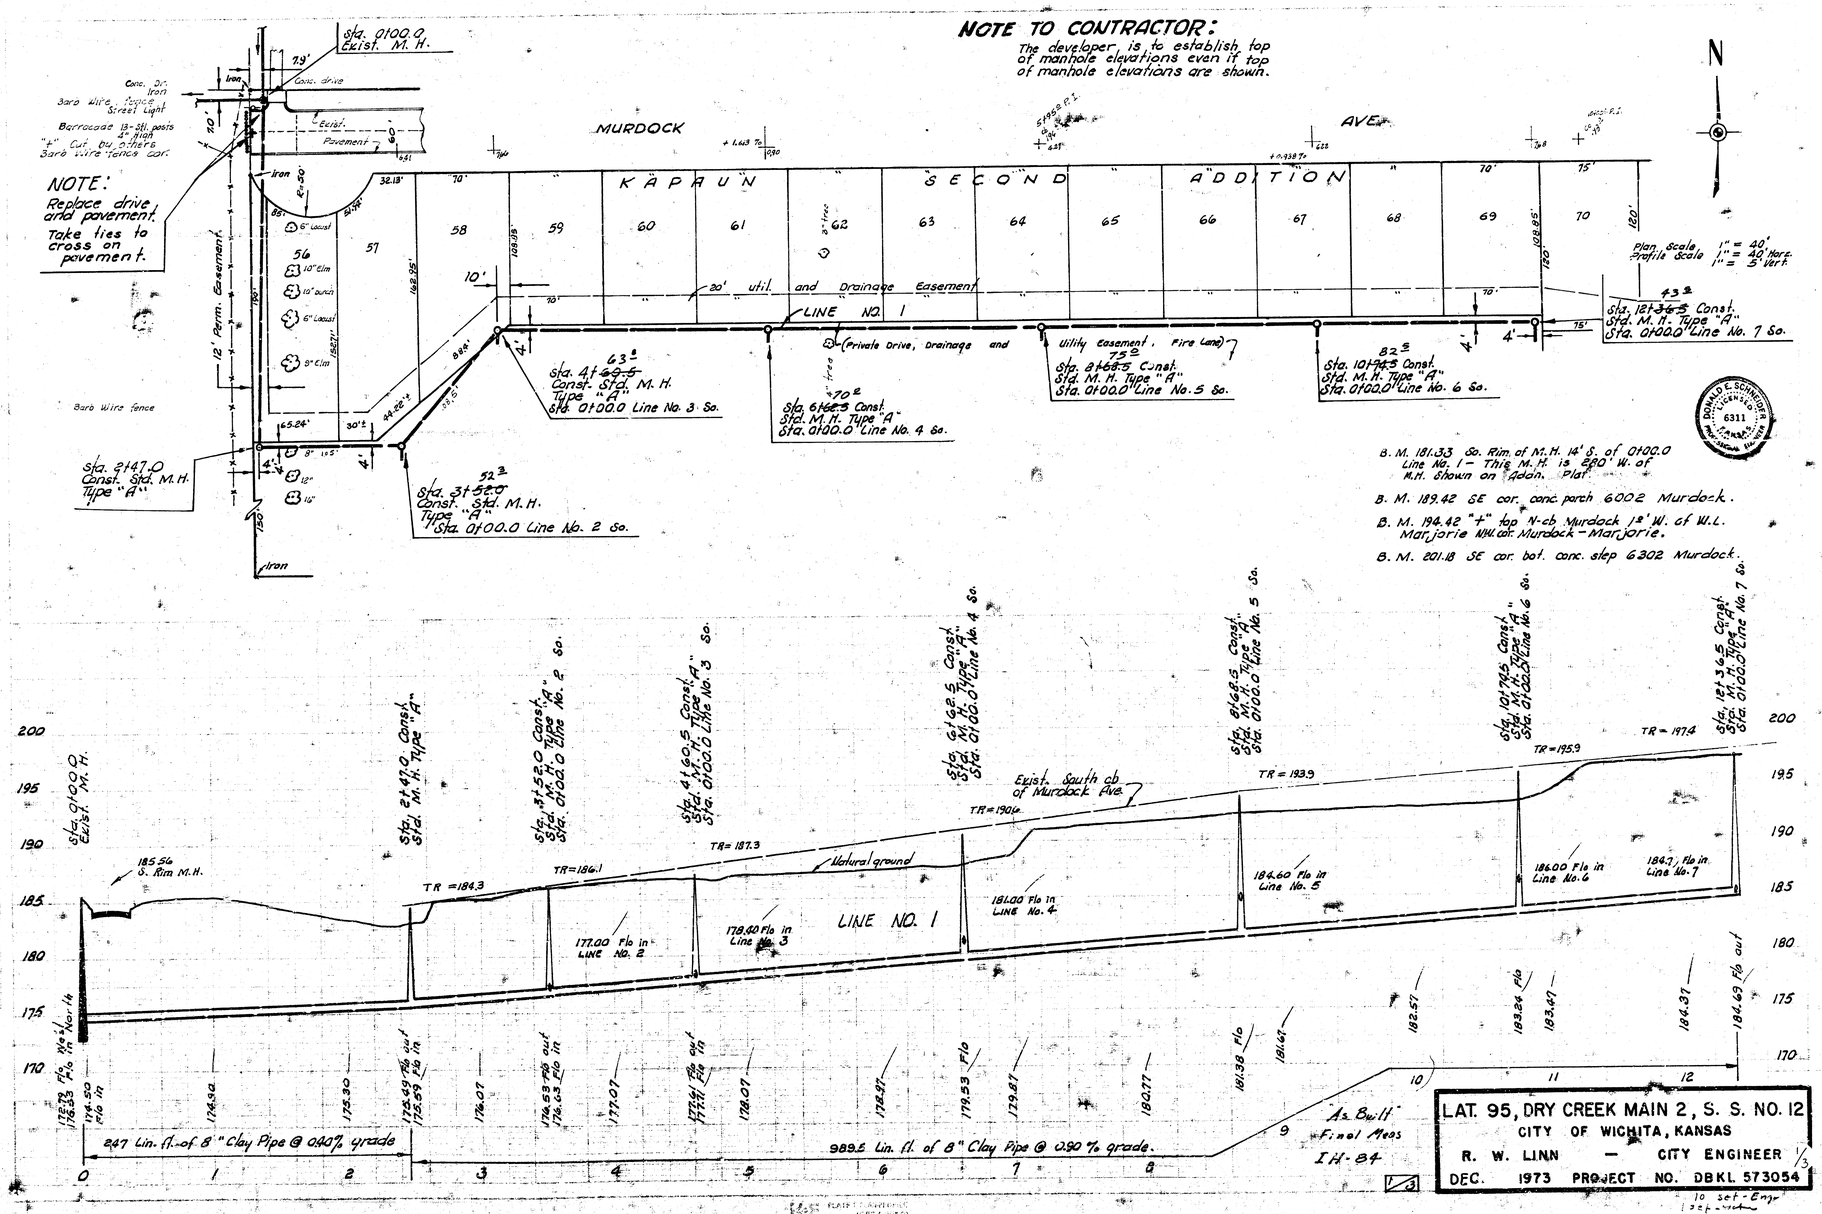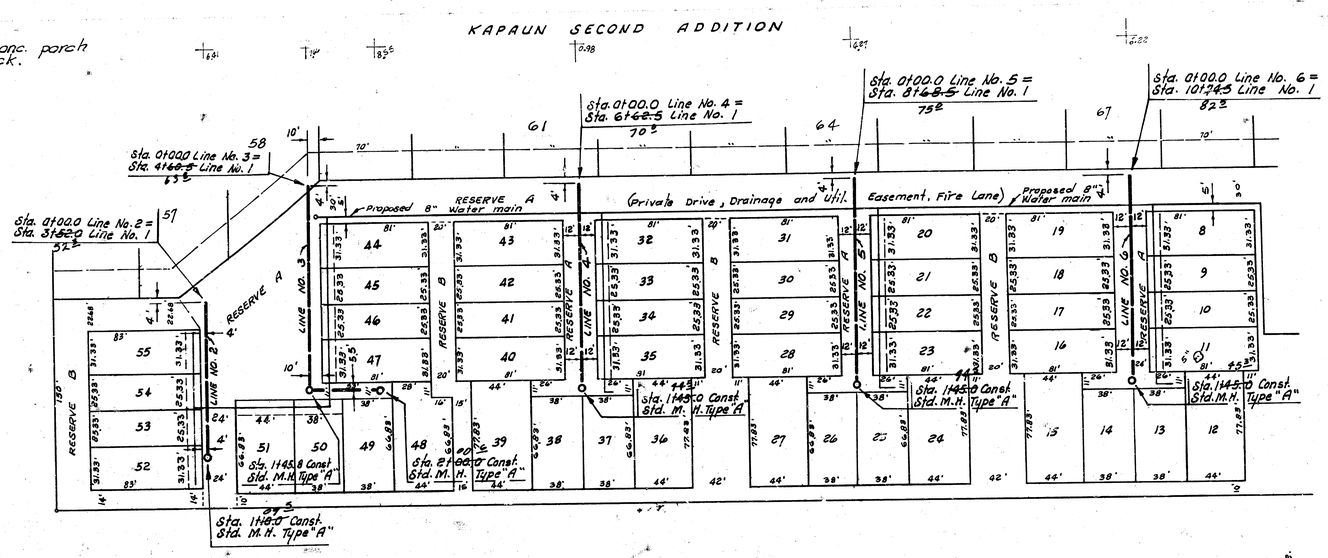


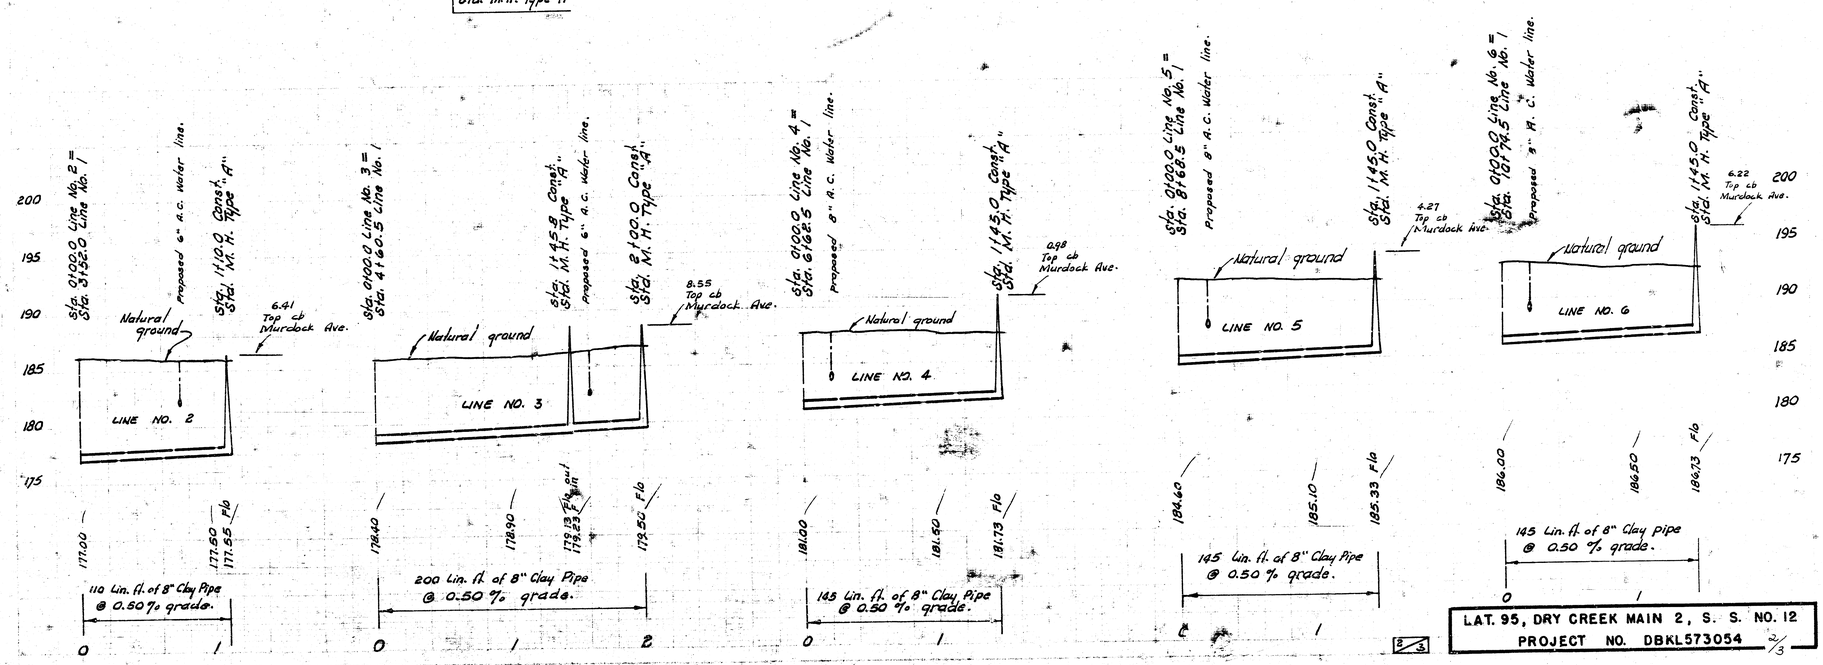



LAT. 95, DRY CREEK MAIN 2, S. S. NO. 12
PROJECT NO. DBKL573054


FILMED FROM THE BEST AVAILABLE COPY

B. M. 201.18 SE cor. bot. Conc. Step
No. # 6302 Murdock.

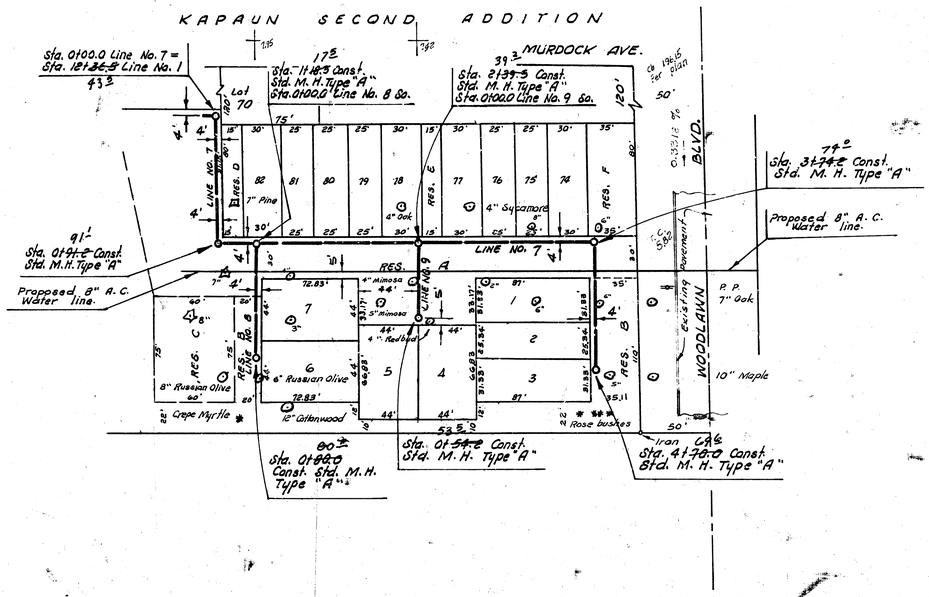

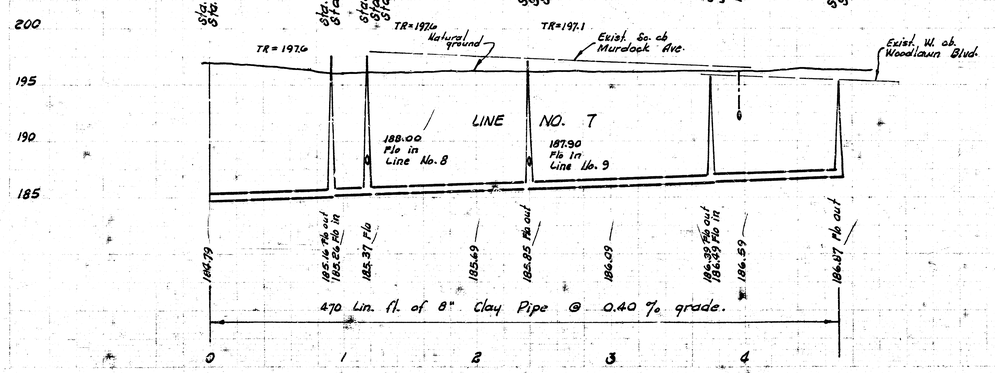

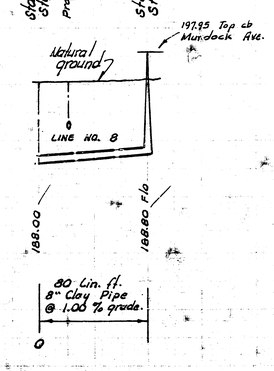

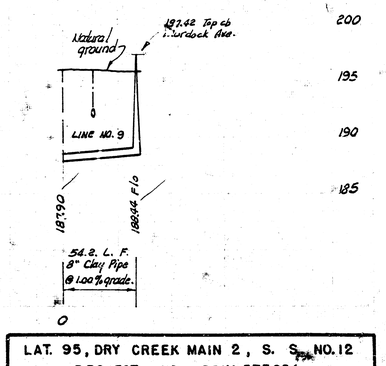

LAT. 95, DRY CREEK MAIN 2, S. S. NO. 12
PROJECT NO. DBKL573054

3/3

FILMED FROM THE BEST AVAILABLE COPY