

~~Sta. 0+60 to Sta. 2+00. Existing pipe is to be carefully uncovered, inspected & then totally encased in concrete. A crack in the pipe at approximately Sta. 1+00 must be removed before encasement. After the pipe is uncovered, the line is to be inspected on approval by the City of Wichita Engineer. If failure of improved line is found, it is to be repaired or replaced and encased as directed.~~


Note: Reuse Existing MH Sta. 0+60.3

From Sta. 4+93.5 to Sta. 7+73.3 (Main) & From Sta. 0+00 (Lat.) to Sta. 2+20 (Lat.)
Remove existing 8" V.C.P. sewer pipe & install new sewer pipe on the same alignment & grade as the old pipe.
Existing brick manholes shall be reused.
Extension of Existing Manholes shall be 30" I.D.
Top 4" Above Existing Grade

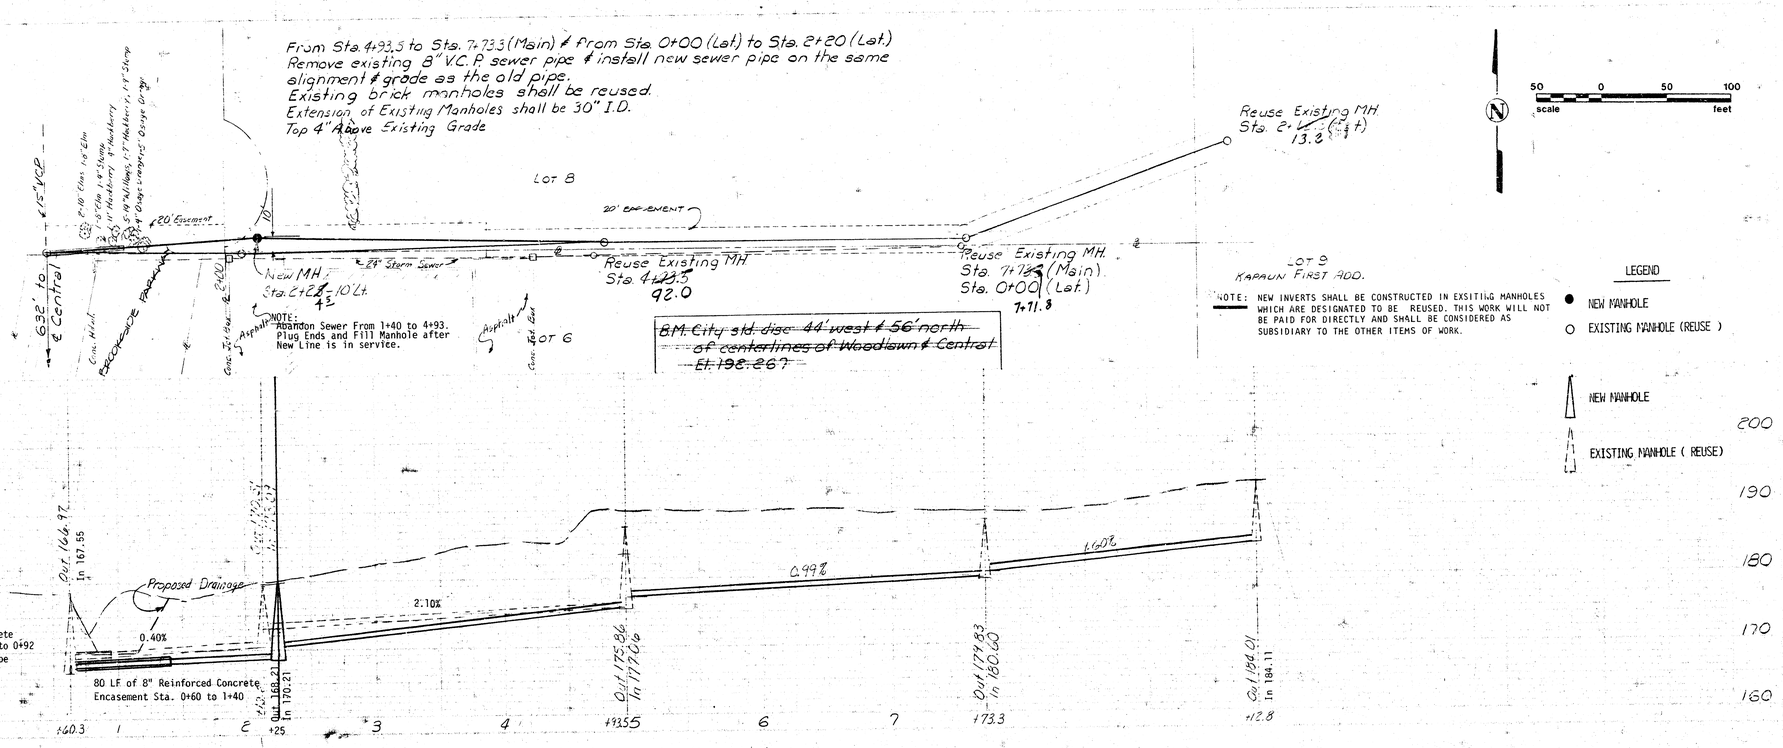

All new construction shall meet City of Wichita standards & specifications.

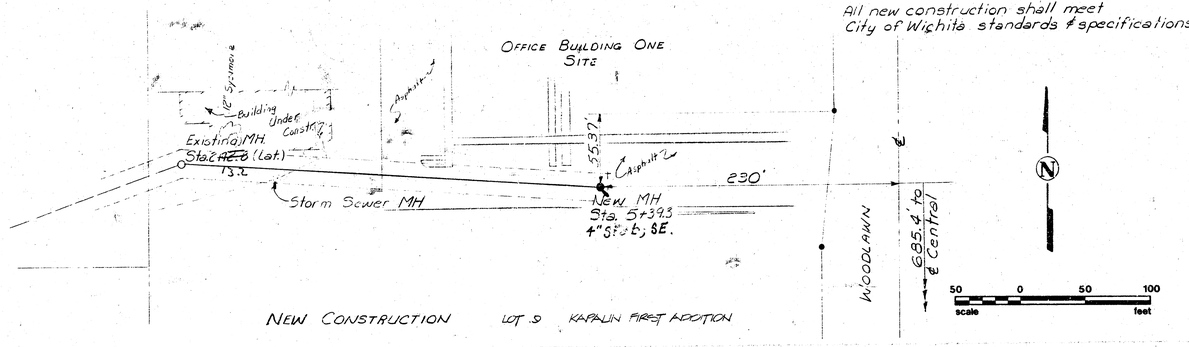

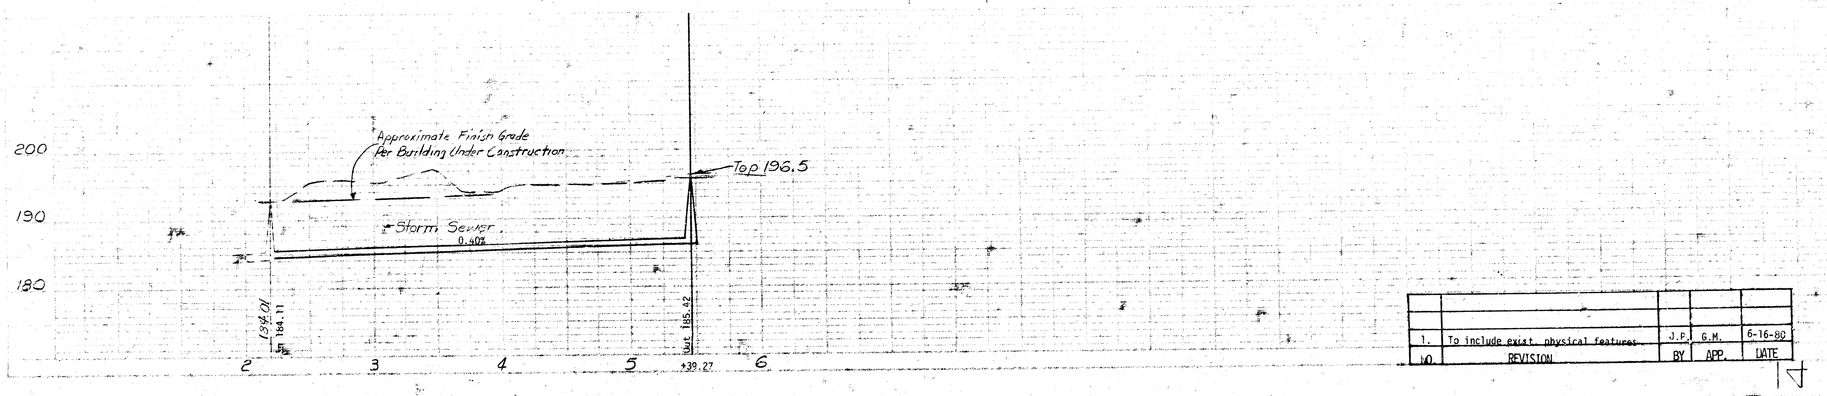

NOTE: The construction of ALL sanitary sewers shall be based Bench Mark-"Brass Plug East End Hubguard RCB N-Side Central & West of Brookside Pky. Elevation 178.54."

12-1-79
APPROVED AS NOTED
CITY ENGINEER
Sanitary Sewers
Storm Sewers
Drainage Requirements

NOTE TO CONTRACTOR
This project will be constructed under the supervision of the CITY ENGINEER and conforms to the CODES of the CITY OF WICHITA, KANSAS

NOTE: NEW INVERTS SHALL BE CONSTRUCTED IN EXSITING MANHOLES WHICH ARE DESIGNATED TO BE REUSED. THIS WORK WILL NOT BE PAID FOR DIRECTLY AND SHALL BE CONSIDERED AS SUBSIDIARY TO THE OTHER ITEMS OF WORK.

LEGEND
- NEW MANHOLE
- EXISTING MANHOLE (REUSE)
- NEW MANHOLE
- EXISTING MANHOLE (REUSE)

NO.	REVISION	BY	APP.	DATE
1.	To include exist. physical features	J.P.	G.M.	6-16-80

C5-16
As built
11/5/81 J.P.

GARY R. MEZGER LICENCED 7489 KANSAS PROFESSIONAL ENGINEER

ALT. 104, DRY CREEK MAIN 2.5S12
CITY OF WICHITA , KANSAS
468-76-245-80899-000-000-001
DEAN SELLERS, ACTING CITY ENGINEER

9-27-79
REV. 10-30-79

1 1/1