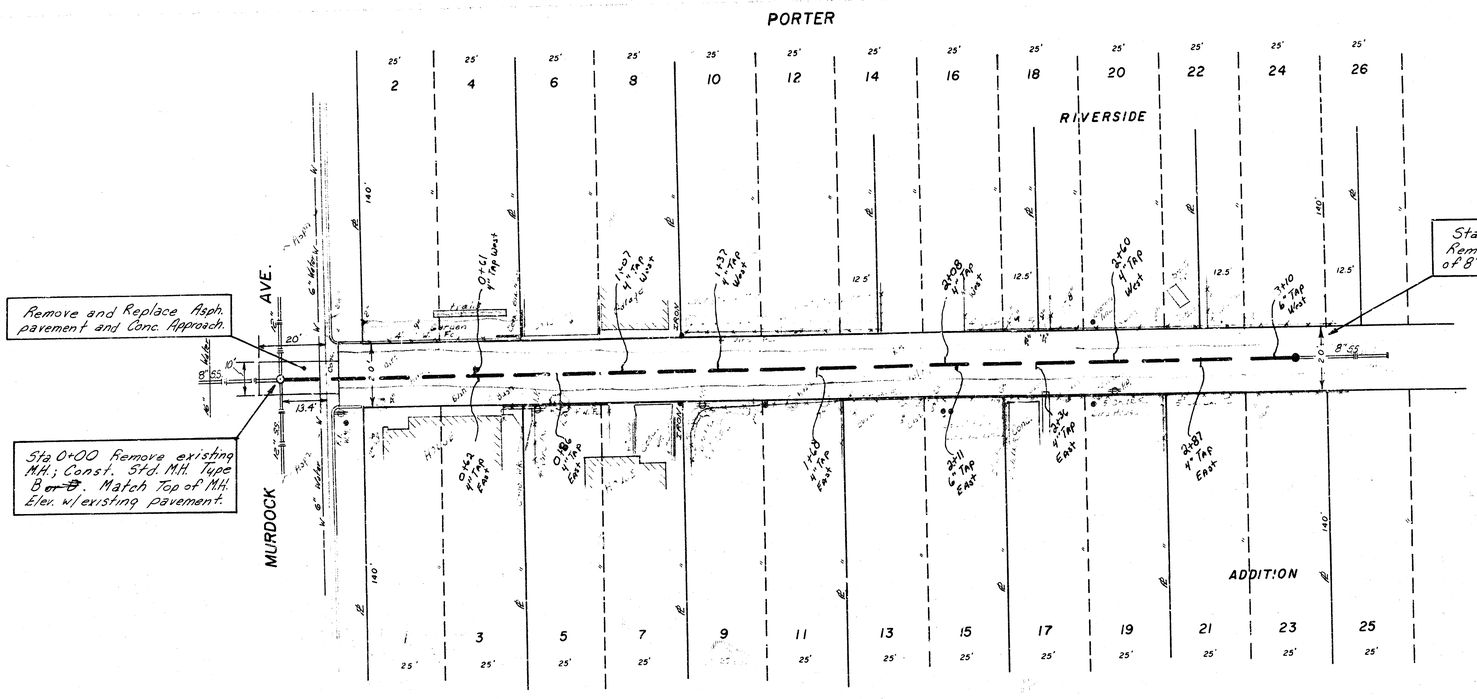

Notify Central Inspection (268-4341) for Service Connection Permits

Stationing for Service Connections As Booked (B-218)

Note: Notify Property Owners 48 hrs before construction begins.

N

SCALE 1" = 20' Plan
Horz 1" = 20'
Vert 1" = 5' Profile

Bench Marks - 115.61 Brass Rod in conc. post, 27' W. and 22.5' N. of ℄ Buffum and Franklin

120.19 RR. Spk., W. Fc. PP., E. Side of Alley between Porter and Lichfield, 4th PP N. Side Murdock

117.03 RR. Spk., W. Fc. PP., E. Side Alley between Porter and Lichfield, 1st PP N. Side Murdock

As Built
J.L.L.
5/82

DONALD E. SCHNEIDER
LICENSED
6311
KANSAS
PROFESSIONAL ENGINEER

RECONSTUCTION OF A PORTION OF S.S. NO. 15, BETWEEN PORTER & LITCHFIELD ON N.S. OF MURDOCK.

CITY OF WICHITA, KANSAS
R.W. BRUGGEMAN
DIRECTOR OF ENGINEERING / CITY ENGINEER
PROJ. NO. 468-76-245-81167-000-000-001
DATE _____ SHEET 1 OF 1